

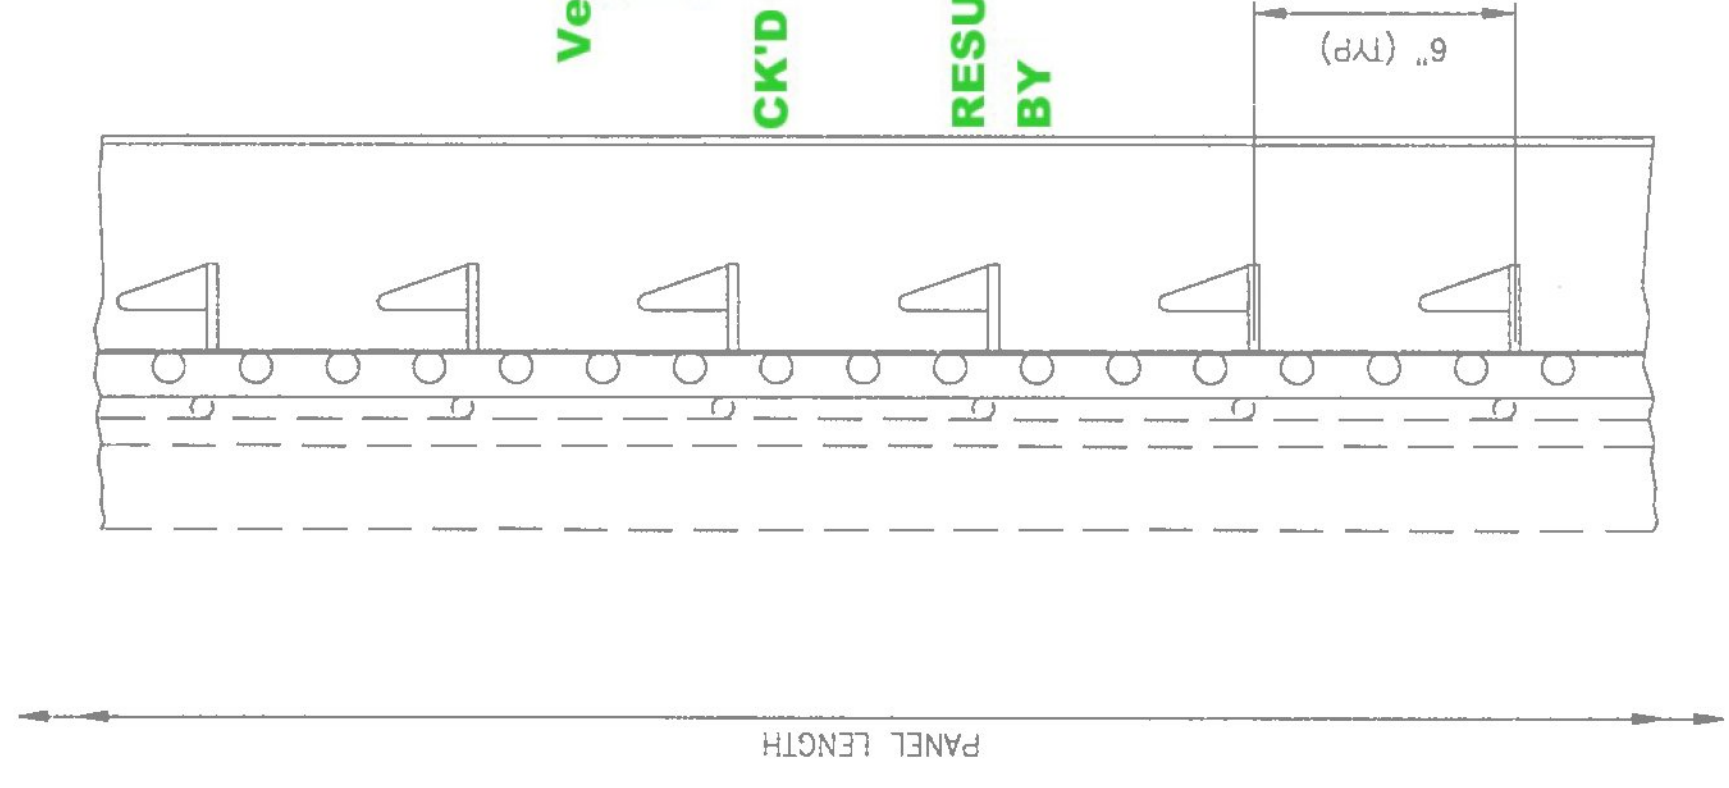



STANDARD PANEL TOLERANCES	
PANEL WIDTH	+0 -1/8"
PANEL LENGTH	±1/4"
SQUARENESS	±1/2"
TRANSVERSE CAMBER (WIDTH)	.004 x WIDTH (IN)
LONGITUDINAL CAMBER (LENGTH)	.003 x LENGTH (IN)
SIDE BOW (SWEEP)	.025 x LENGTH (IN)
MAIN BAR VERTICALITY	.04xH (FULL BAR H)
CROSS BAR VERTICALITY	.04xH (FULL BAR H)
BAR SPACING	±1/8" C-C

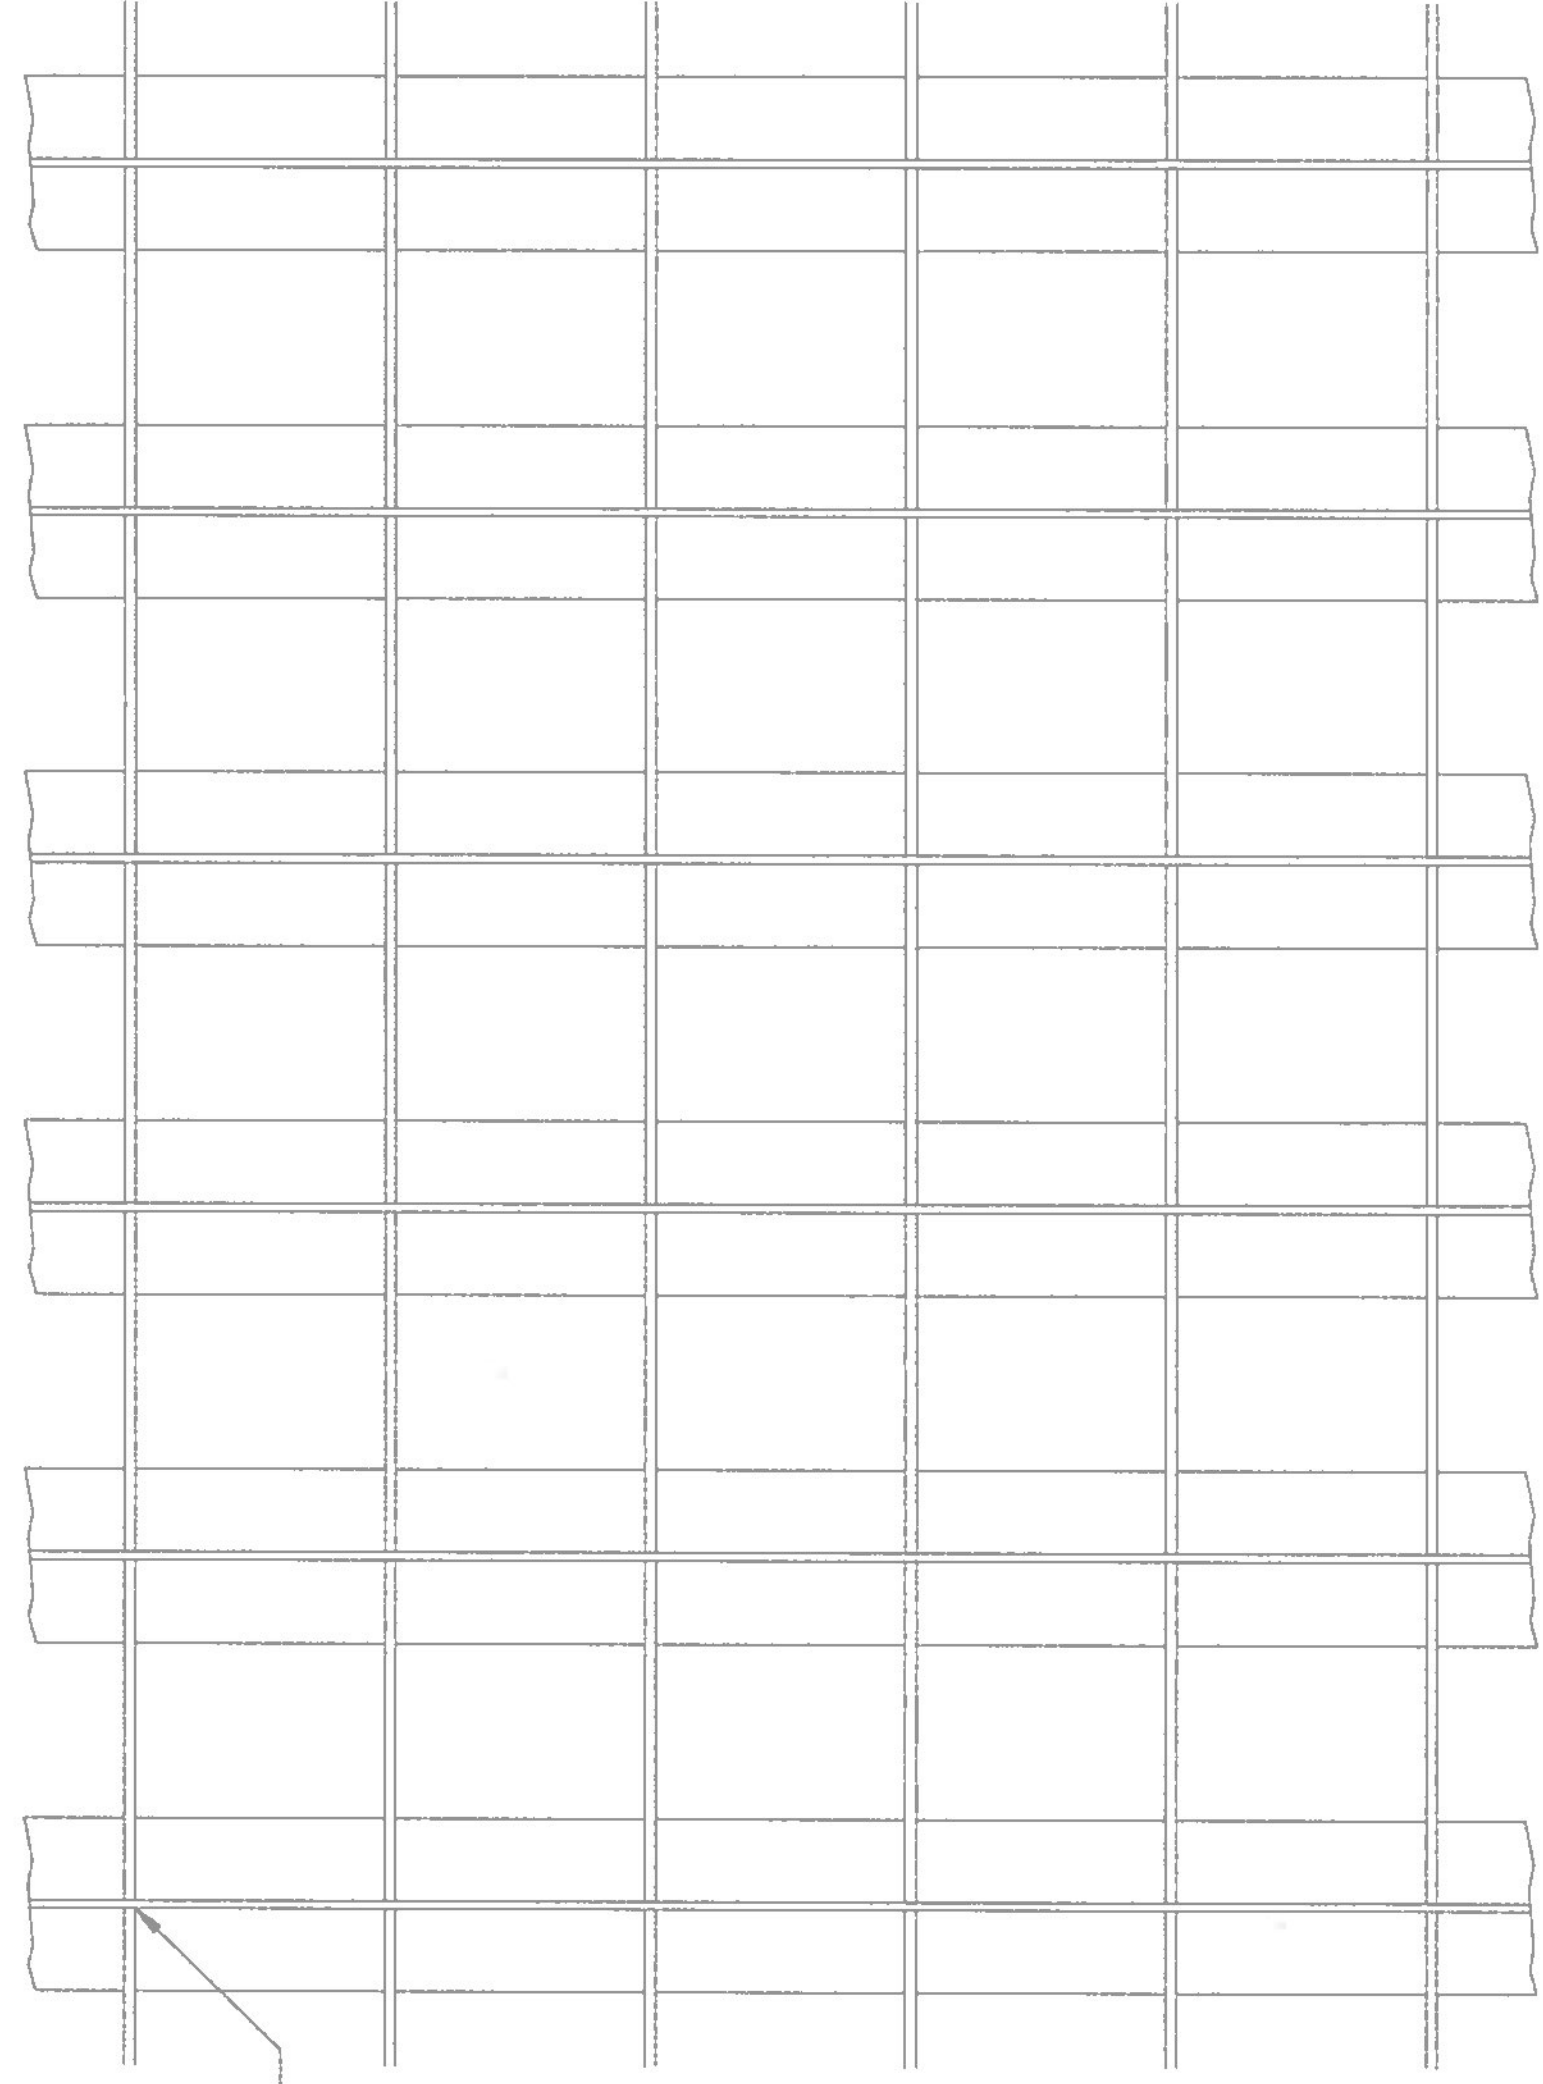

Vermont Agency of Transportation
RECEIVED
 CK'D BY TCF OK
 8:50 am, Mar 20 2013
 RESUBMIT APR 11 2013
 BY KMH DA

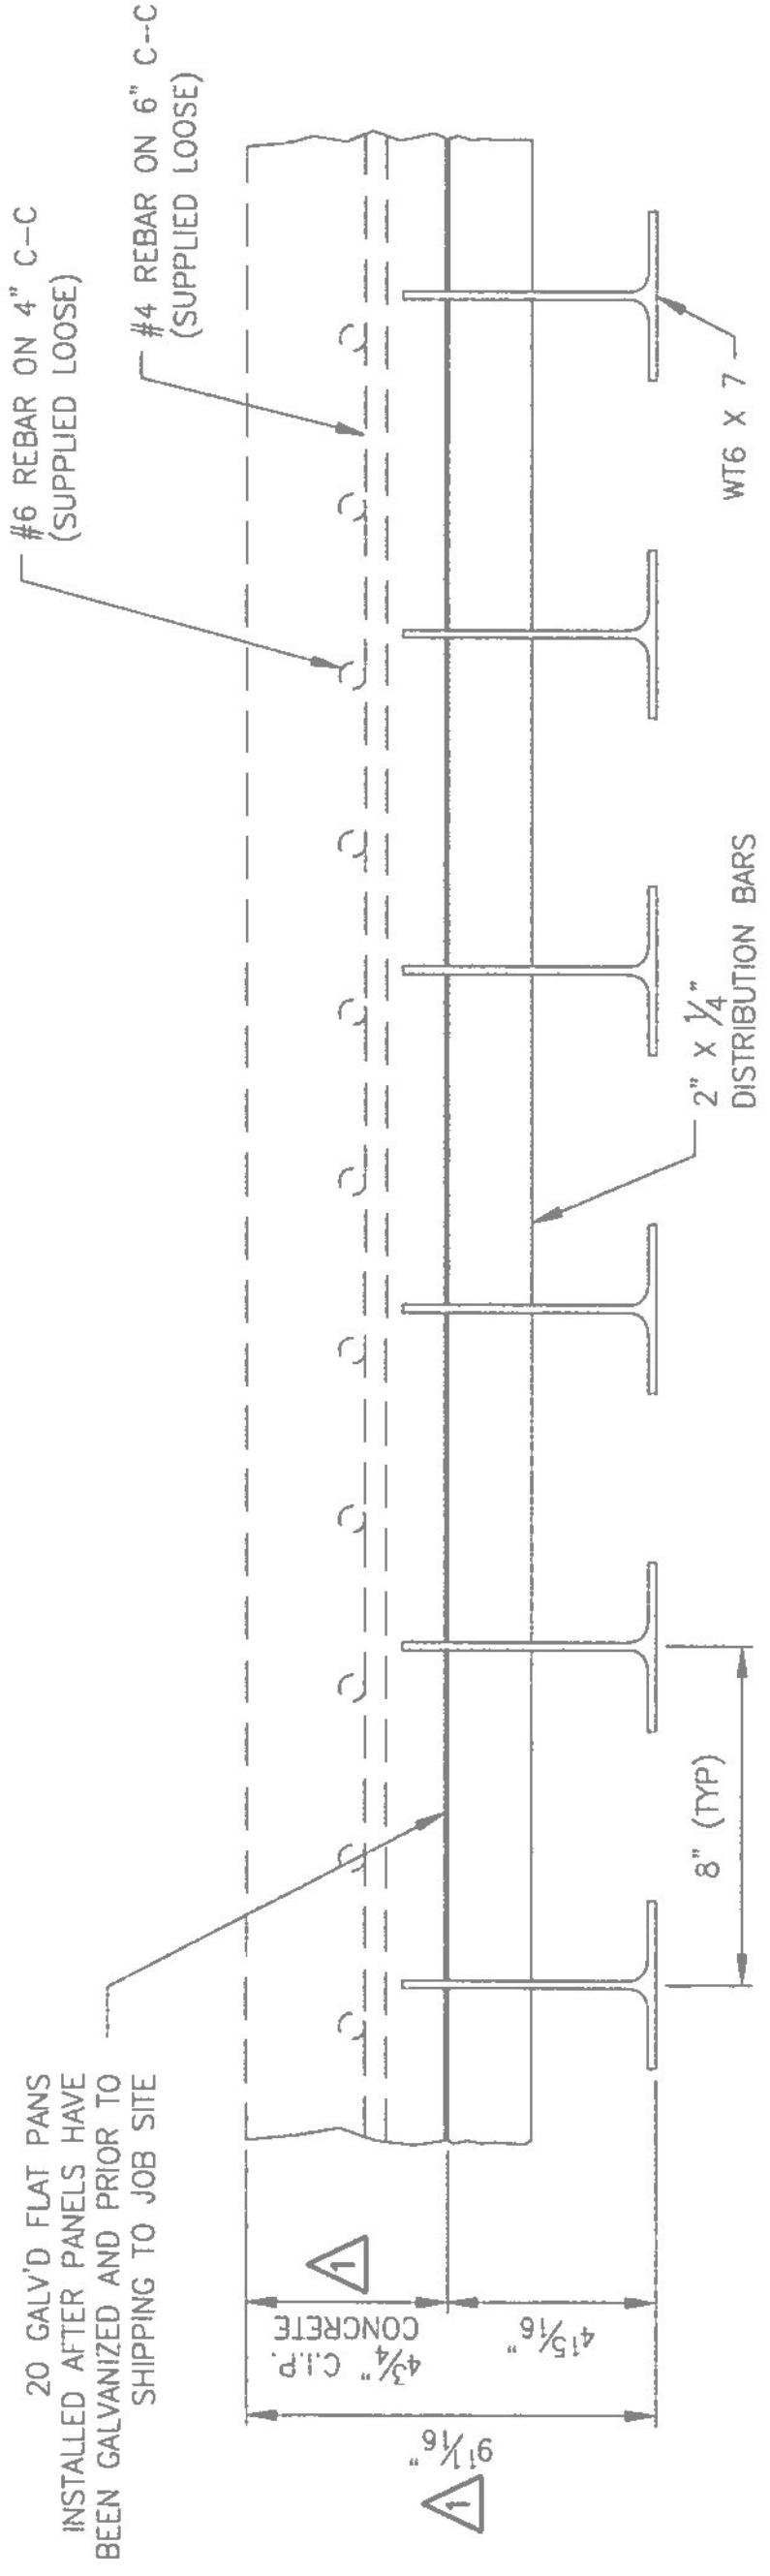

TYPICAL FLOORING DETAILS

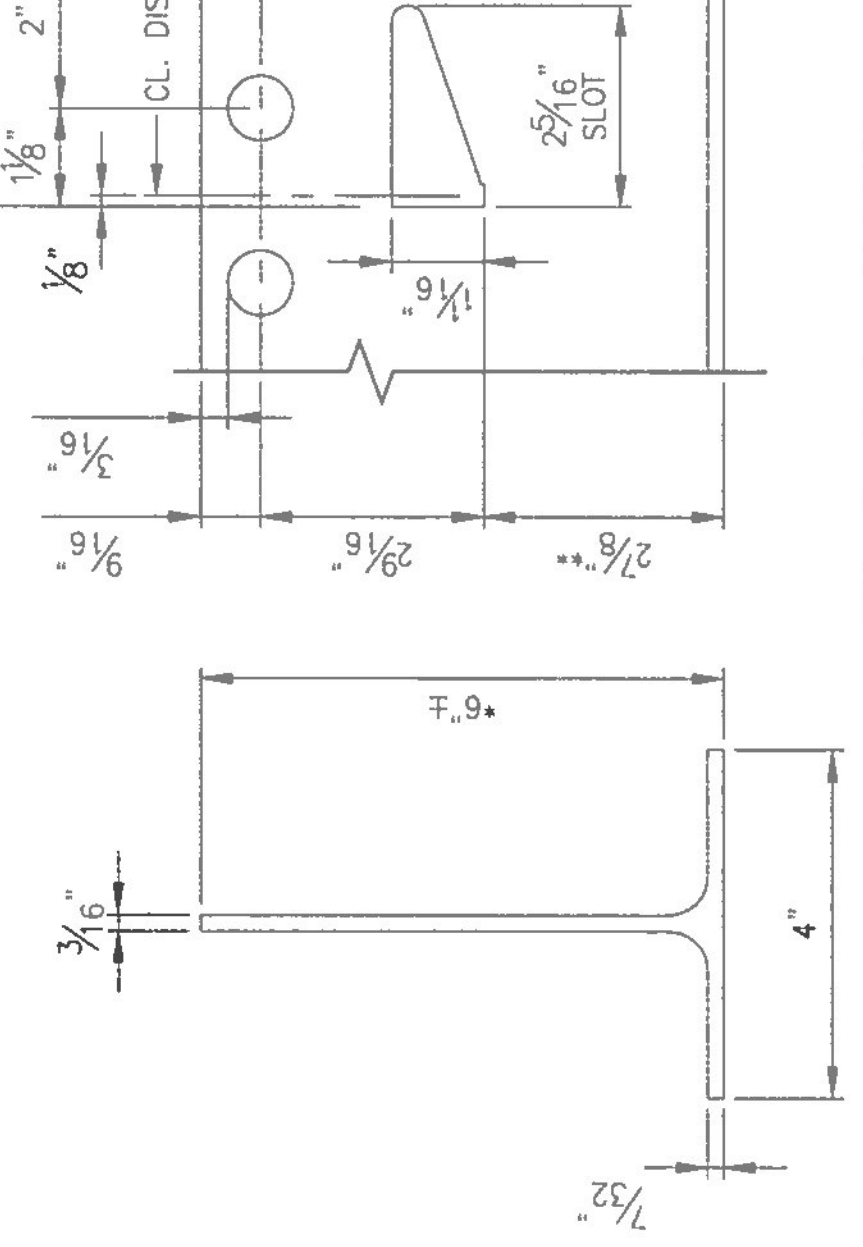

WT 6 X 7 DETAIL

*DUE TO MILL TOLERANCES, THE WT6 X 7 MAY VARY IN HEIGHT.
 **THE 2 7/8\"/>