


19'-0" (C TO C OF TRUSSES)

17'-8" (FASCIA TO FASCIA)

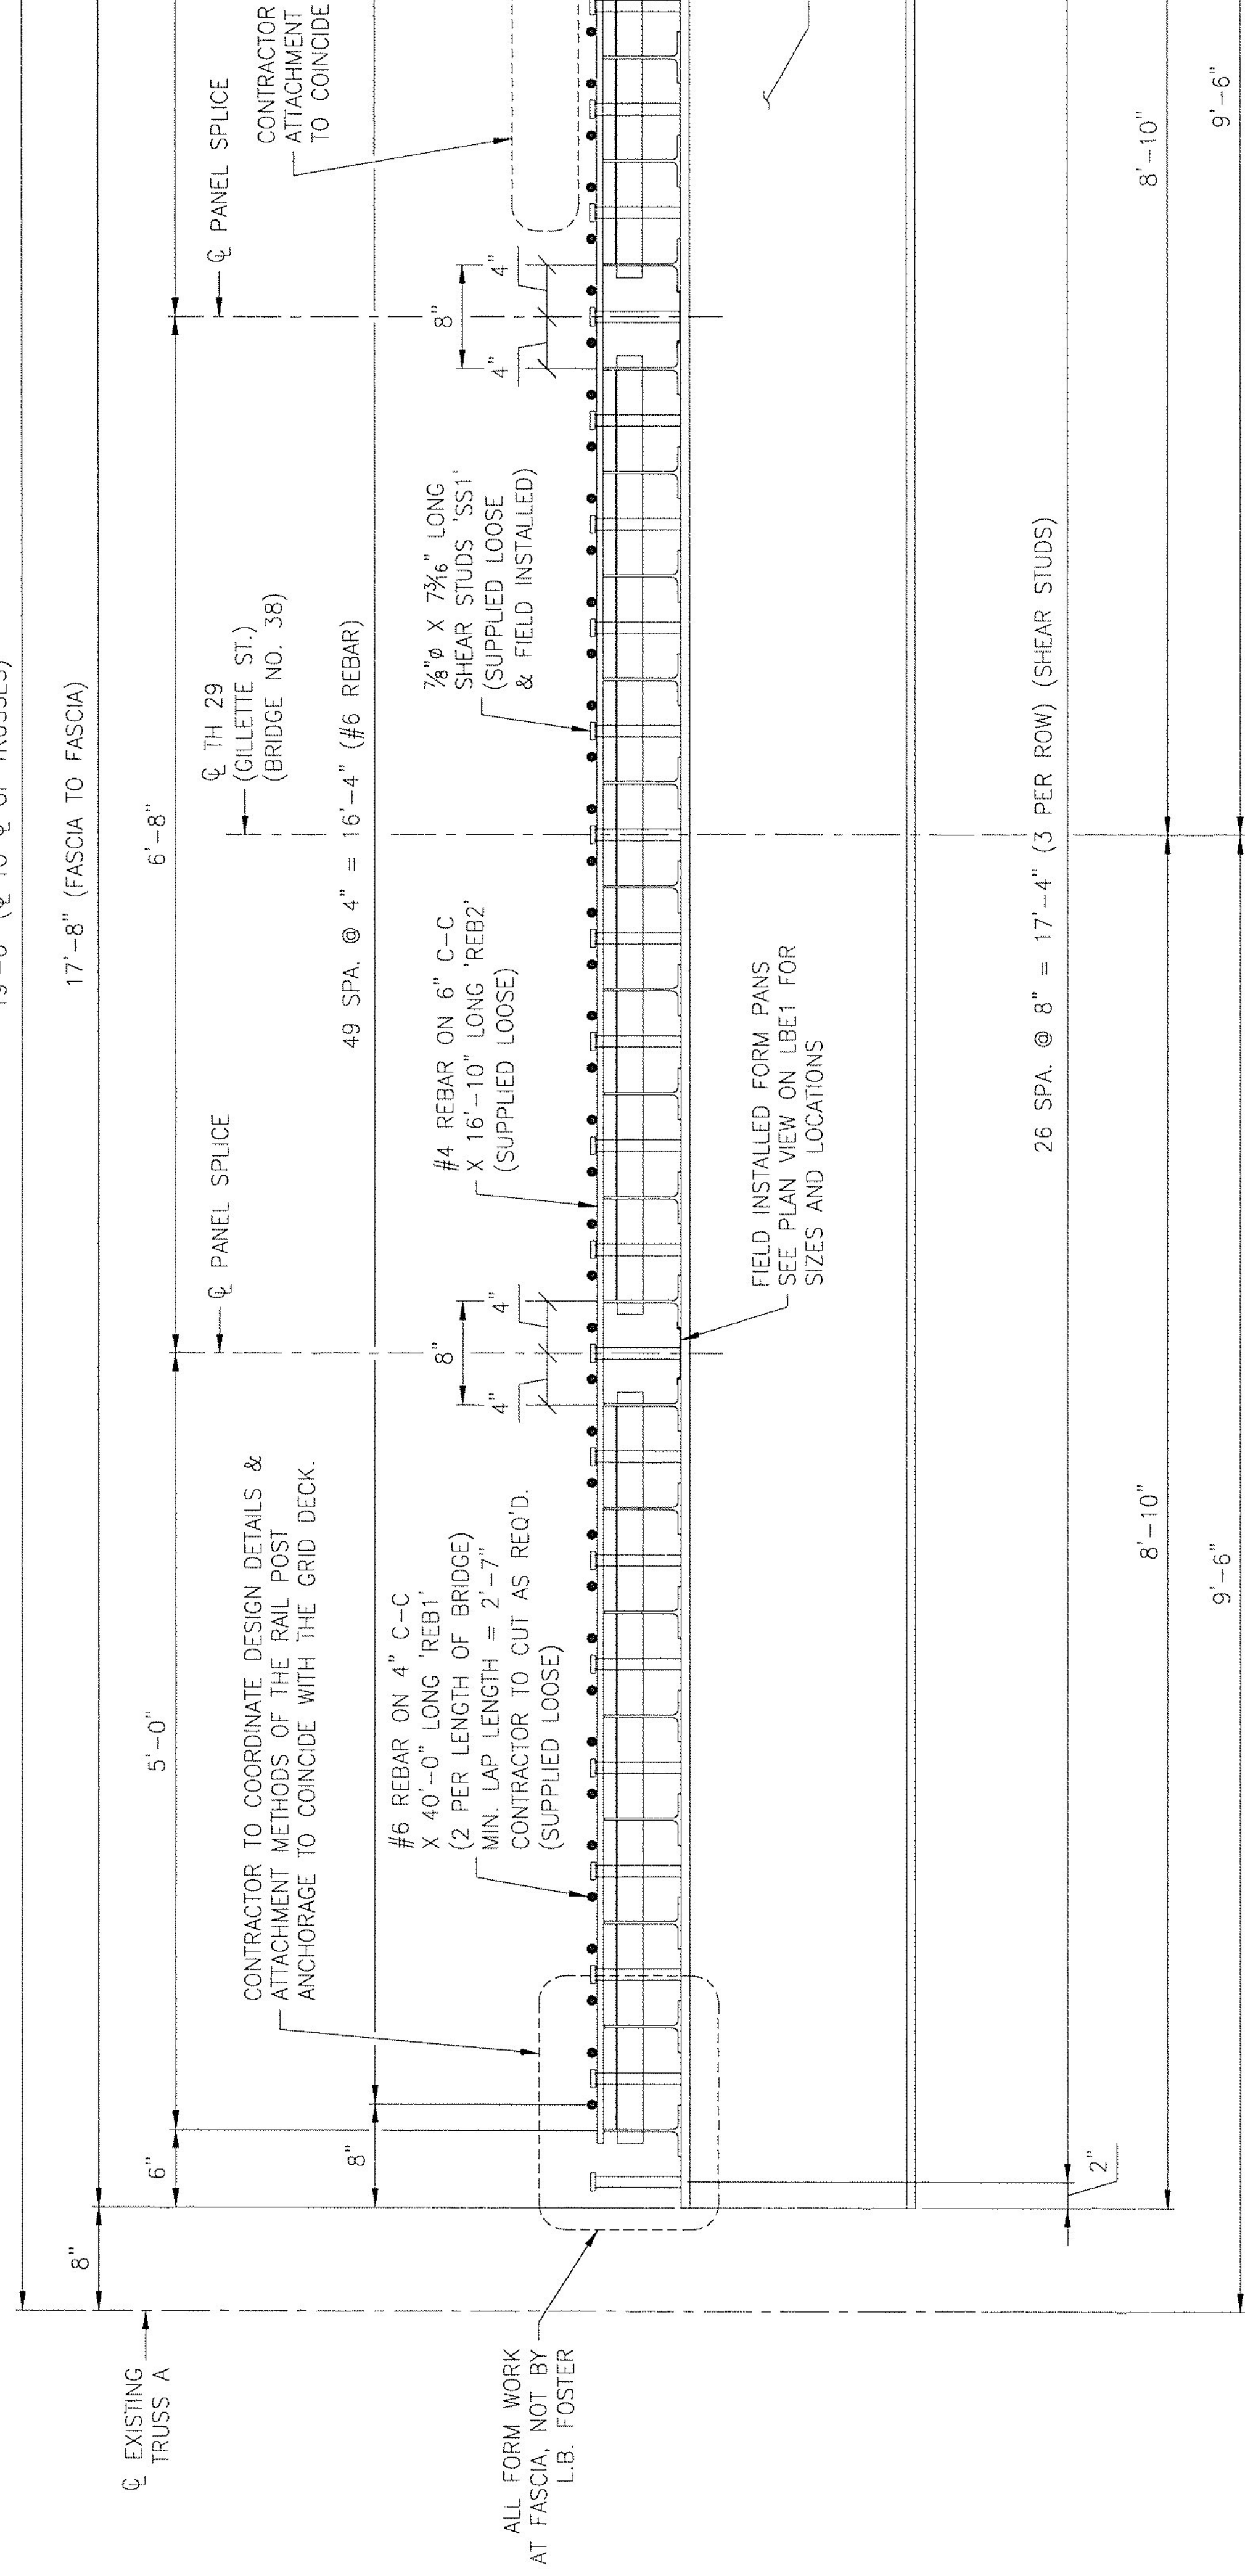

Vermont Agency of Transportation

RECEIVED

CK'D BY TCF OK'D BY KMH

9:55 am, Feb 16, 2011

RESUBMIT APPROVED X

BY KMH DATE 3-30-11

SECTION A-A
BRIDGE CROSS SECTION

