


VERTICAL PROFILE

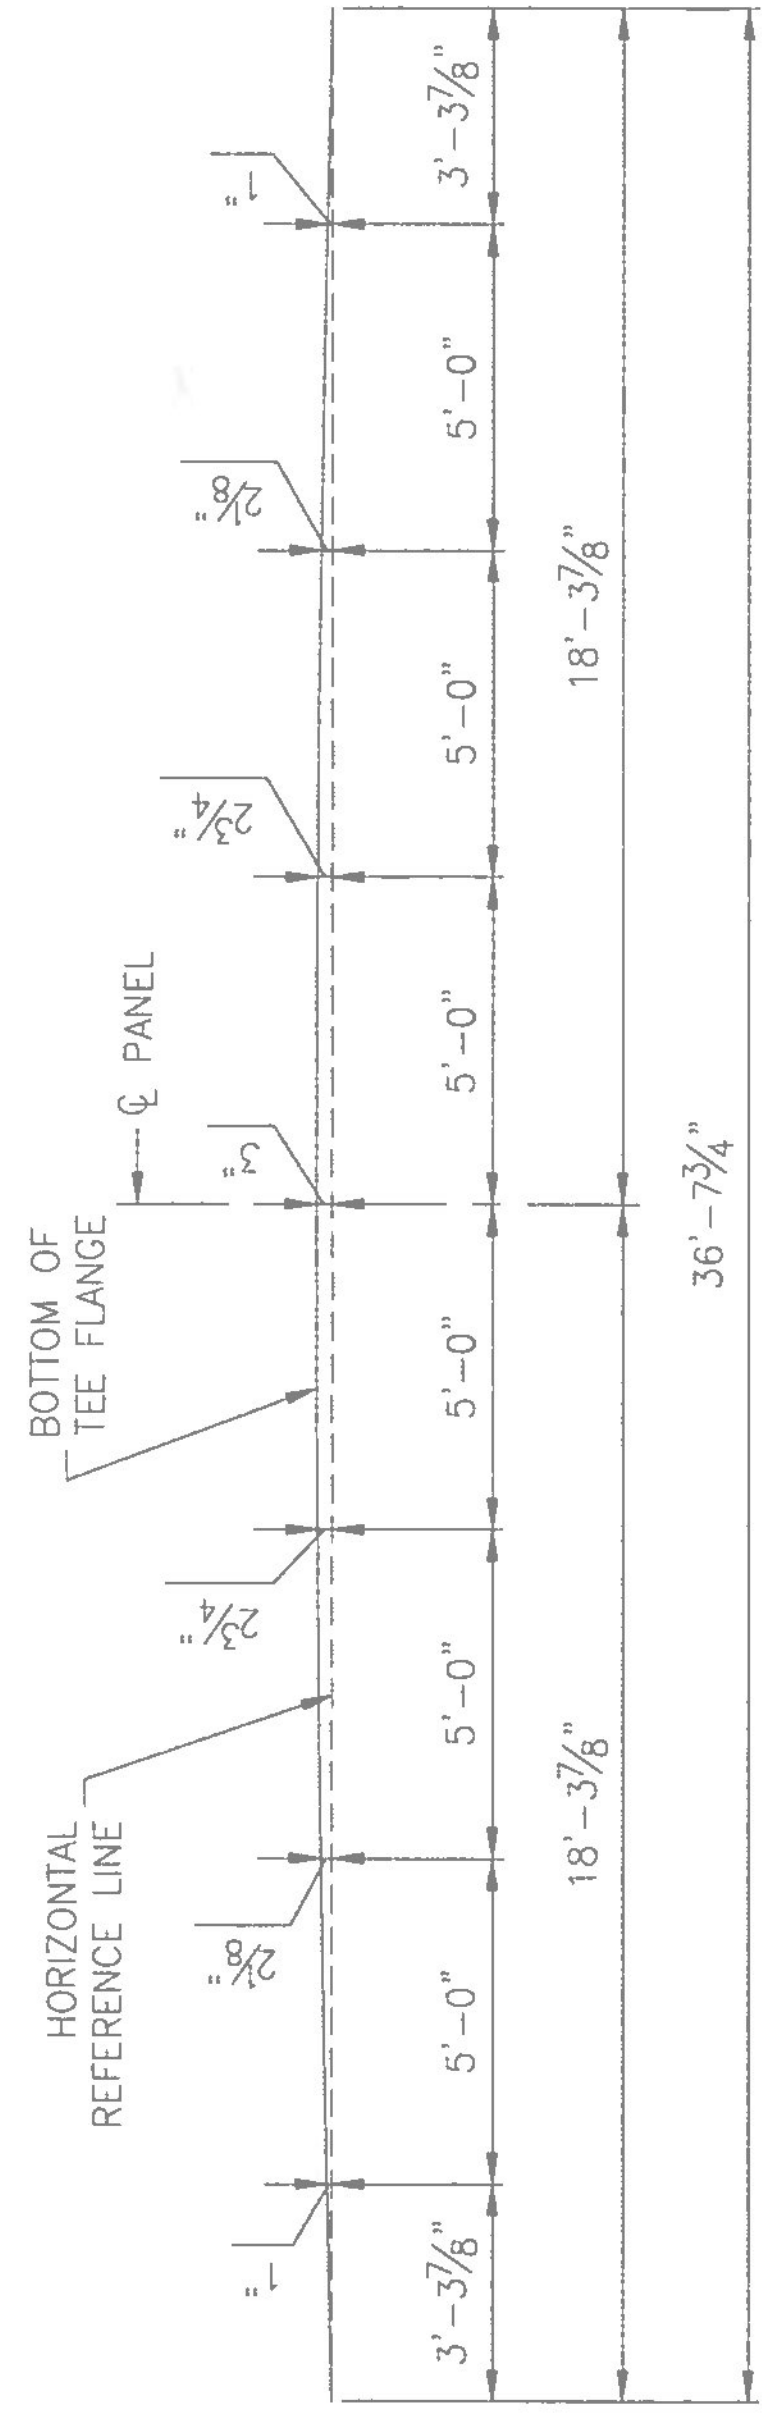

PANEL CAMBER DIAGRAM