


PLAN VIEW

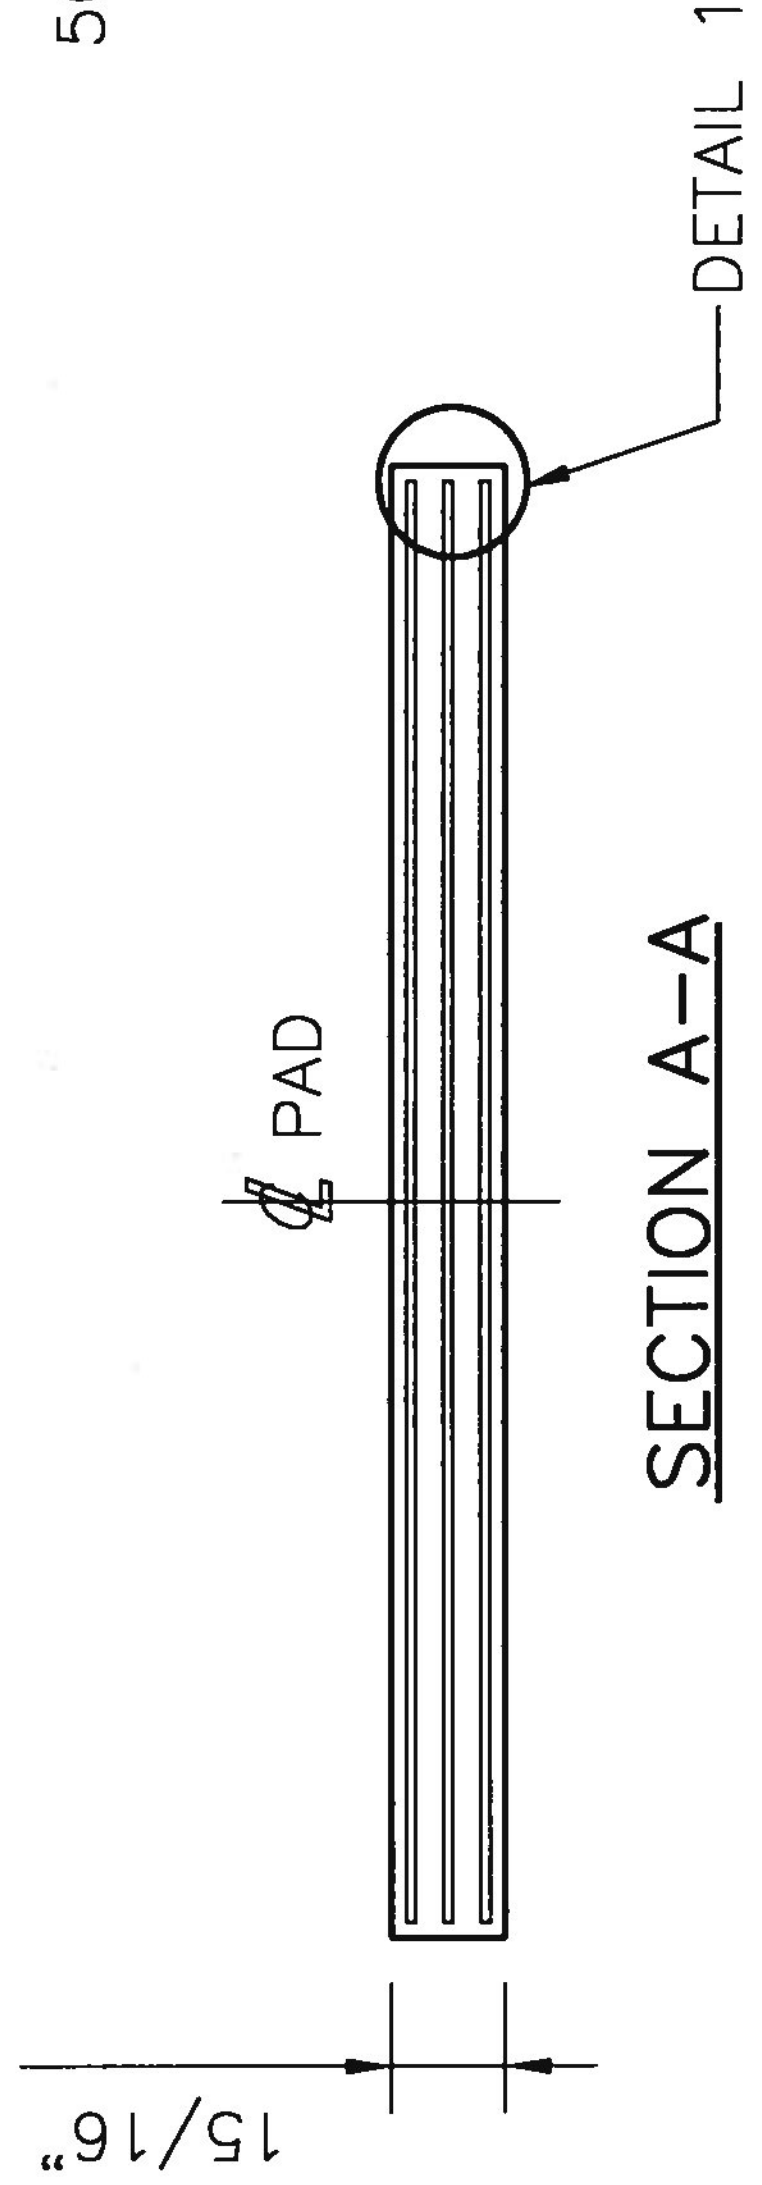


SECTION A-A

LAMINATED ELASTOMERIC BEARING PADS

(4) REQUIRED TOTAL

1/8" COVER
ALL AROUND

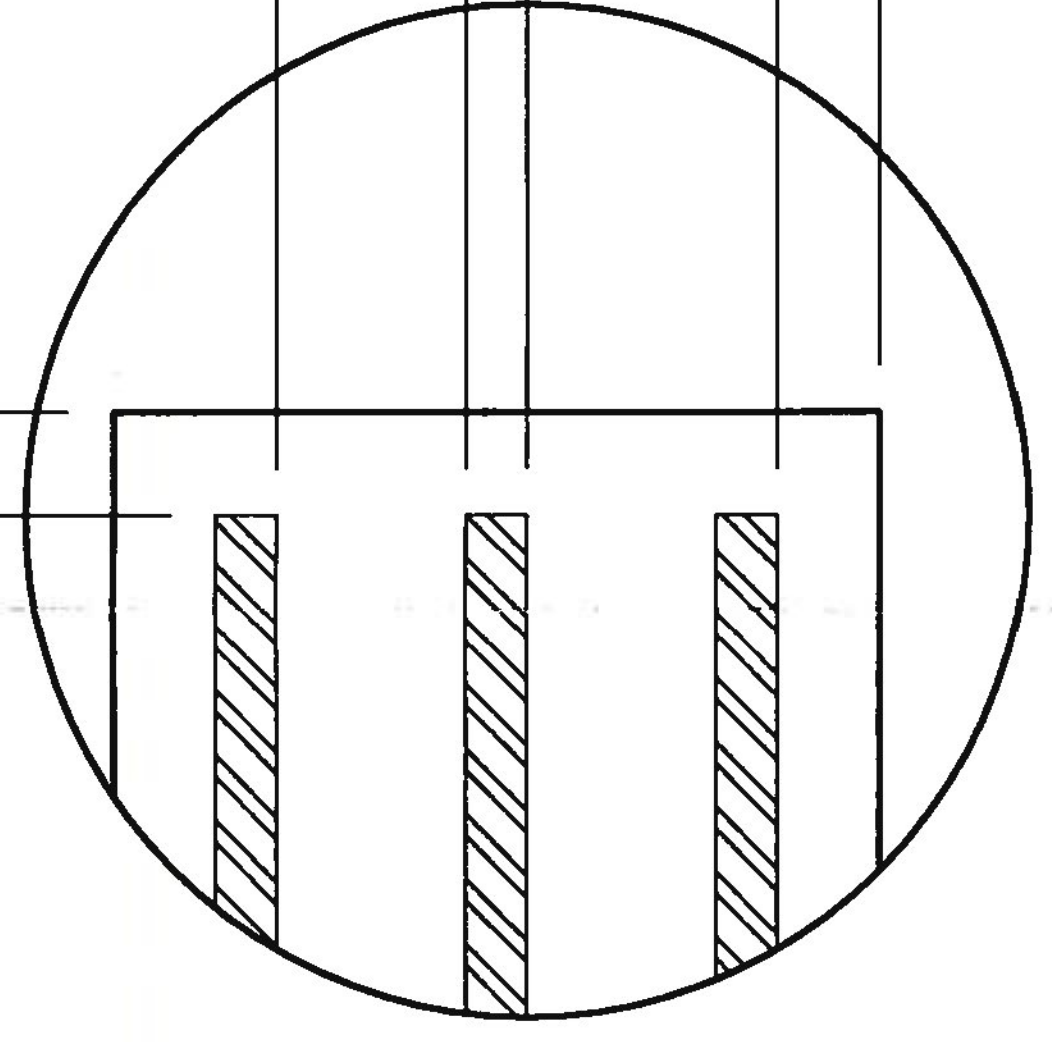

DETAIL 1

MK: LEP-1

(4) REQUIRED TOTAL
15/16" X 10" X 10"

50 DUROMETER GRADE 4 NATURAL RUBBER. Δ

TOP & BOTTOM 1/8"
14 GA. (.0747) SHIM
(3) REQUIRED
1/4" INTERNAL LAYERS
(2) REQUIRED

CHE

OWNER PREPARED DRAWING
FOR CONFORMANCE WITH
DIMENSIONAL REQUIREMENTS

Vermont Agency of Transportation

RECEIVED

CK'D BY TCF OK'D BY KMH

2:22 pm, Apr 07, 2011

RESUBMIT APPROVED X

BY KMH DATE 4-8-11

REVISIONS	REV.