


Joint Detail

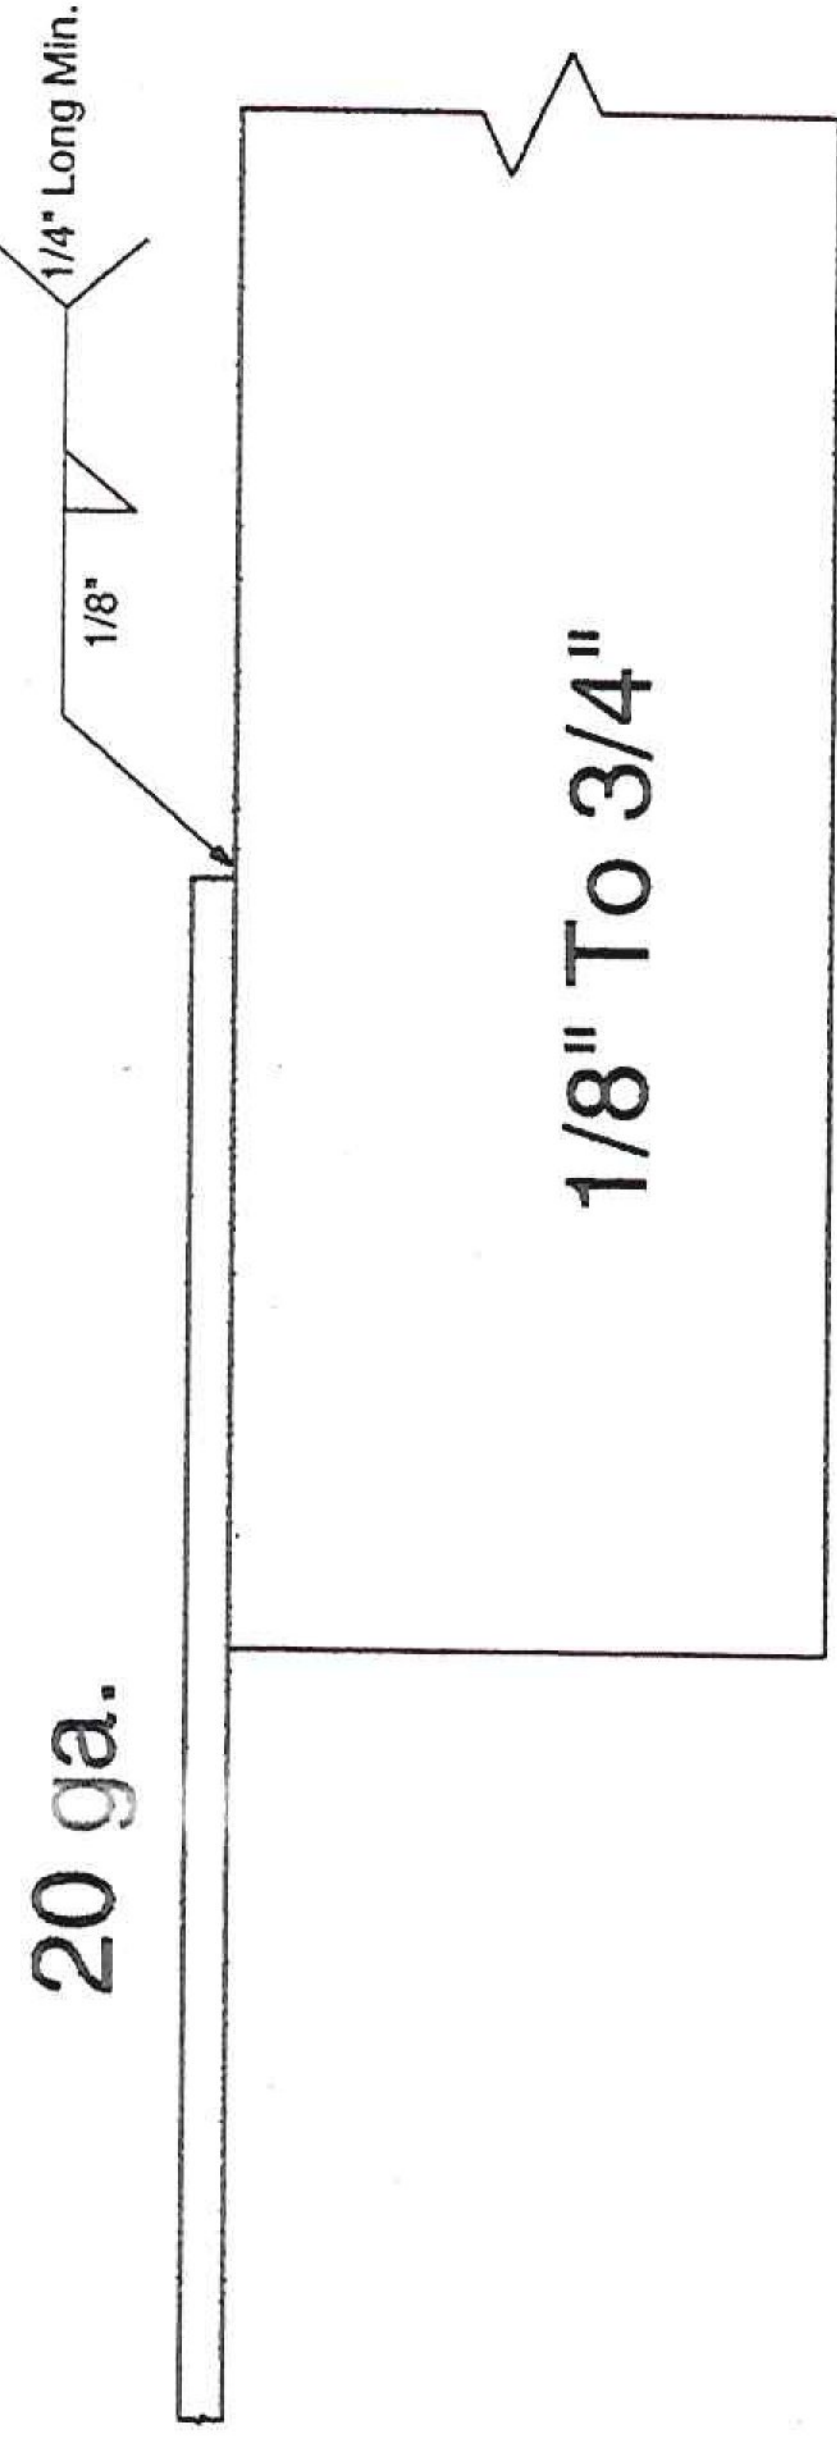

MEMO

This WPS written in conformance with AWS D1.3 2008  
For Bridge Flooring Form Pan Attachment Welding Only.

RECEIVED

CK'D BY \_\_\_\_\_ OK'D BY \_\_\_\_\_

FEB 16 2011

RESUBMIT \_\_\_\_\_ APPROVED

BY *KMH* DATE *2/24/11*