


SEE SHEET 2 FOR INDEX OF SHEETS AND LIST OF STANDARDS

# STATE OF VERMONT AGENCY OF TRANSPORTATION

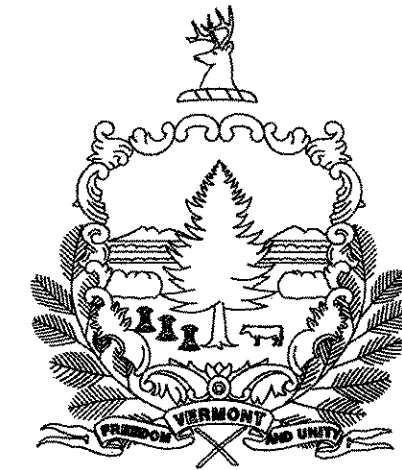


## PROPOSED IMPROVEMENT BRIDGE PROJECT TOWN OF WEATHERSFIELD COUNTY OF WINDSOR T.H. 20 BRIDGE # 66


BEGINNING IMMEDIATELY SOUTH OF STATE ROUTE 131  
ACROSS THE BLACK RIVER FROM THE INTERSECTION OF T.H. 20 AND T.H. 19

LENGTH OF ROADWAY = 54.25 FEET (0.010 MILES)  
LENGTH OF BRIDGE = 120.75 FEET (0.023 MILES)  
LENGTH OF PROJECT = 175.00 FEET (0.033 MILES)

WORK TO BE PERFORMED ON THIS PROJECT INCLUDES REHABILITATION OF EXISTING COVERED BRIDGE, WITH NECESSARY APPROACH WORK

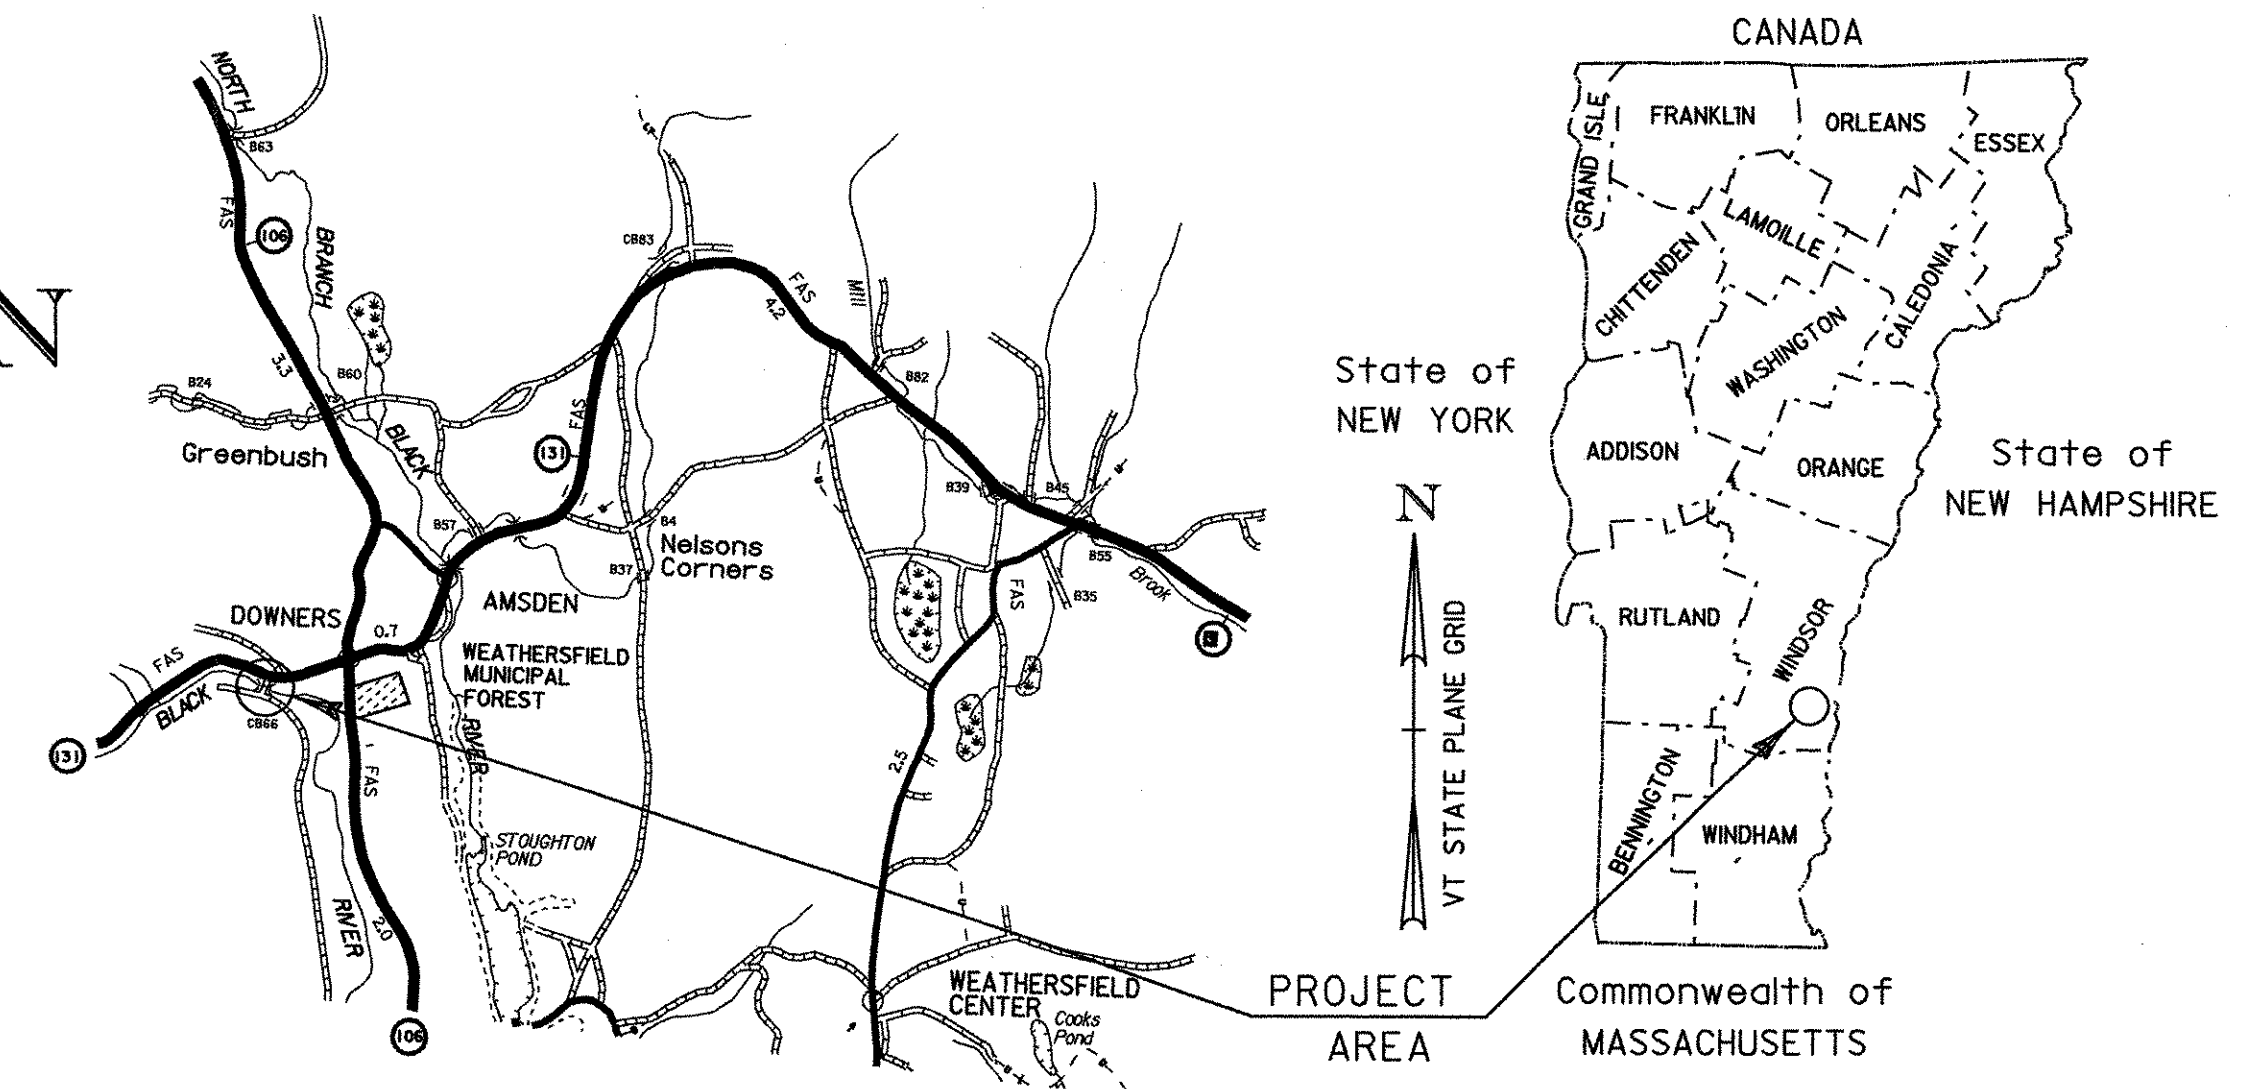


| RECORD PLANS   |  |
|--|--|
| CONTRACTOR:  | WRIGHT CONSTRUCTION CO., INC. - MT HOLLY, VT |
| RESIDENT ENGINEER:   | TOM CHASE                                    |
| CONSTRUCTION BEGAN:  | JUNE 18, 2007                                |
| CONSTRUCTION COMPLETE:   | OCTOBER 7, 2008                              |
| RECORD PLANS BY:   | TOM CHASE & BEN LOGAN                        |
| I HEREBY CERTIFY THAT ALL THE CONSTRUCTION REQUIRED BY THIS SET OF DRAWINGS HAS BEEN ACCOMPLISHED AS INDICATED HEREIN.   |  |
| BY <i>Jacques D. Couture</i>   | RESIDENT ENGINEER                            |
| DATE   | 9/29/09                                      |
| NOTE: Any further information concerning final quantities, amounts or other details relative to this project may be found at Central Files in the electronic archives. |  |

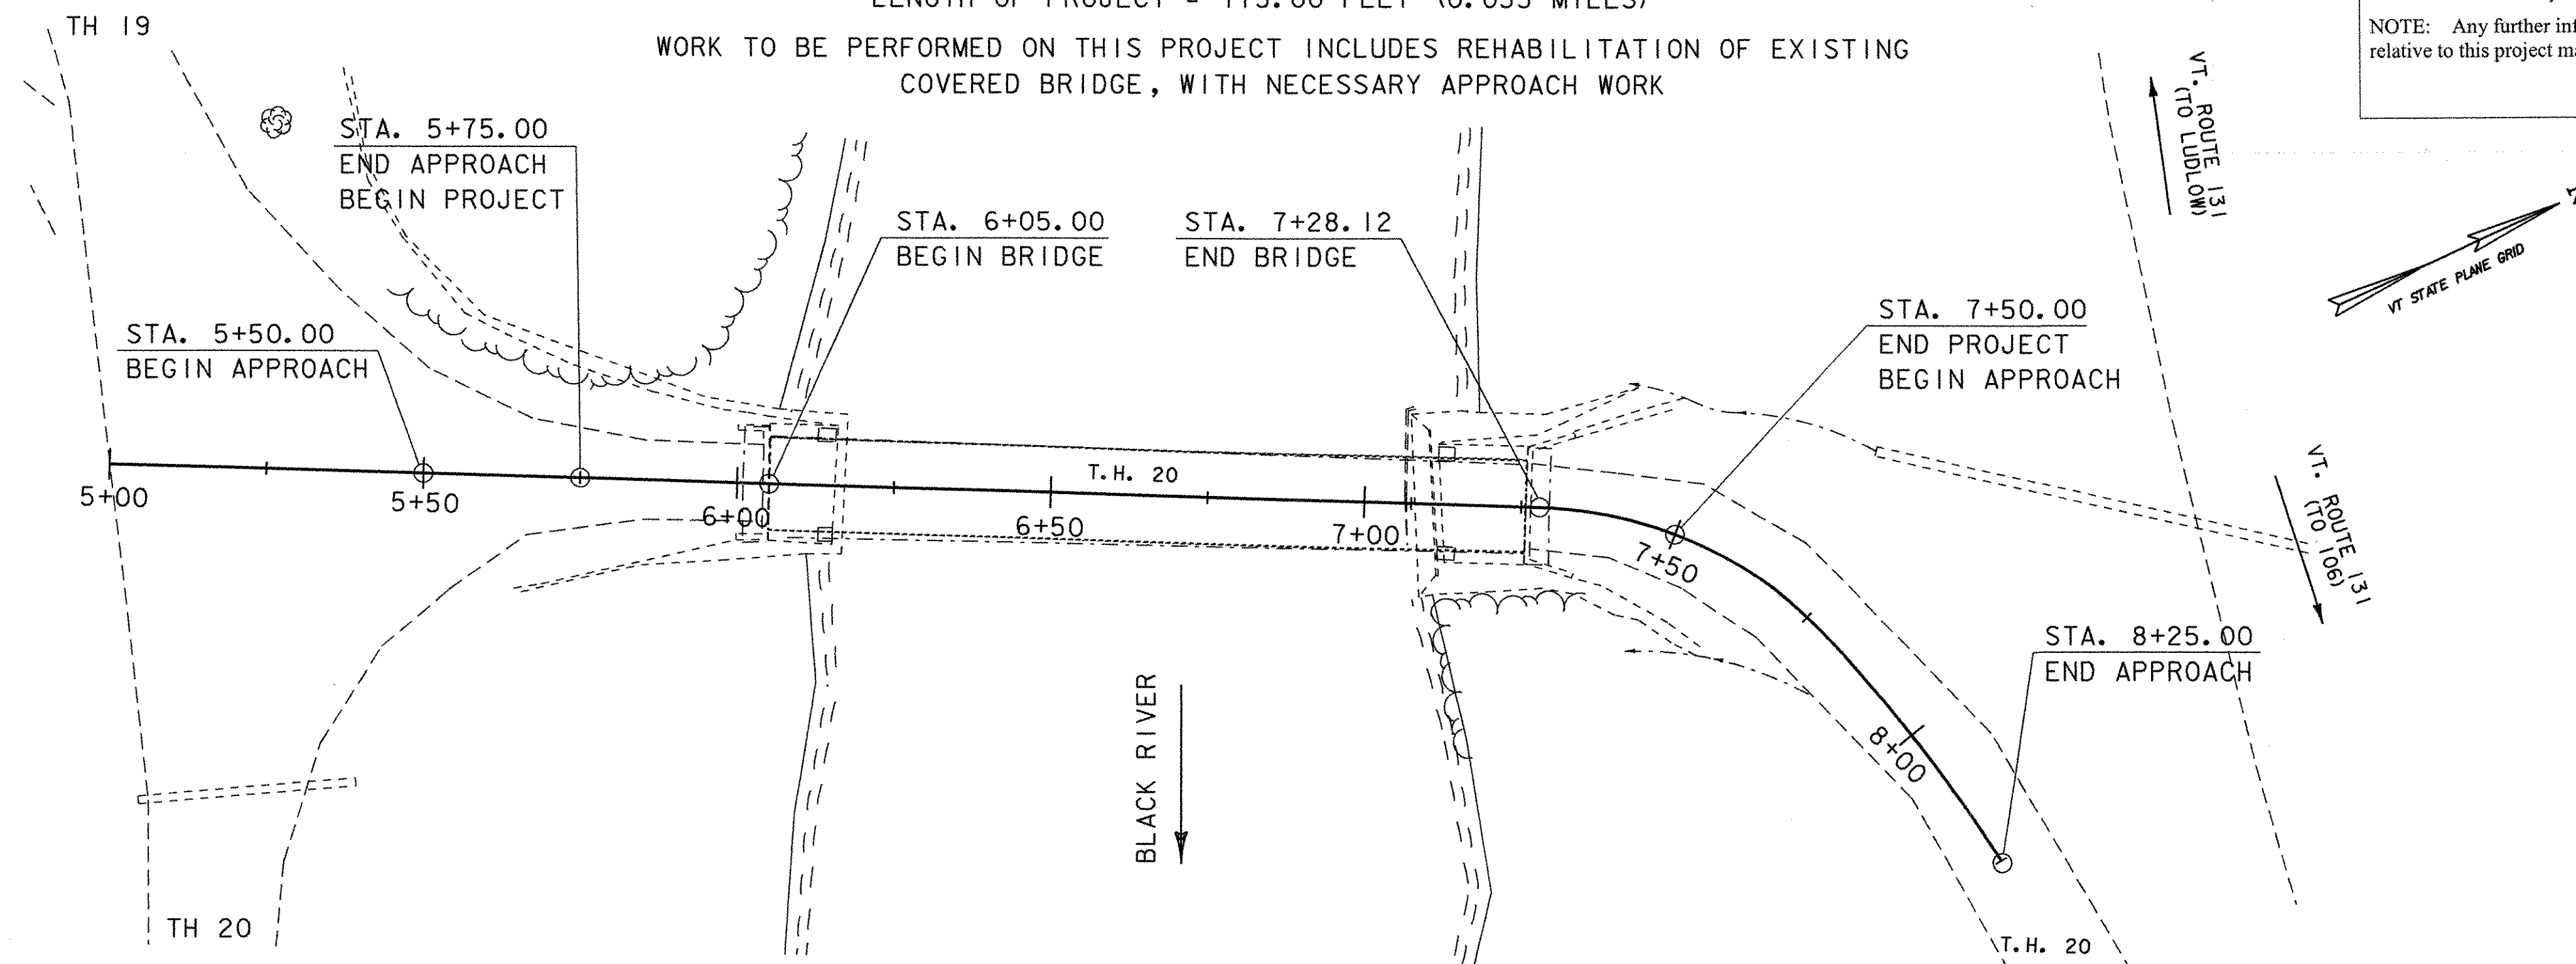

| CONVENTIONAL SYMBOLS |  |
|----------------------|--|
| COUNTY LINE          |  |
| TOWN LINE            |  |
| LIMITS OF ACCESS     |  |
| POINT OF ACCESS      |  |
| FENCE LINE           |  |
| STONE WALL           |  |
| TRAVELED WAY         |  |
| GUARD RAIL           |  |
| RAILROAD             |  |
| SURVEY LINE          |  |
| CULVERT              |  |
| POWER POLE           |  |
| TELEPHONE POLE       |  |
| TREES                |  |
| CONTROL OF ACCESS    |  |
| PROPERTY LINE        |  |
| R.O.W. TAKING LINE   |  |
| SLOPE RIGHTS         |  |
| TOP OF CUT           |  |
| TOE OF SLOPE         |  |

SURVEYED BY : R. GILMAN  
SURVEYED DATE : 12/23/02

DATUM  
VERTICAL NAVD 88  
HORIZONTAL NAD-83 (96)

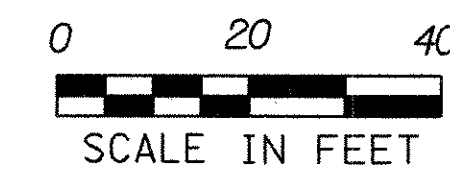

THESE PLANS ARE SUBJECT TO SUCH ENGINEERING CHANGES AS MAY BE REQUIRED BY THE FEDERAL HIGHWAY ADMINISTRATION OR THE DIRECTOR OF PROGRAM DEVELOPMENT.

CONSTRUCTION IS TO BE CARRIED ON IN ACCORDANCE WITH THESE PLANS AND THE STANDARD SPECIFICATIONS FOR CONSTRUCTION DATED 2006, AS APPROVED BY THE FEDERAL HIGHWAY ADMINISTRATION ON JUNE 15, 2006 FOR USE ON THIS PROJECT, INCLUDING ALL SUBSEQUENT REVISIONS AND SUCH REVISED SPECIFICATIONS AND SPECIAL PROVISIONS AS ARE INCORPORATED IN THESE PLANS.

|  |
|--|
| DEPARTMENT OF TRANSPORTATION<br>FEDERAL HIGHWAY ADMINISTRATOR    |
| APPROVED <i>Tad C. Kimball</i> DATE 3-16-07                      |
| DIRECTOR OF PROGRAM DEVELOPMENT                                  |
| APPROVED <i>Richard Johnson</i> DATE 3-1-07                      |
| PROJECT MANAGER : W. SYMONDS                                     |
| PROJECT NAME : WEATHERSFIELD<br>PROJECT NUMBER : AC 0601442 (29) |
| SHEET 1 OF 60 SHEETS   |