


**PROFILE ALONG TH 20**

**NOTE:**  
 ELEVATIONS SHOWN TO BE THE NEAREST TENTH ARE EXISTING GROUND ALONG THE CENTERLINE. ELEVATIONS SHOWN TO THE NEAREST HUNDREDTH ARE FINISH GRADES ALONG CENTERLINE.

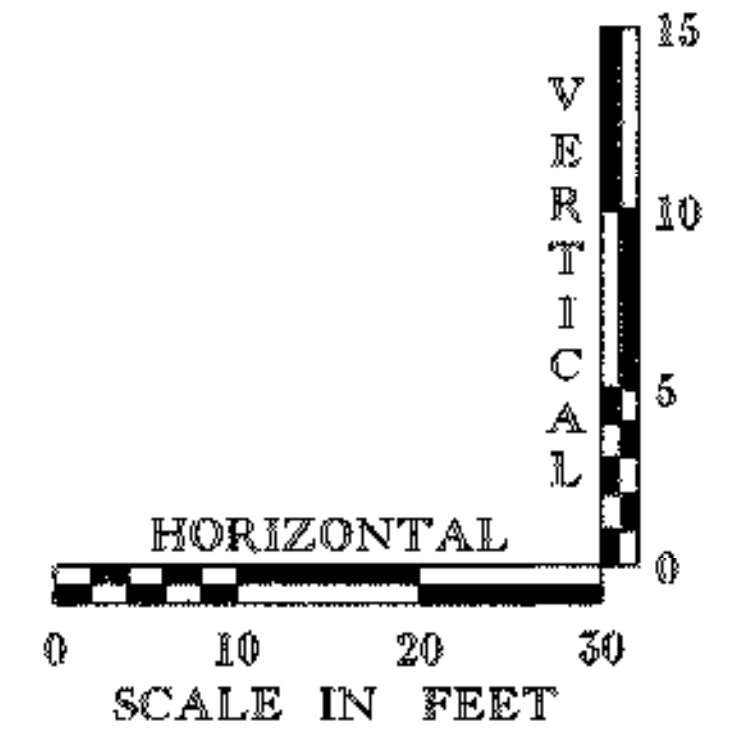

**PROFILE**

PROJECT NAME: WEATHERSFIELD	PLOT DATE: 15-MAR-2007
PROJECT NUMBER: BHO 1442(29)	DRAWN BY: G. SHANGRAW
FILE NAME: /96j234/str/e96j234xsl.dgn	CHECKED BY: T. SUMNER
DESIGNED BY: T. FILLBACH	SHEET 12 OF 60