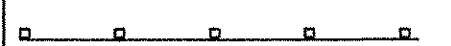

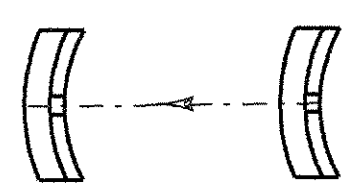


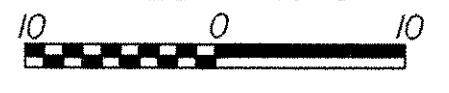
LEGEND

 SILT FENCE
 PROJECT DEMARCATION FENCE
 TEMPORARY STONE CHECK DAM, TYPE I

EXISTING CONTOURS ARE SHOWN.
SEE CROSS SECTIONS FOR FINAL CONTOURS.

CURVE #1 DATA
 $\Delta = 44^{\circ}-10'-12.4''$ Rt.
 $D = 88^{\circ}-08'-50.5''$
 $R = 65.00$
 $T = 26.37$
 $L = 50.11$
 $E = 5.15$

CURVE #2 DATA
 $\Delta = 9^{\circ}-26'-49.2''$ Rt.
 $D = 25^{\circ}-41'-35.4''$
 $R = 223.00$
 $T = 18.43$
 $L = 36.77$
 $E = 0.76$

SCALE 1" = 10'-0"


TEMPORARY EROSION PREVENTION & SEDIMENT CONTROL

PROJECT NAME: WEATHERSFIELD	PLOT DATE: 15-MAR-2007
PROJECT NUMBER: BHO 1442(29)	DRAWN BY: J. GILMORE
FILE NAME: /96j234/str/s96j234ec.dgn	DESIGNED BY: T. FILLBACH
PROJECT LEADER: W. SYMONDS	CHECKED BY: T. SUMNER
sj234ec5.1	SHEET 20 OF 60