


PLAN

SCALE 1" = 10'-0"

CURVE #1 DATA
 $\Delta = 44^\circ - 10' - 12.4''$ Rt.
 $D = 88^\circ - 08' - 50.5''$
 $R = 65.00$
 $T = 26.37$
 $L = 50.11$
 $E = 5.35$

CURVE #2 DATA

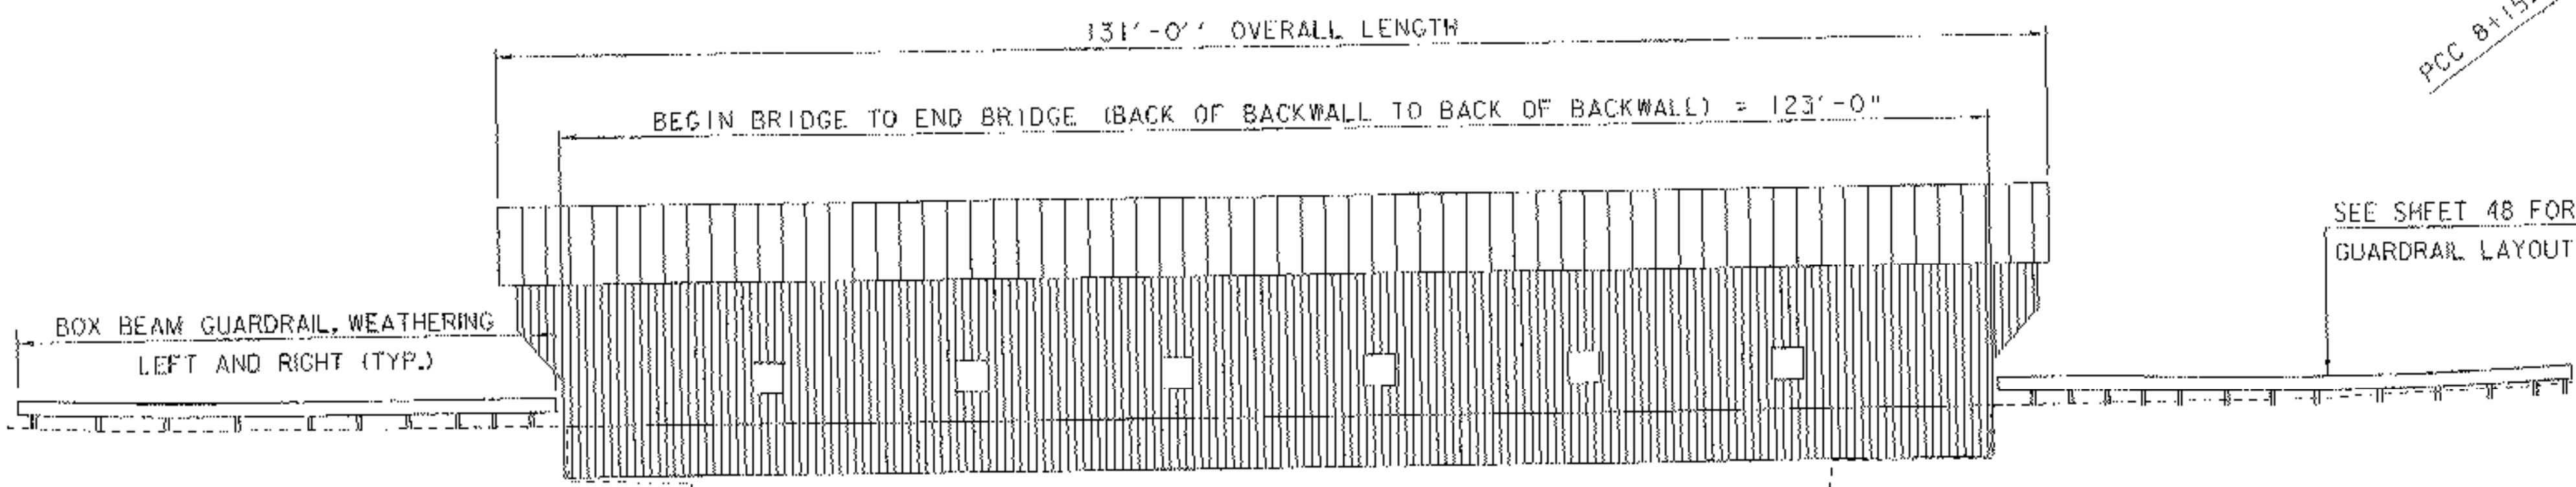

ELEVATION

SCALE 1" = 10'-0"

PLAN AND ELEVATION

PROJECT NAME: WEATHERSFIELD	PLOT DATE: 15-MAR-2007
PROJECT NUMBER: BHO 1442(29)	DRAWN BY: G. SHANGRAW
FILE NAME: /961234/str/8961234pe.dgn	DESIGNED BY: T. FILLBACH
PROJECT LEADER: W. SYMONDS	CHECKED BY: T. SUMNER
DESIGNED BY: T. FILLBACH	SHEET 29 OF 60