





-  ADDITIONAL PIECE DETERMINED TO BE REPLACED DURING SITE VISIT WITH JOE POSTON AND SCOTT NEWMAN
-  END OF PIECE WITH DRY ROT CUT OFF REST OF PIECE SAVED
-  ADDITIONAL PIECES IDENTIFIED WITH SIGNIFICANT DRY ROT

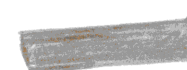

**TOP VIEW OF  
UPPER TOP CHORDS**

NOT TO SCALE

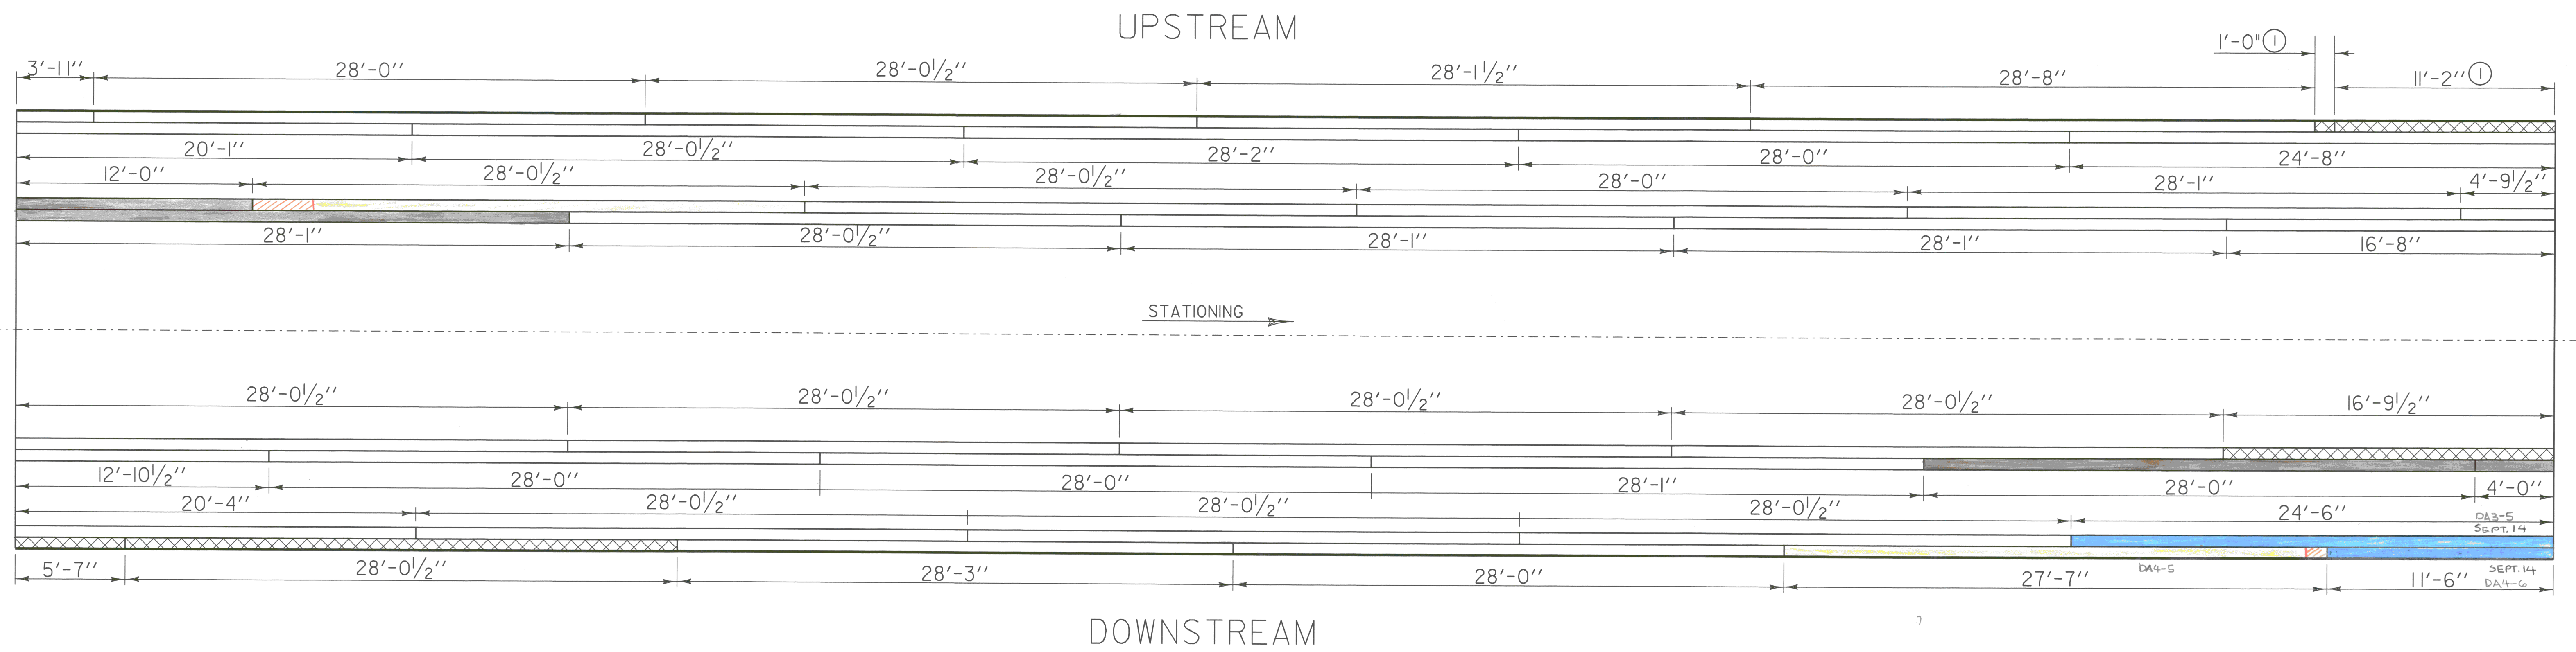APPROXIMATE MEMBER LENGTHS AND  
LOCATION OF JOINTS

 CROSSHATCHING DENOTES MEMBER PREDETERMINED TO BE REPLACED. ADDITIONAL MEMBERS MAY BE REQUIRED TO BE REPLACED. SEE GENERAL NOTE 12.

① REPLACE 1'-0" PIECE AND 11'-2" PIECE WITH ONE THAT IS 12'-2"

**UPPER TOP CHORD  
JOINT LOCATIONS**

PROJECT NAME: WEATHERSFIELD	
PROJECT NUMBER: BHO 1442(29)	
FILE NAME: /96j234/str/s96j234r-fp.dgn	PLOT DATE: 17-SEP-2007
PROJECT LEADER: W. SYMONDS	DRAWN BY: J. SALVATORI
DESIGNED BY: T. FILLBACH	CHECKED BY: T. SUMNER
sj234utc.i	SHEET 33 OF 60