


UPSTREAM

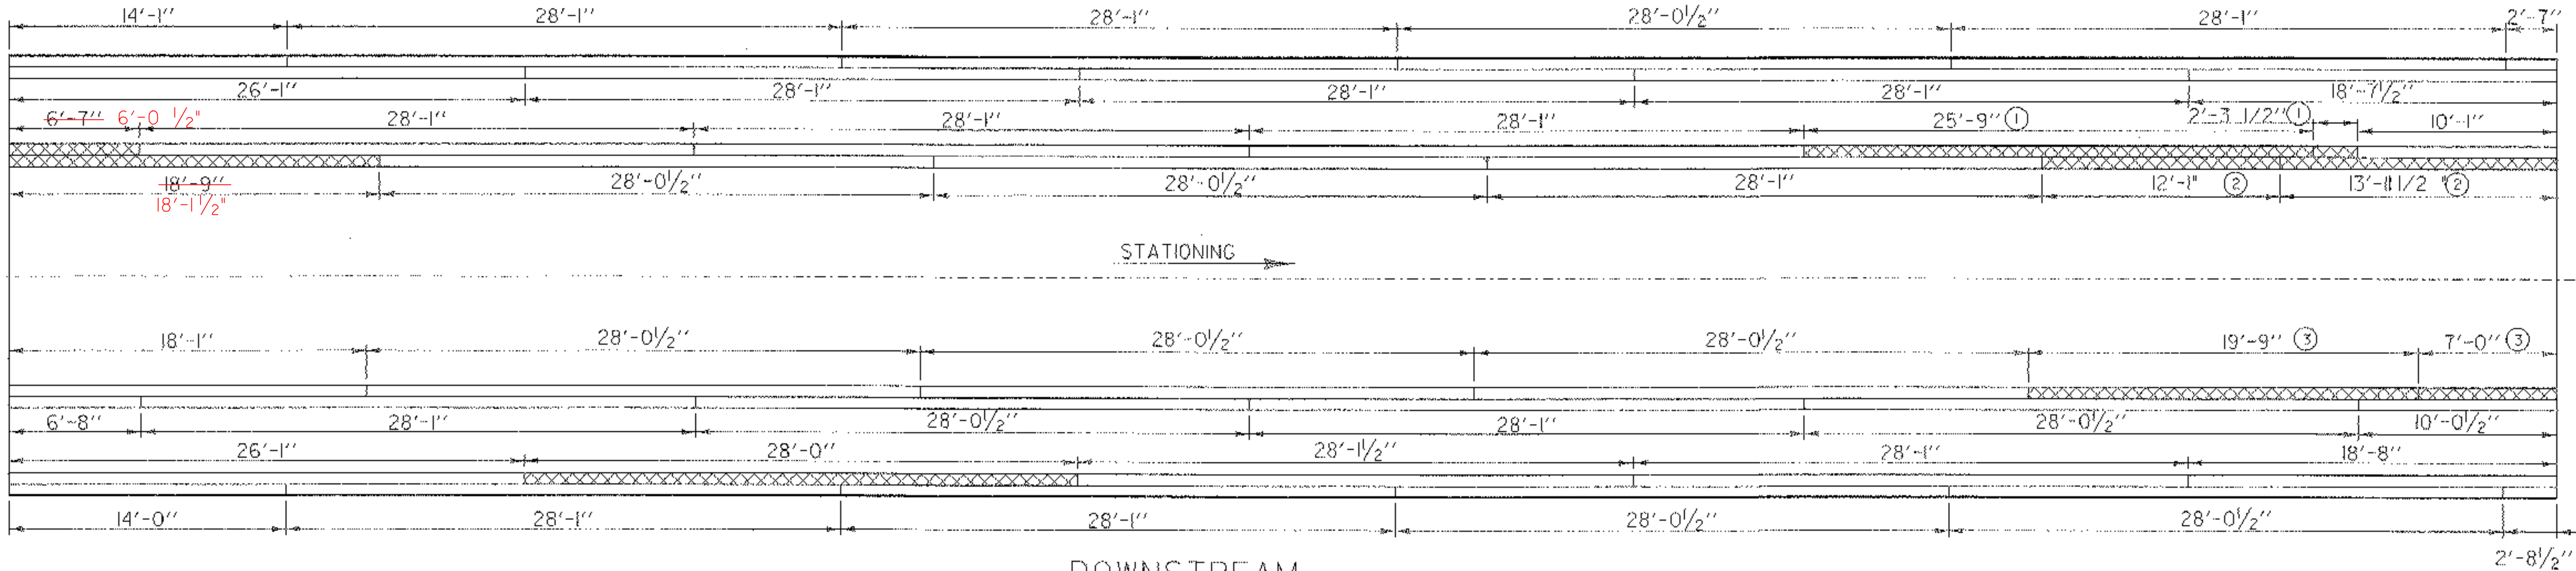


DOWNSTREAM

TOP VIEW OF LOWER TOP CHORDS **UNTREATED**

NOT TO SCALE

APPROXIMATE MEMBER LENGTHS AND LOCATION OF JOINTS

 CROSSHATCHING DENOTES MEMBER PREDETERMINED TO BE REPLACED. ADDITIONAL MEMBERS MAY BE REQUIRED TO BE REPLACED. SEE GENERAL NOTE 12.

- ① REPLACE 25'-9" PIECE AND 2'-3 1/2" PIECE WITH ONE THAT IS 28'-0 1/2"
- ② REPLACE 12'-1" PIECE AND 13'-11 1/2" PIECE WITH ONE THAT IS 26'-0 1/2"
- ③ REPLACE 19'-9" PIECE AND 7'-0" PIECE WITH ONE THAT IS 26'-9"

**LOWER TOP CHORD JOINT LOCATIONS**

PROJECT NAME:	WEATHERSFIELD
PROJECT NUMBER:	BHO 1442(29)
FILE NAME:	/96j234/str/s96j234rfp.dgn
PROJECT LEADER:	W. SYMONDS
DESIGNED BY:	T. FILLBACH
sj234r.cj	
PLOT DATE:	15-MAR-2007
DRAWN BY:	J. SALVATORI
CHECKED BY:	T. SUMNER
SHEET	34 OF 60