


UPSTREAM

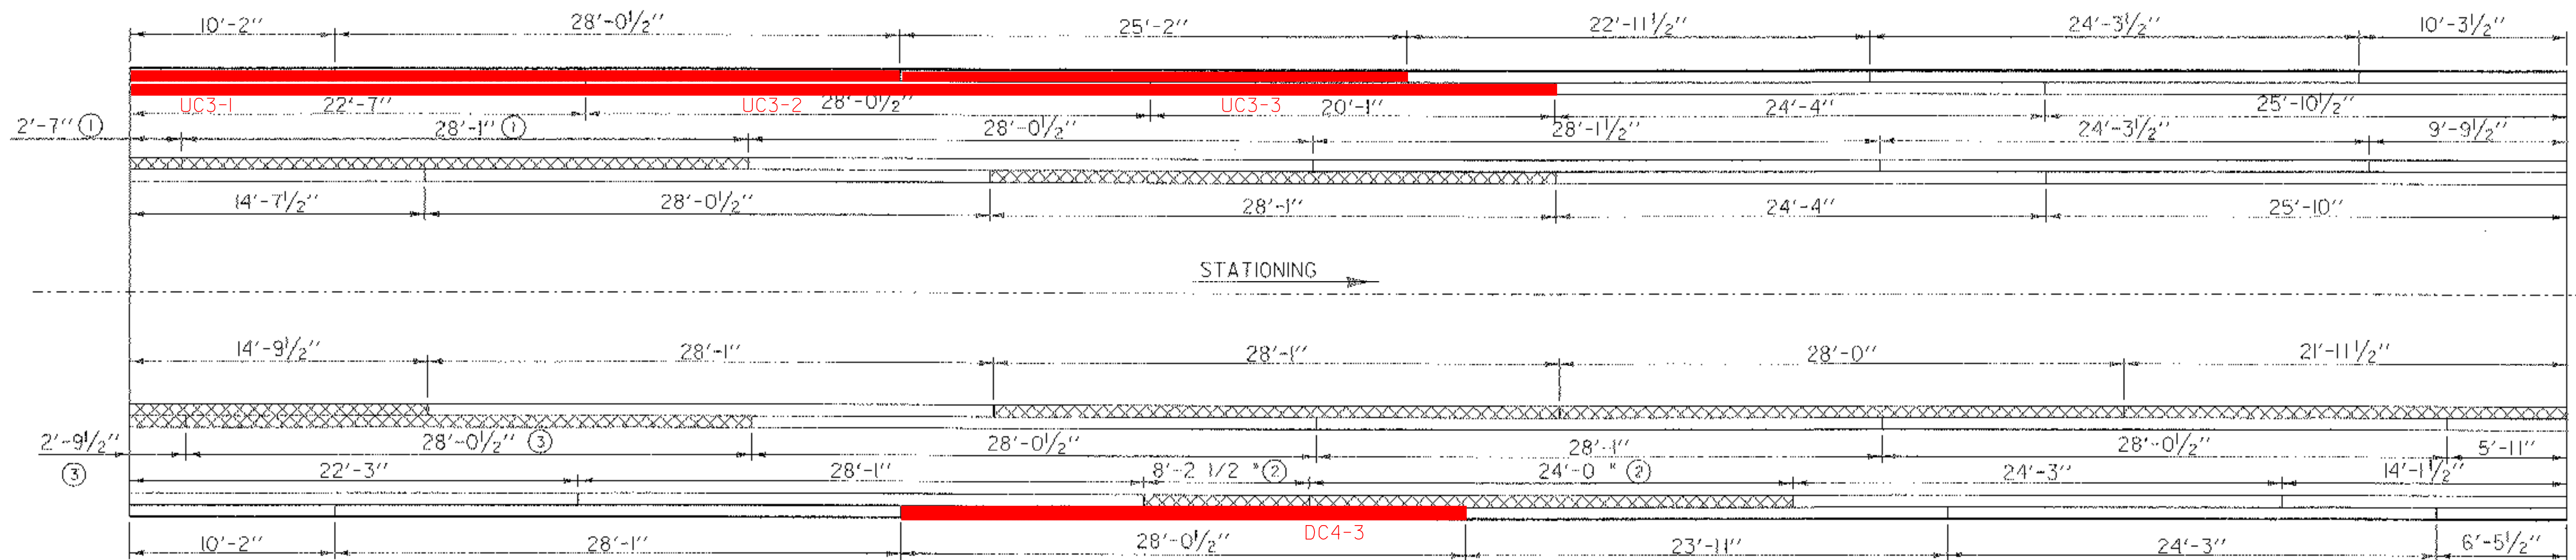


DOWNSTREAM

TOP VIEW OF  
UPPER BOTTOM CHORDS TREATED

NOT TO SCALE

APPROXIMATE MEMBER LENGTHS AND  
LOCATION OF JOINTS

 CROSSHATCHING DENOTES MEMBER PREDETERMINED TO BE REPLACED. ADDITIONAL MEMBERS MAY BE REQUIRED TO BE REPLACED. SEE GENERAL NOTE 12.

- ① REPLACE 2'-7" PIECE AND 28'-1" PIECE WITH ONE THAT IS 30'-8"
- ② REPLACE 8'-2 1/2" PIECE AND 24'-0" PIECE WITH ONE THAT IS 32'-2 1/2"
- ③ REPLACE 2'-9 2/2" PIECE AND 28'-0 1/2" PIECE WITH ONE THAT IS 30'-10" ONE THAT IS 32'-2 1/2"

**UPPER BOTTOM  
CHORD JOINT LOCATIONS**

PROJECT NAME:	WEATHERSFIELD
PROJECT NUMBER:	BHQ 1442(29)
FILE NAME:	/96j234/str/s96j234rfp.dgn
PROJECT LEADER:	W. SYMONUS
DESIGNED BY:	T. FILLBACH
sj234ubc.t	
PLOT DATE:	15-MAR-2007
DRAWN BY:	J. SALVATORI
CHECKED BY:	T. SUMNER
SHEET	35 OF 60