


UPSTREAM

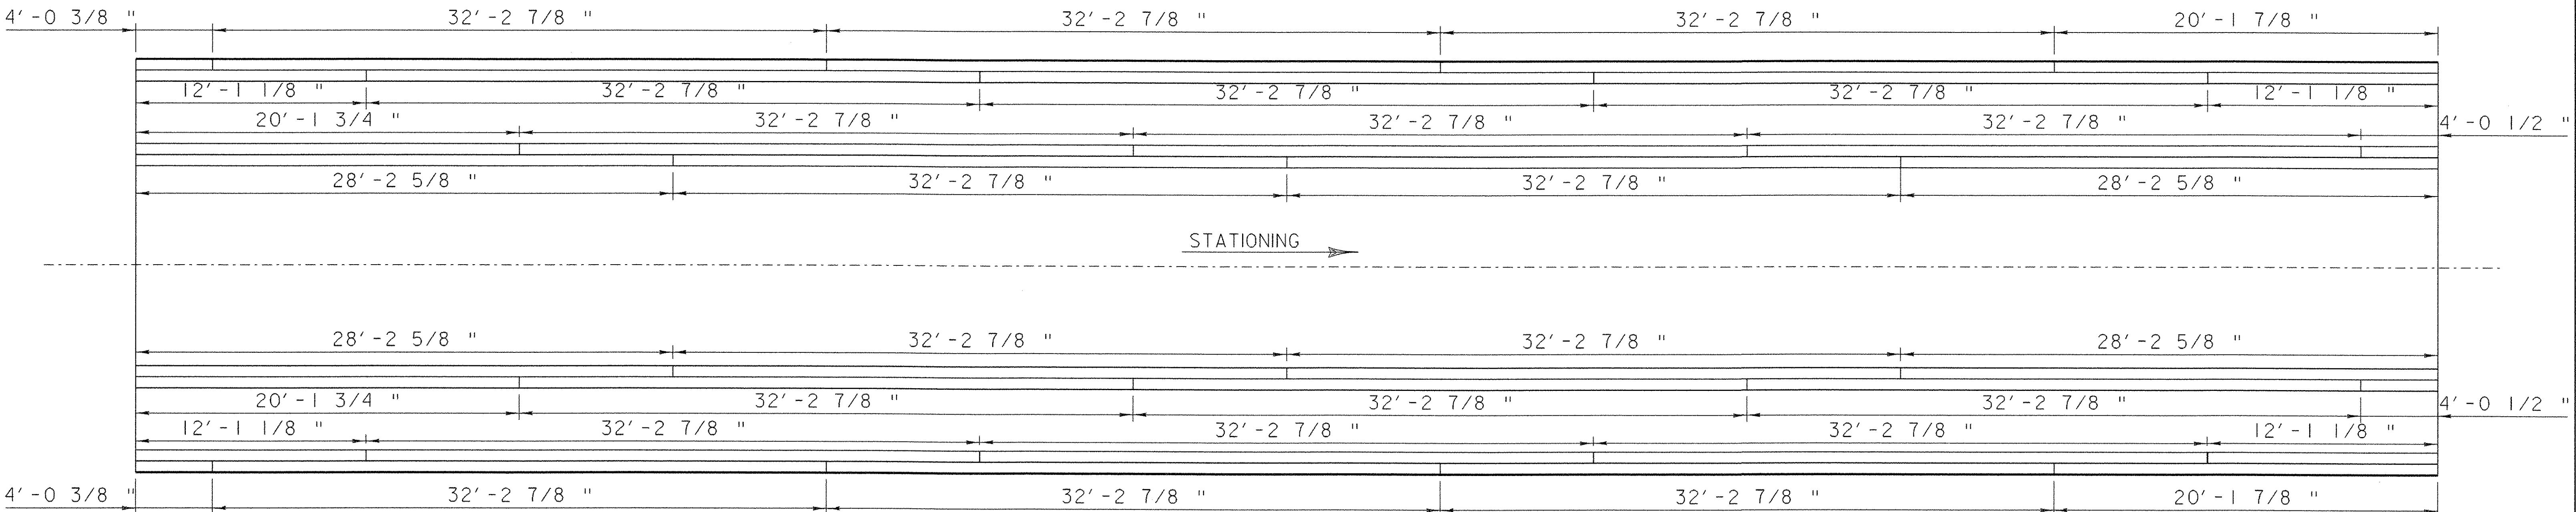

DOWNSTREAM

TOP VIEW OF
LOWER BOTTOM CHORDS
NOT TO SCALE

NOTE: THE ENTIRE LOWER BOTTOM CHORD WILL BE
REPLACED TO THE LENGTHS SHOWN ABOVE.

APPROXIMATE MEMBER LENGTHS AND
LOCATION OF JOINTS

**LOWER BOTTOM
CHORD JOINT LOCATIONS**

PROJECT NAME: WEATHERSFIELD	
PROJECT NUMBER: BHO 1442(29)	
FILE NAME: /96j234/str/s96j234rfp.dgn	PLOT DATE: 15-MAR-2007
PROJECT LEADER: W. SYMONDS	DRAWN BY: J. SALVATORI
DESIGNED BY: T. FILLBACH	CHECKED BY: T. SUMNER
sj234lbc.l	SHEET 36 OF 60