


**ABUTMENT 2  
CONCRETE  
FACING REPAIRS**

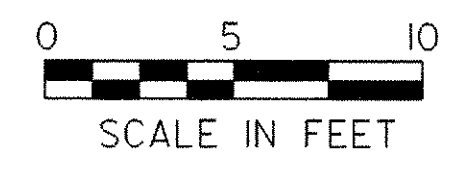

PROJECT NAME: WEATHERSFIELD	PLOT DATE: 15-MAR-2007
PROJECT NUMBER: BHO 1442(29)	DRAWN BY: G. SHANGRAW
FILE NAME: /96j234/concrepairbdr.dgn	CHECKED BY: J. LACROIX
PROJECT LEADER: W. SYMONDS	SHEET 42 OF 60
DESIGNED BY: T. SUMNER	
concreterepr.i	