



5+25

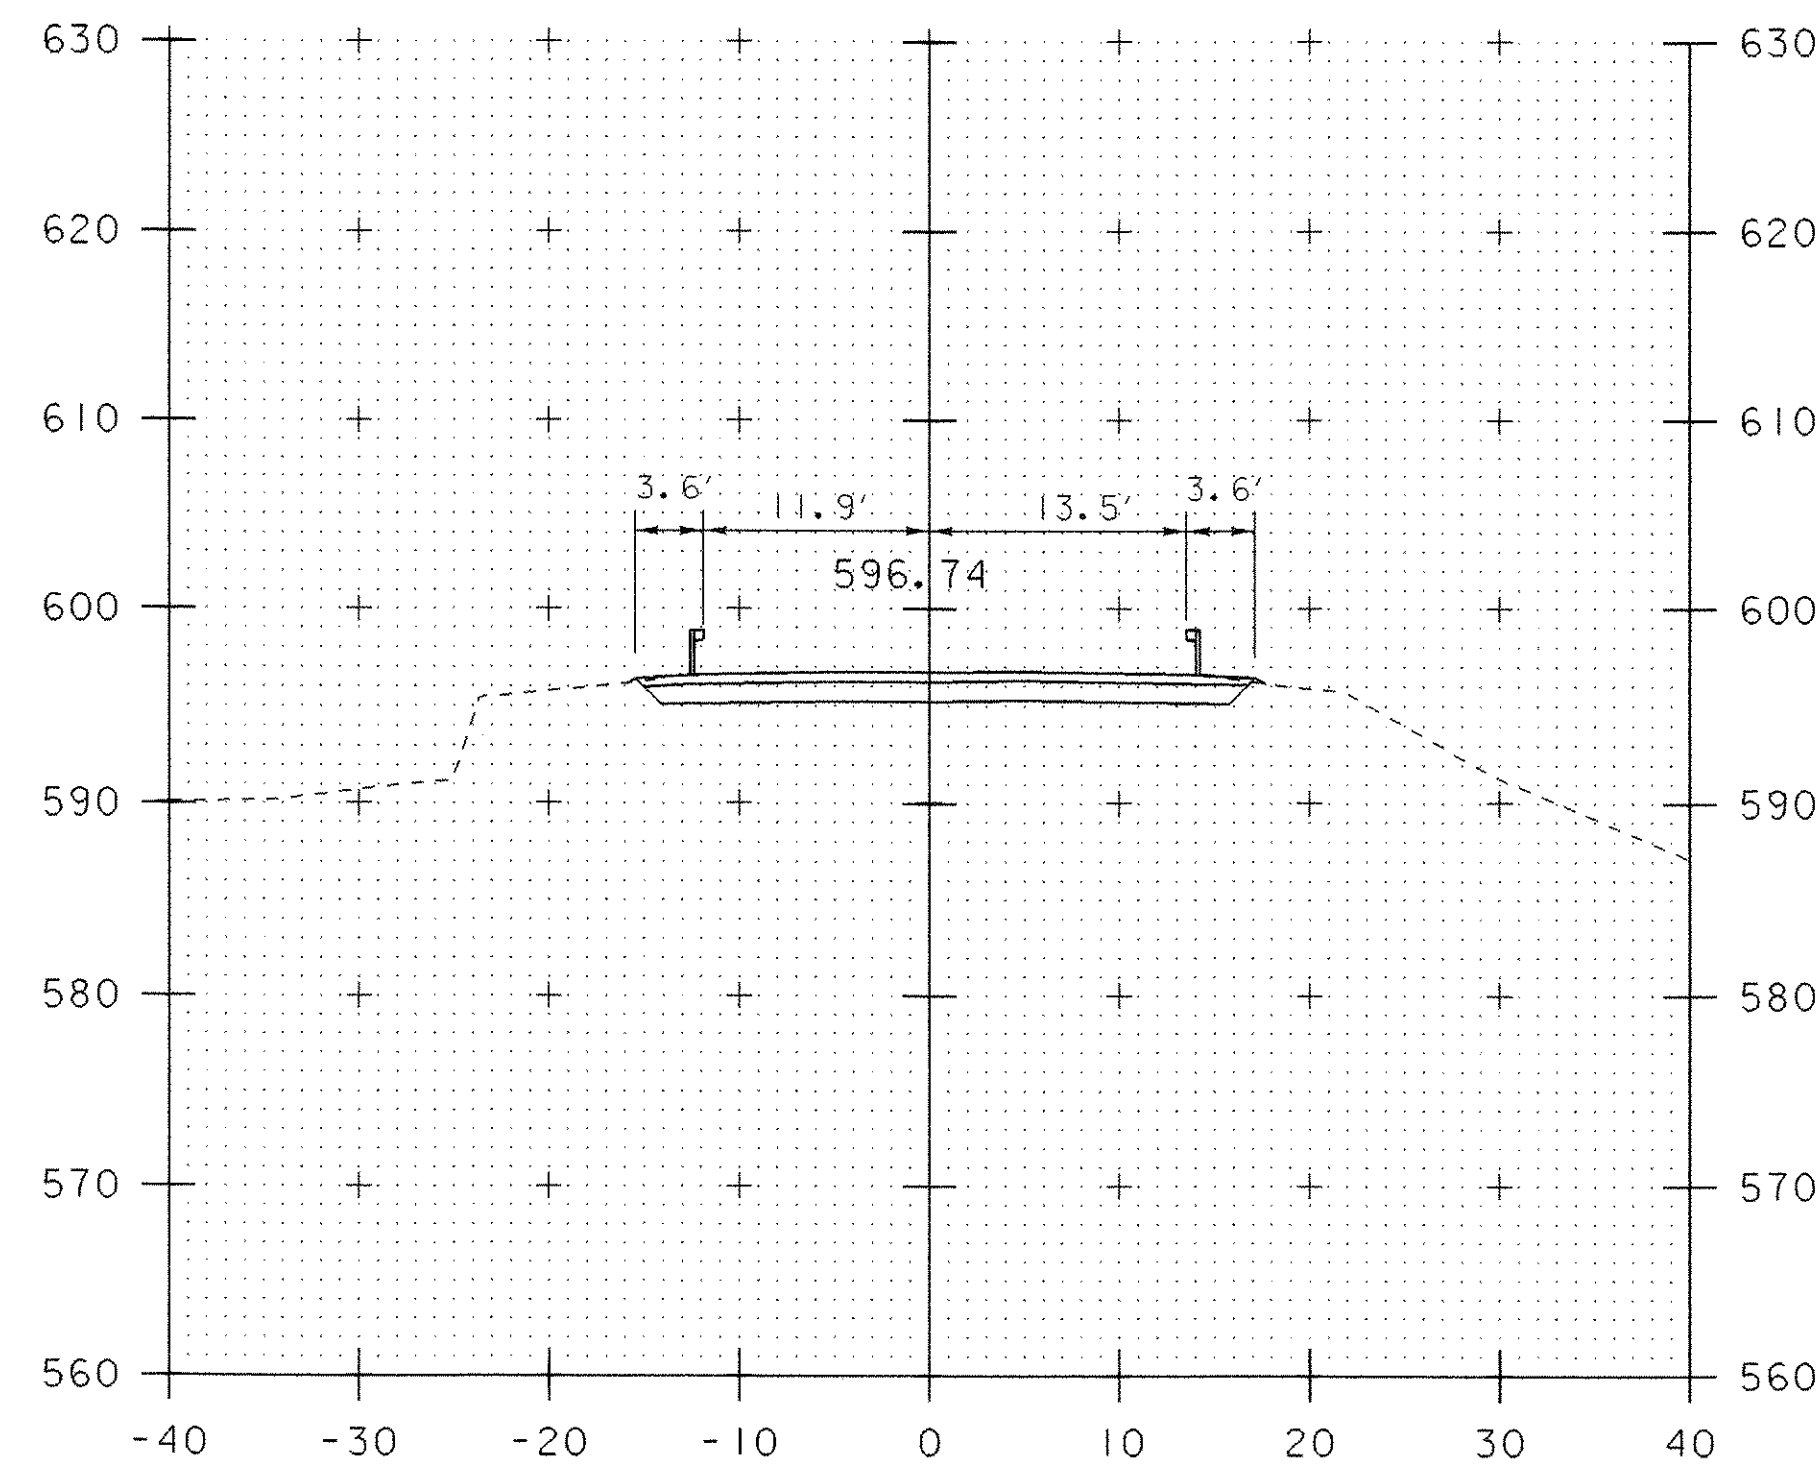


5+60

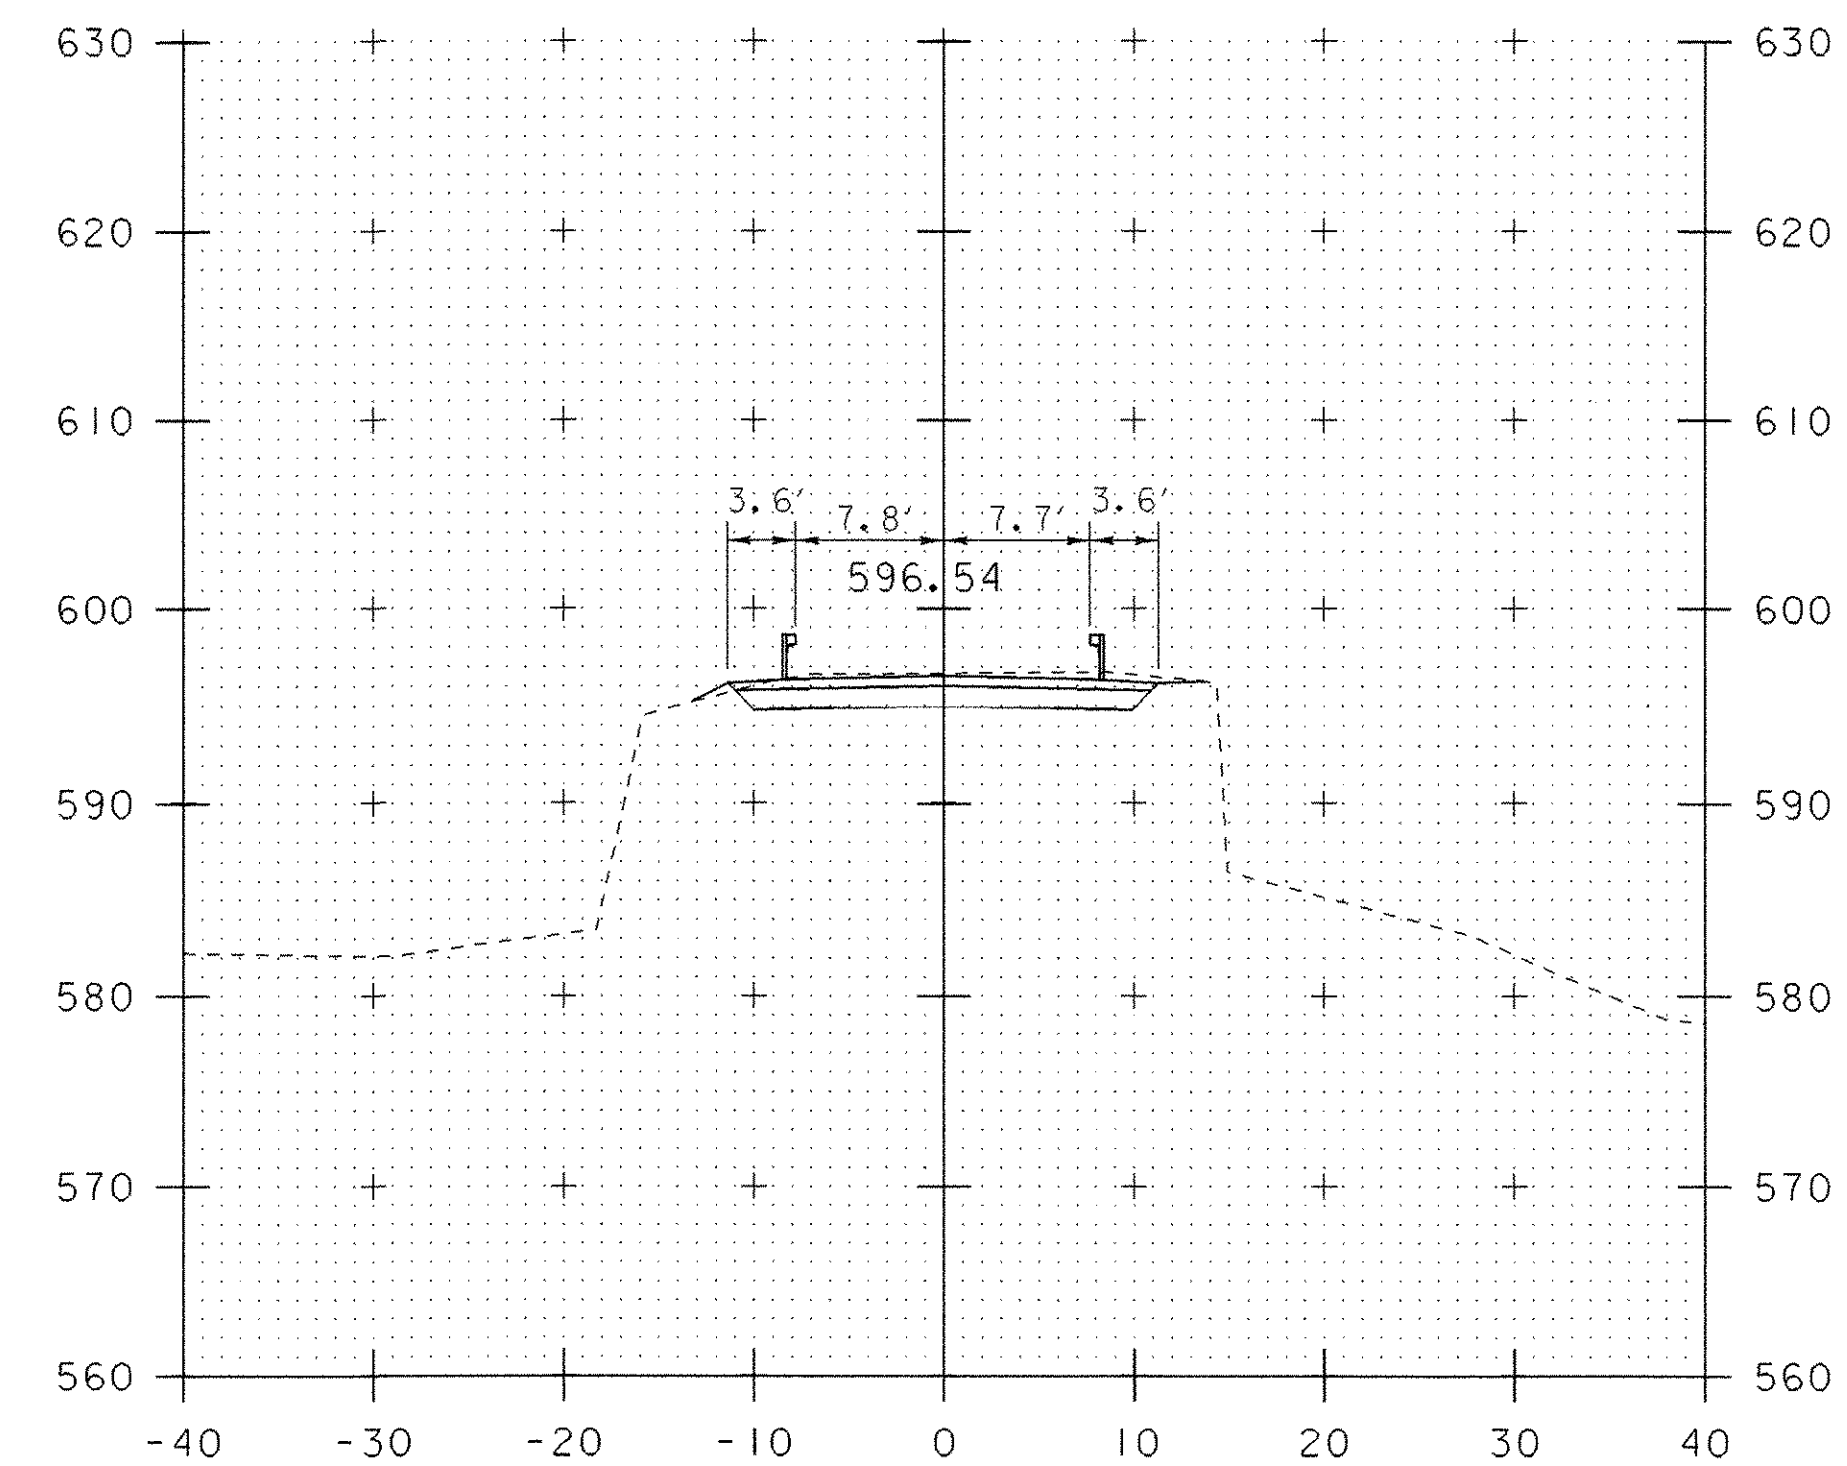


5+80


STA. 5+75  
BEGIN PROJECT

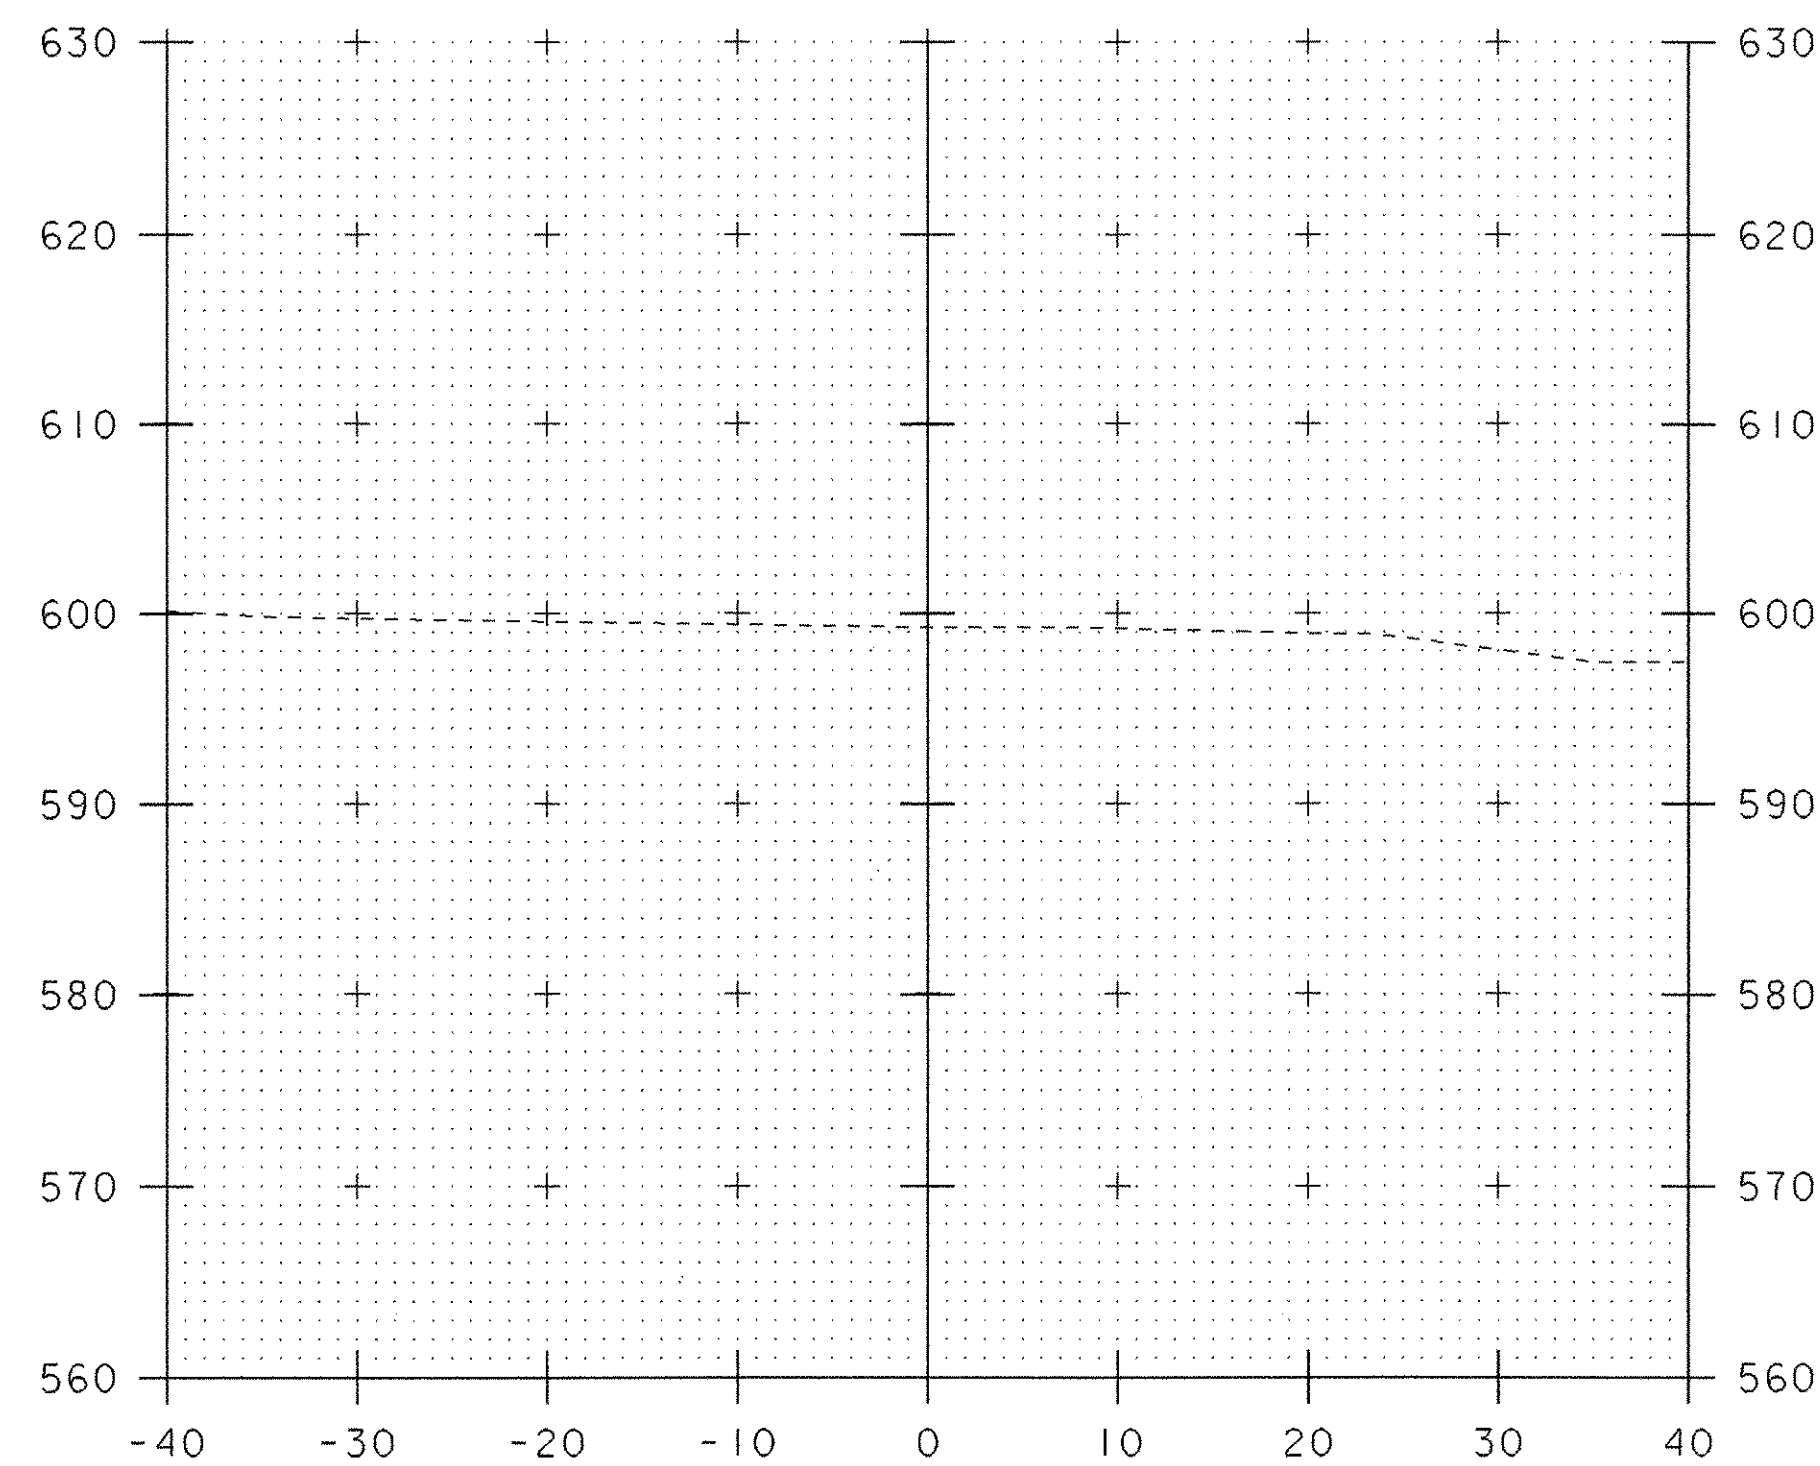


5+00

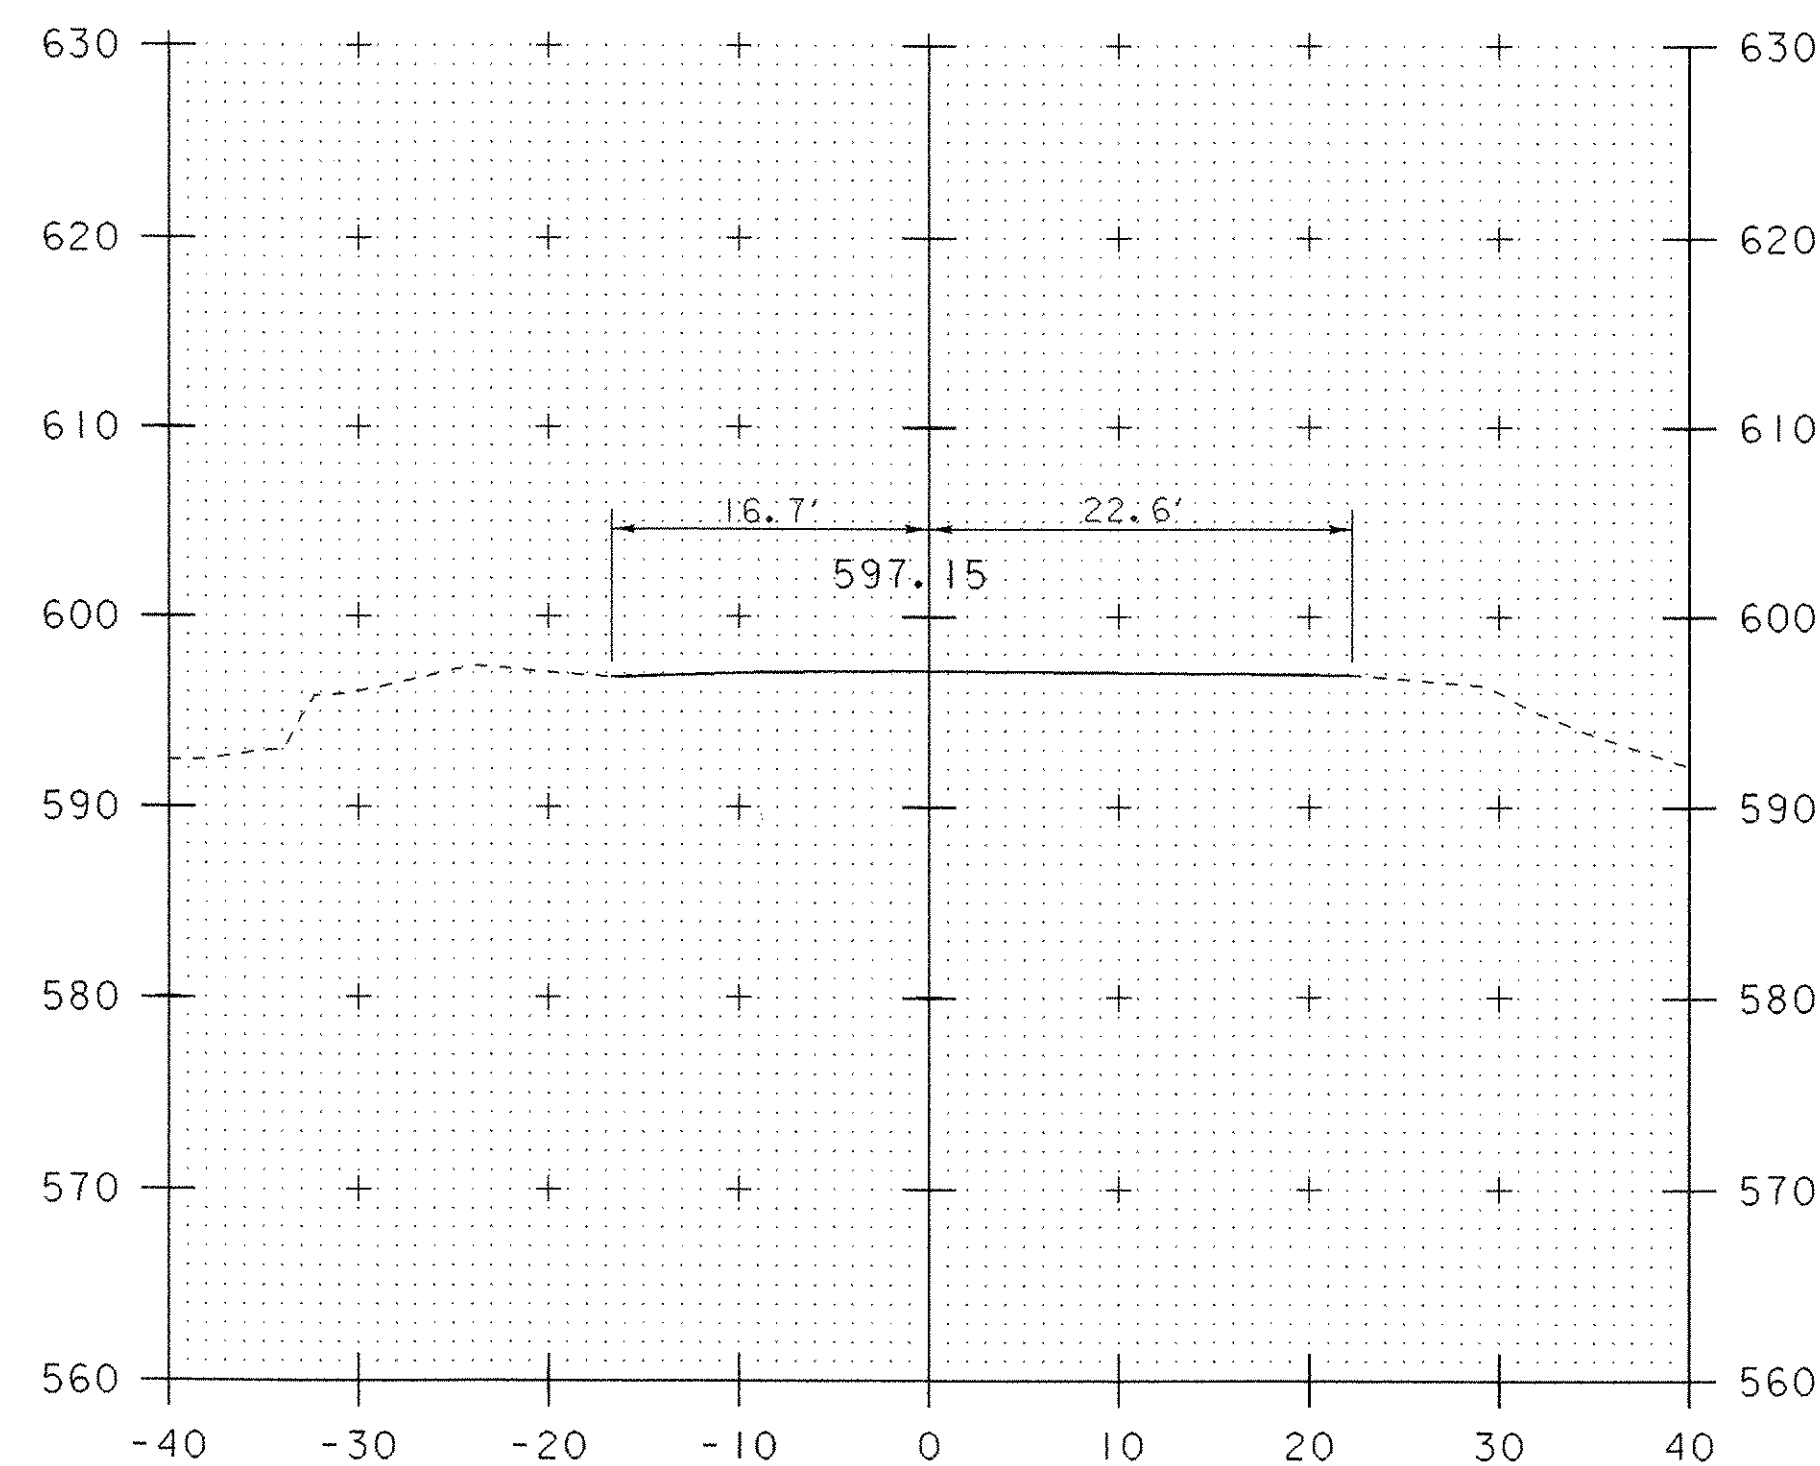

5+50  
BEGIN  
APPROACH

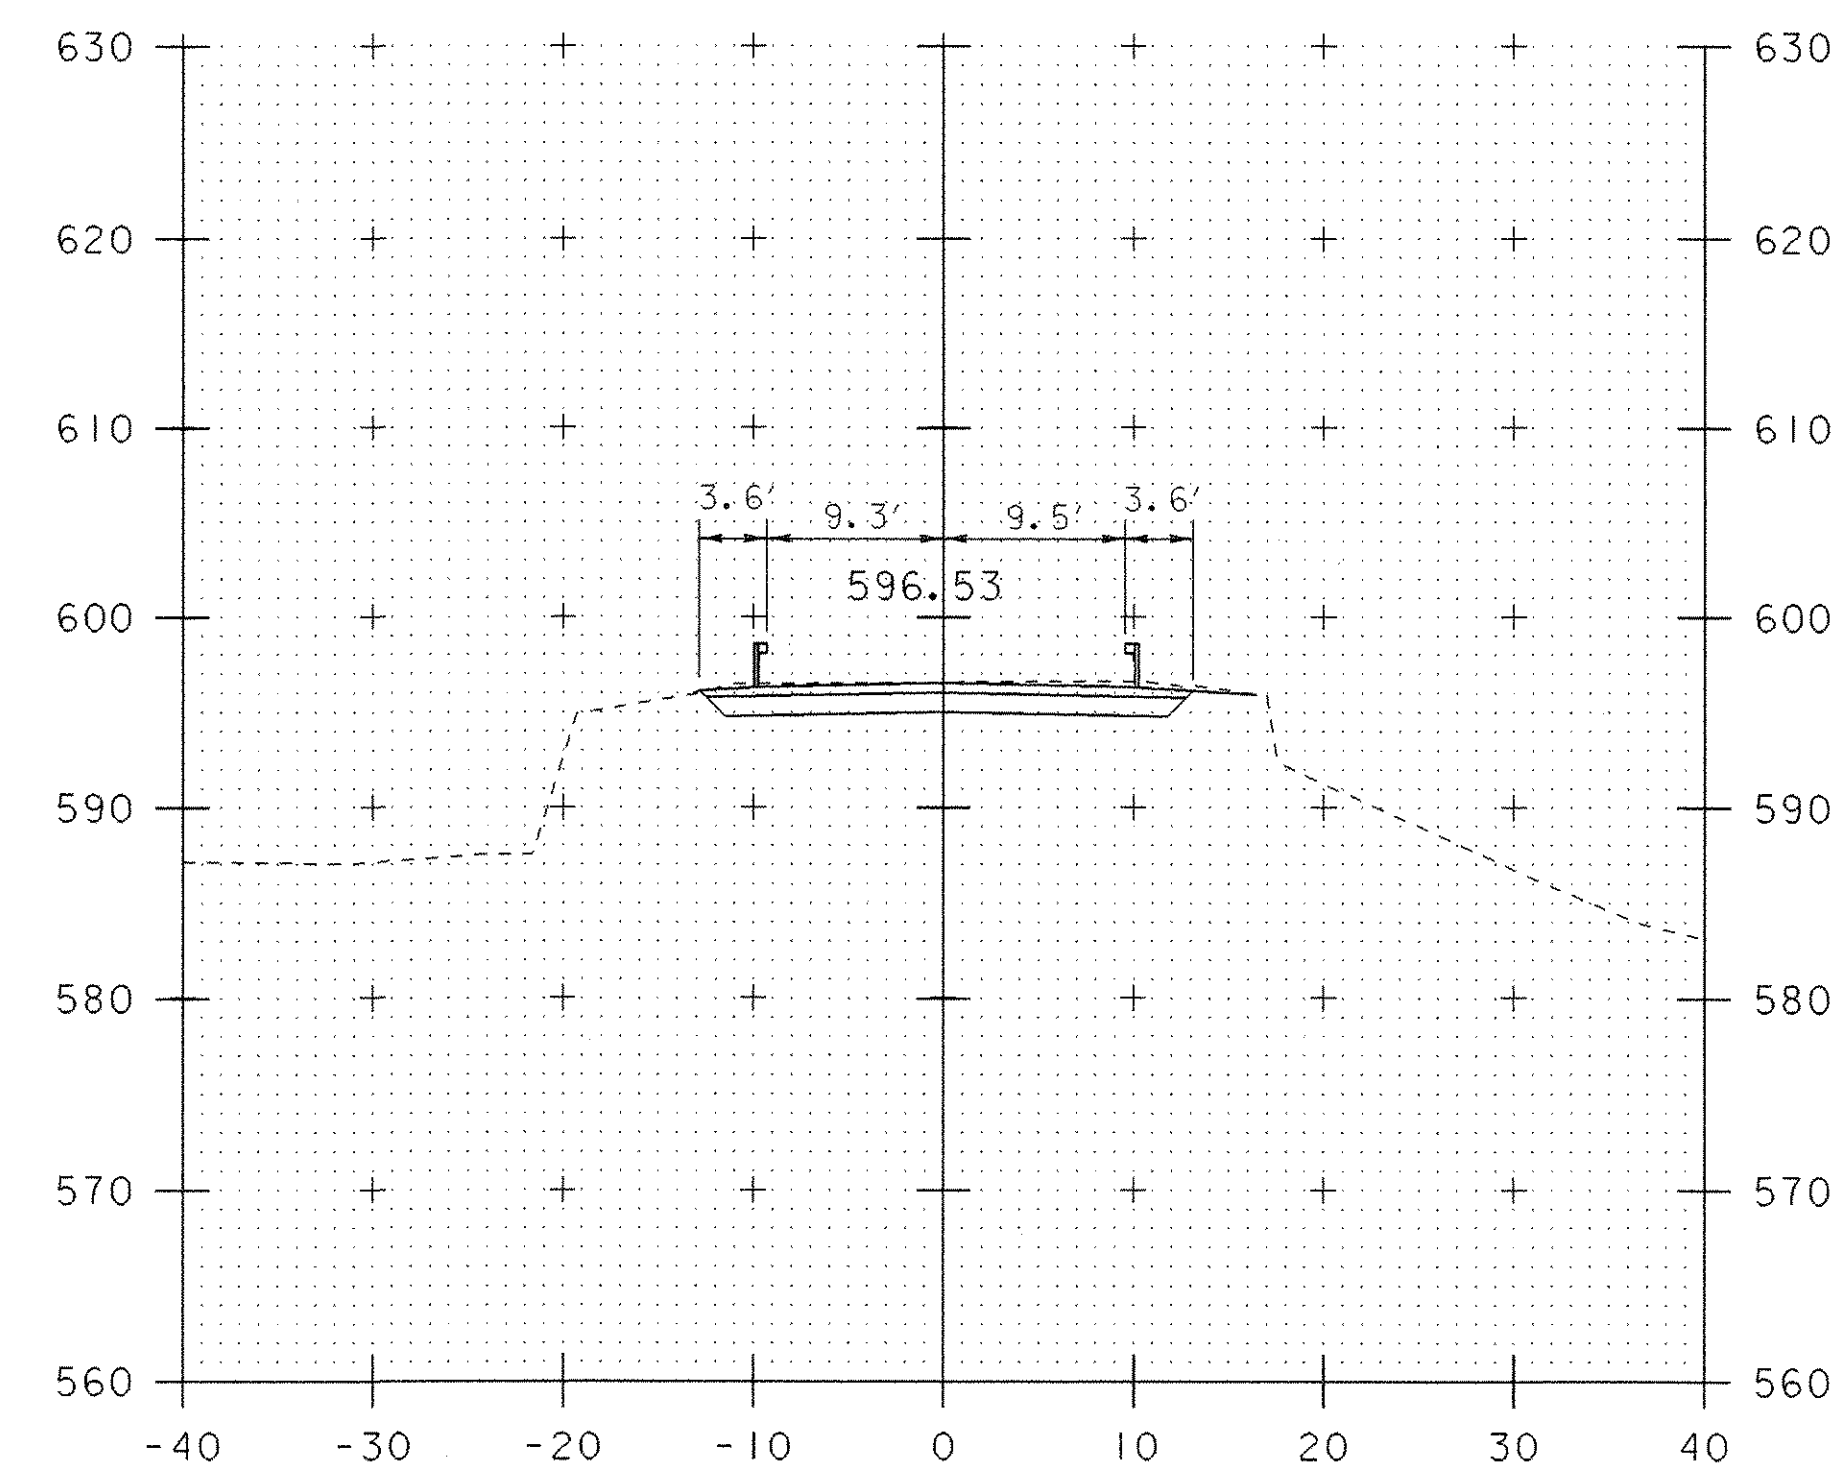

5+70

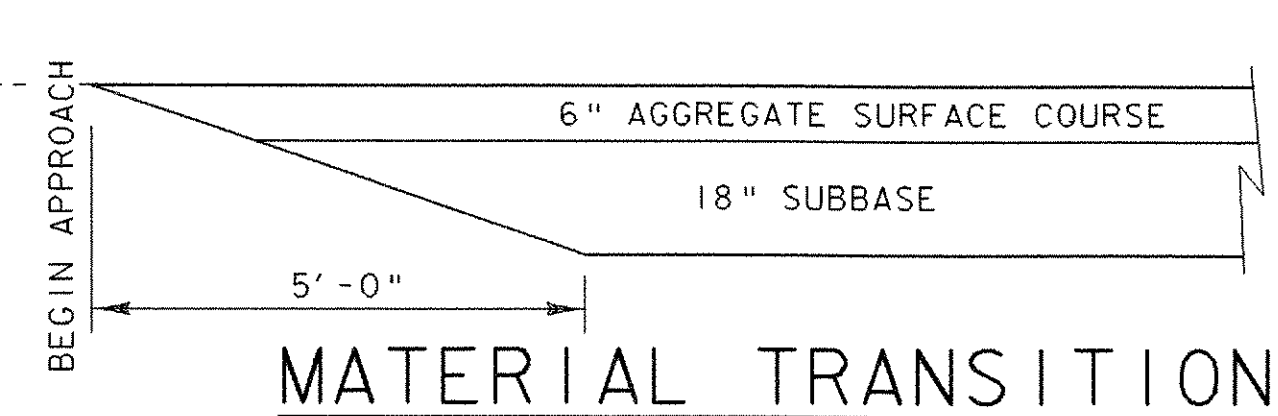

**MAINLINE SECTIONS**

STA. 5+00 TO STA. 5+80

PROJECT NAME: WEATHERSFIELD	PLOT DATE: 15-MAR-2007
PROJECT NUMBER: BHO 1442(29)	DRAWN BY: G. SHANGRAW
FILE NAME: /96j234/s+tr/s96j234xsl.dgn	DESIGNED BY: T. FILLBACH
PROJECT LEADER: W. SYMONDS	CHECKED BY: T. SUMNER
sj234mxi.l	SHEET 51 OF 60