



6+00

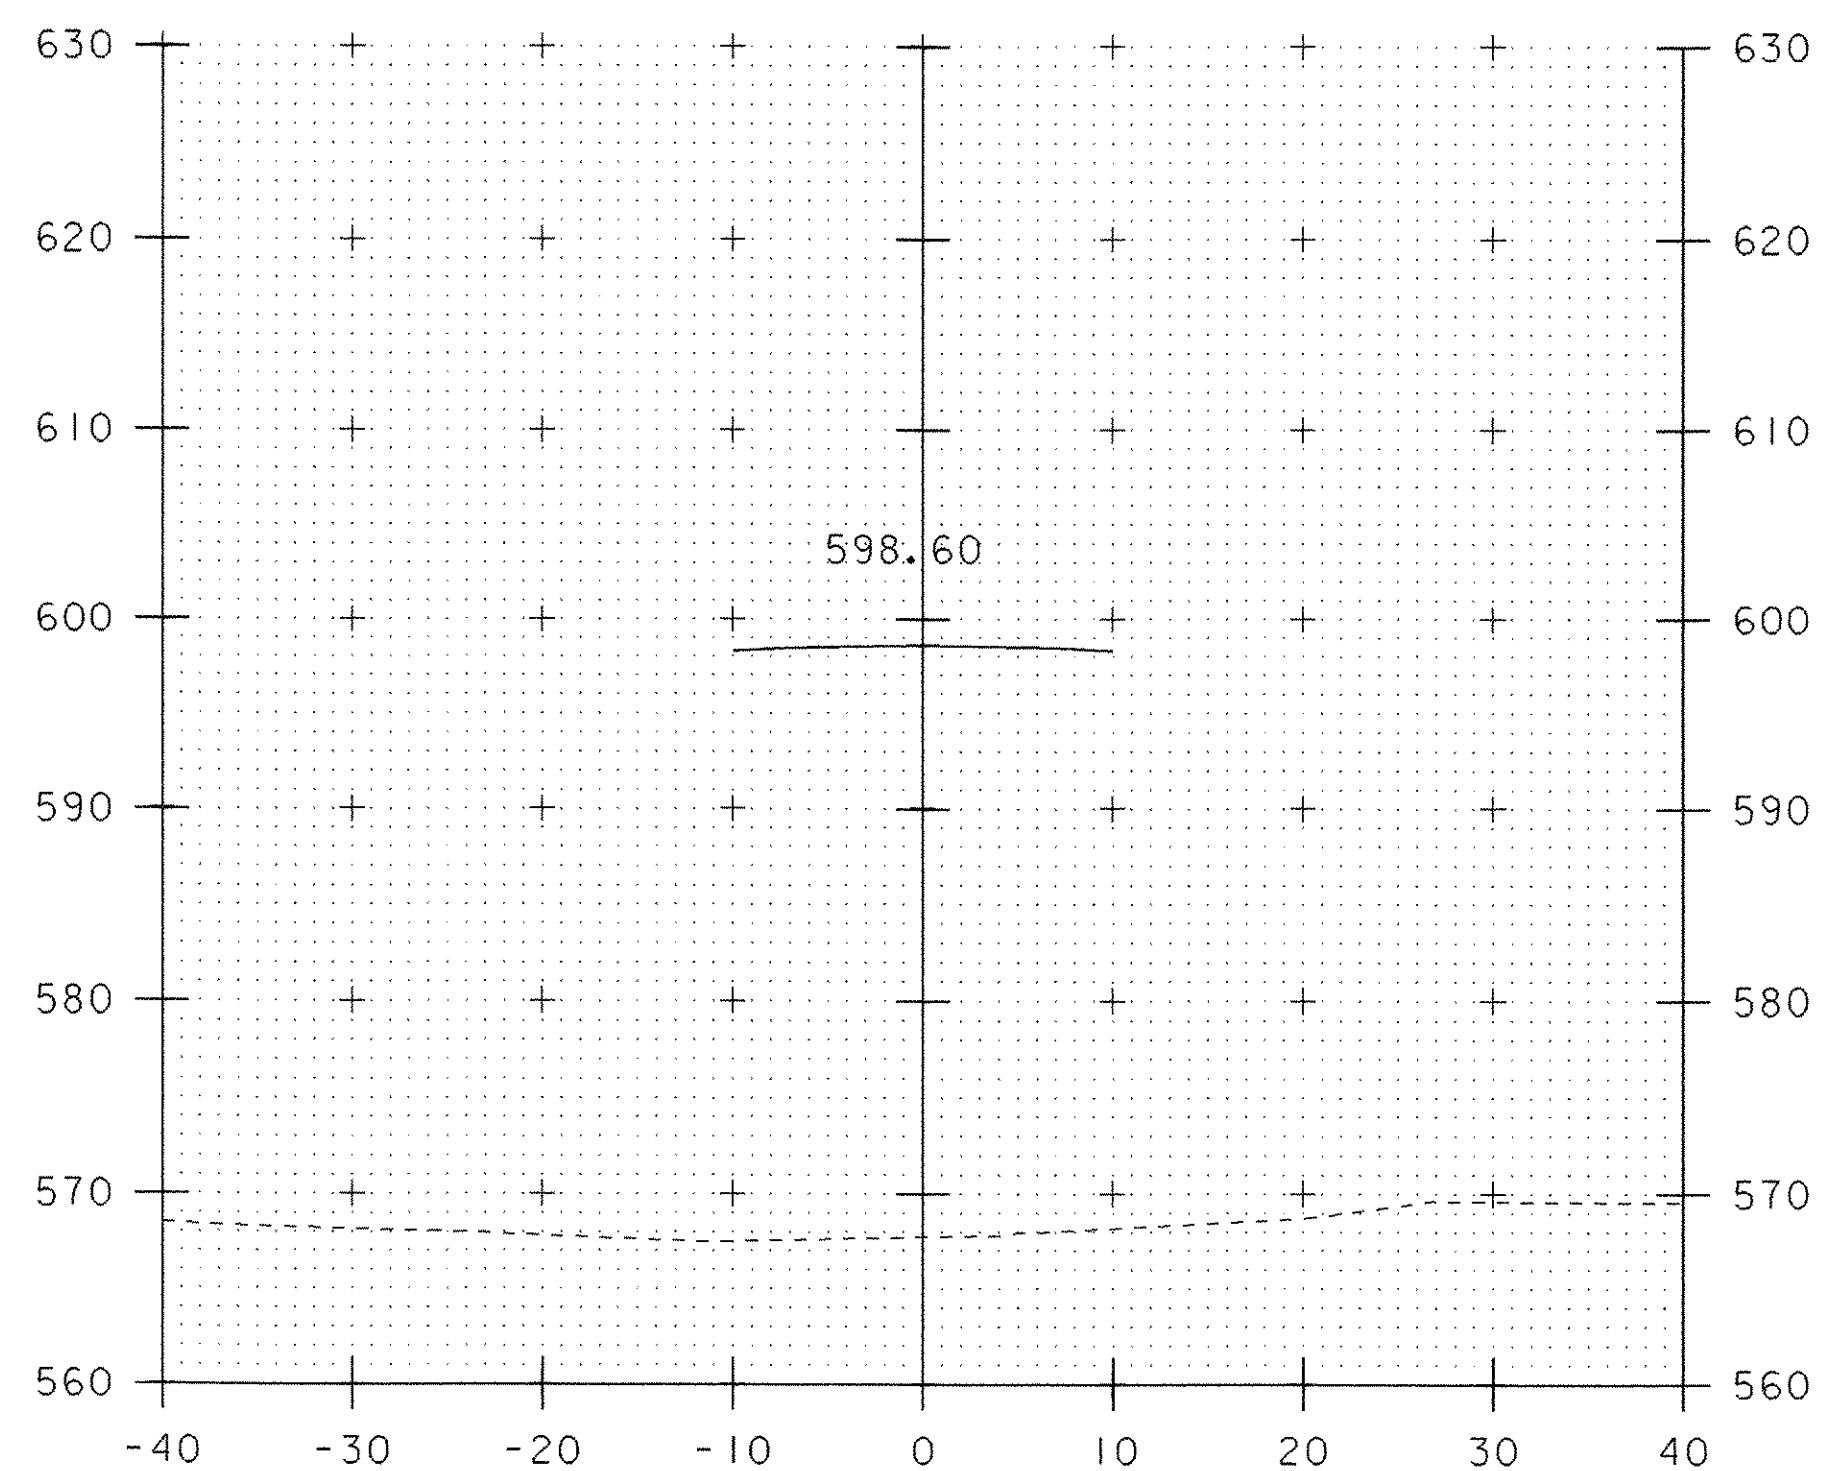


7+00

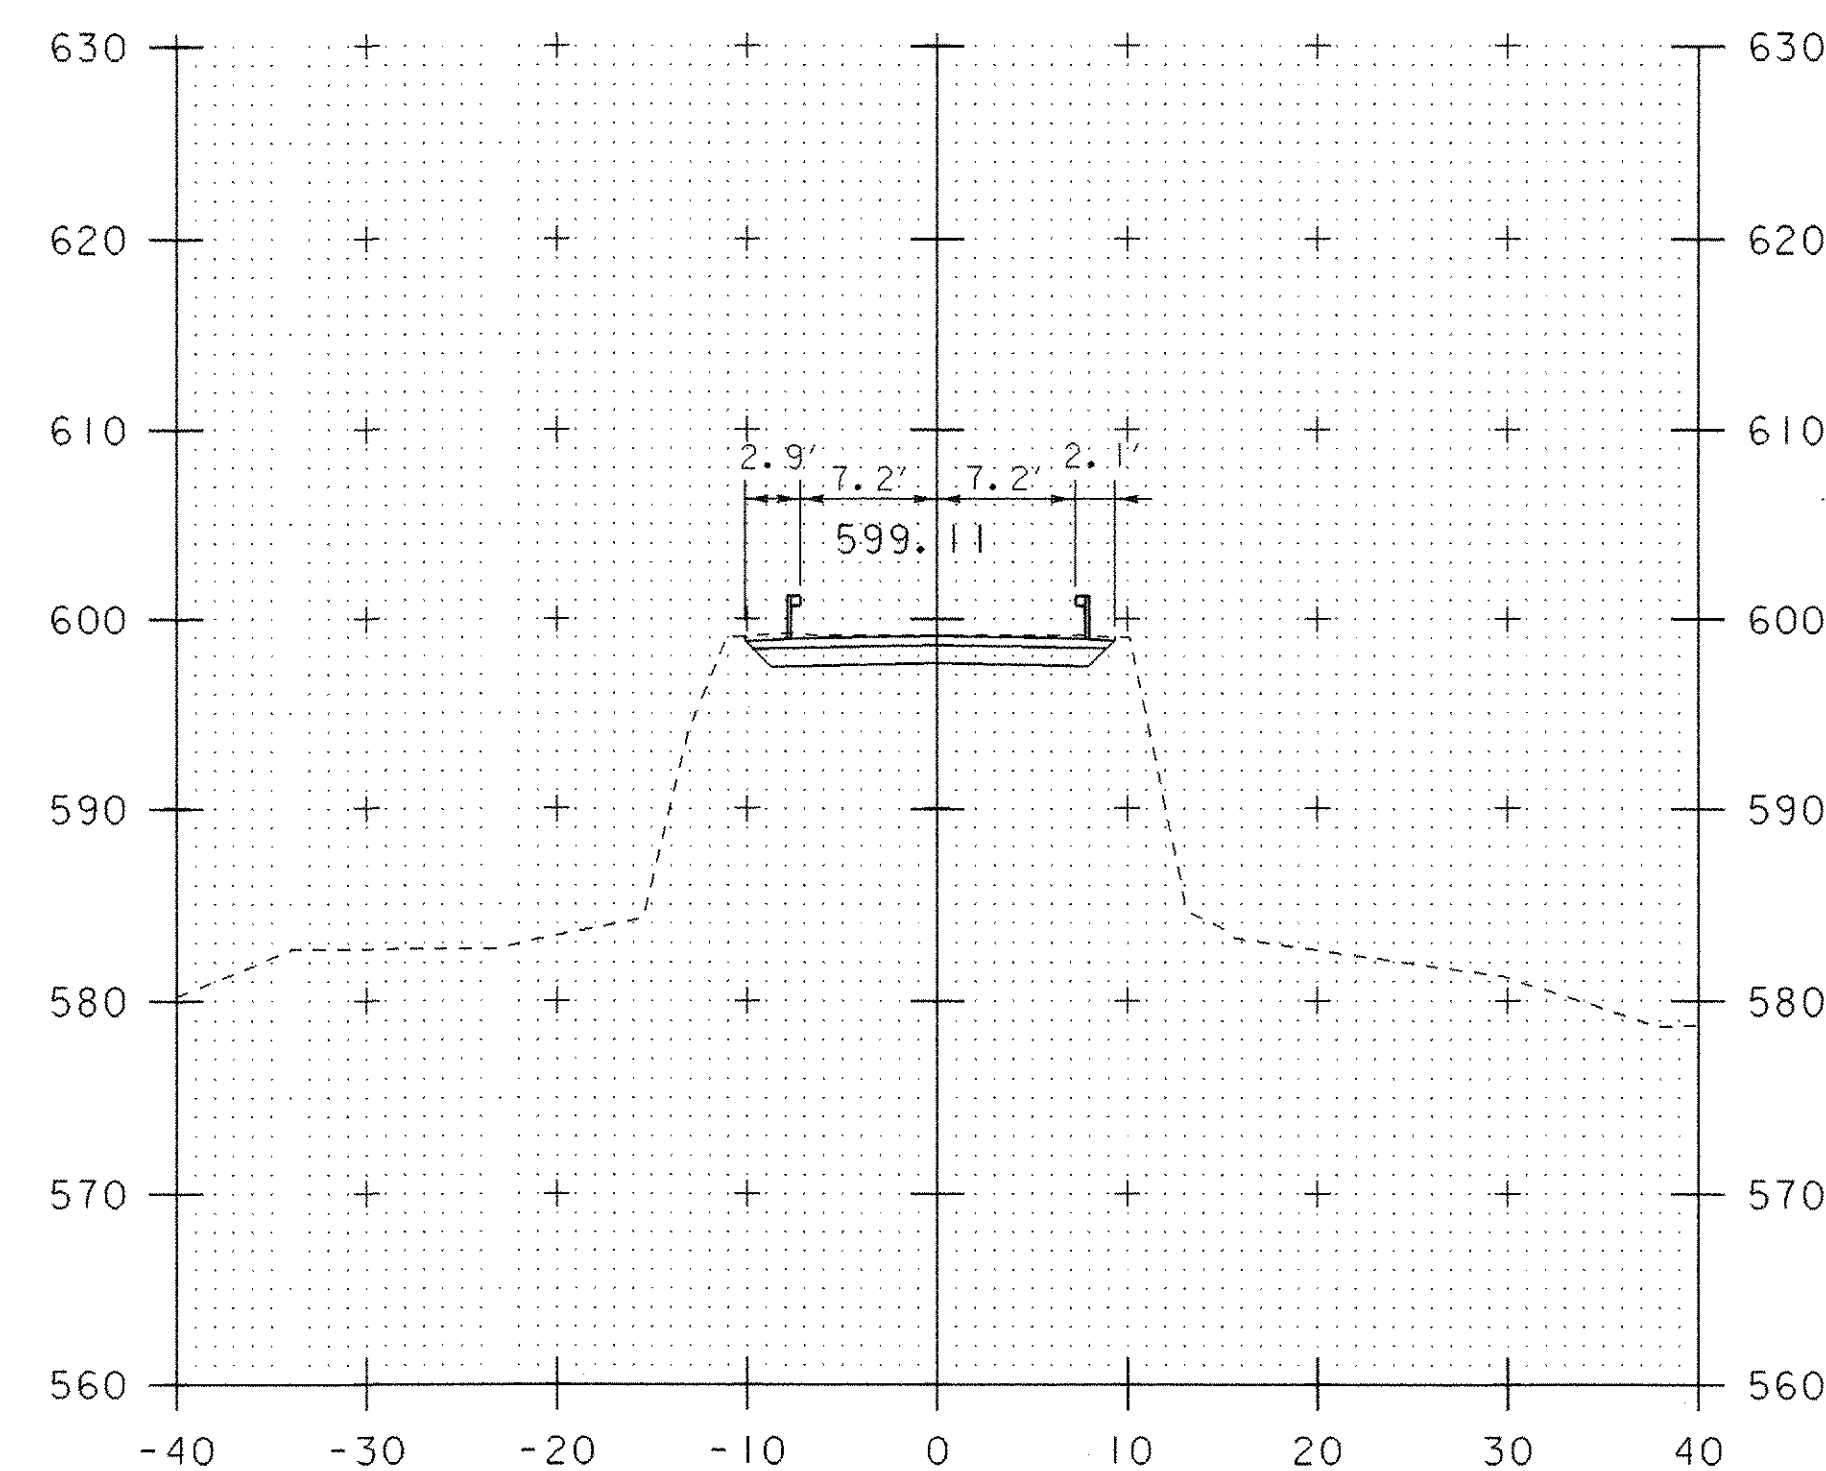


7+30


STA 7+28.12
END BRIDGE

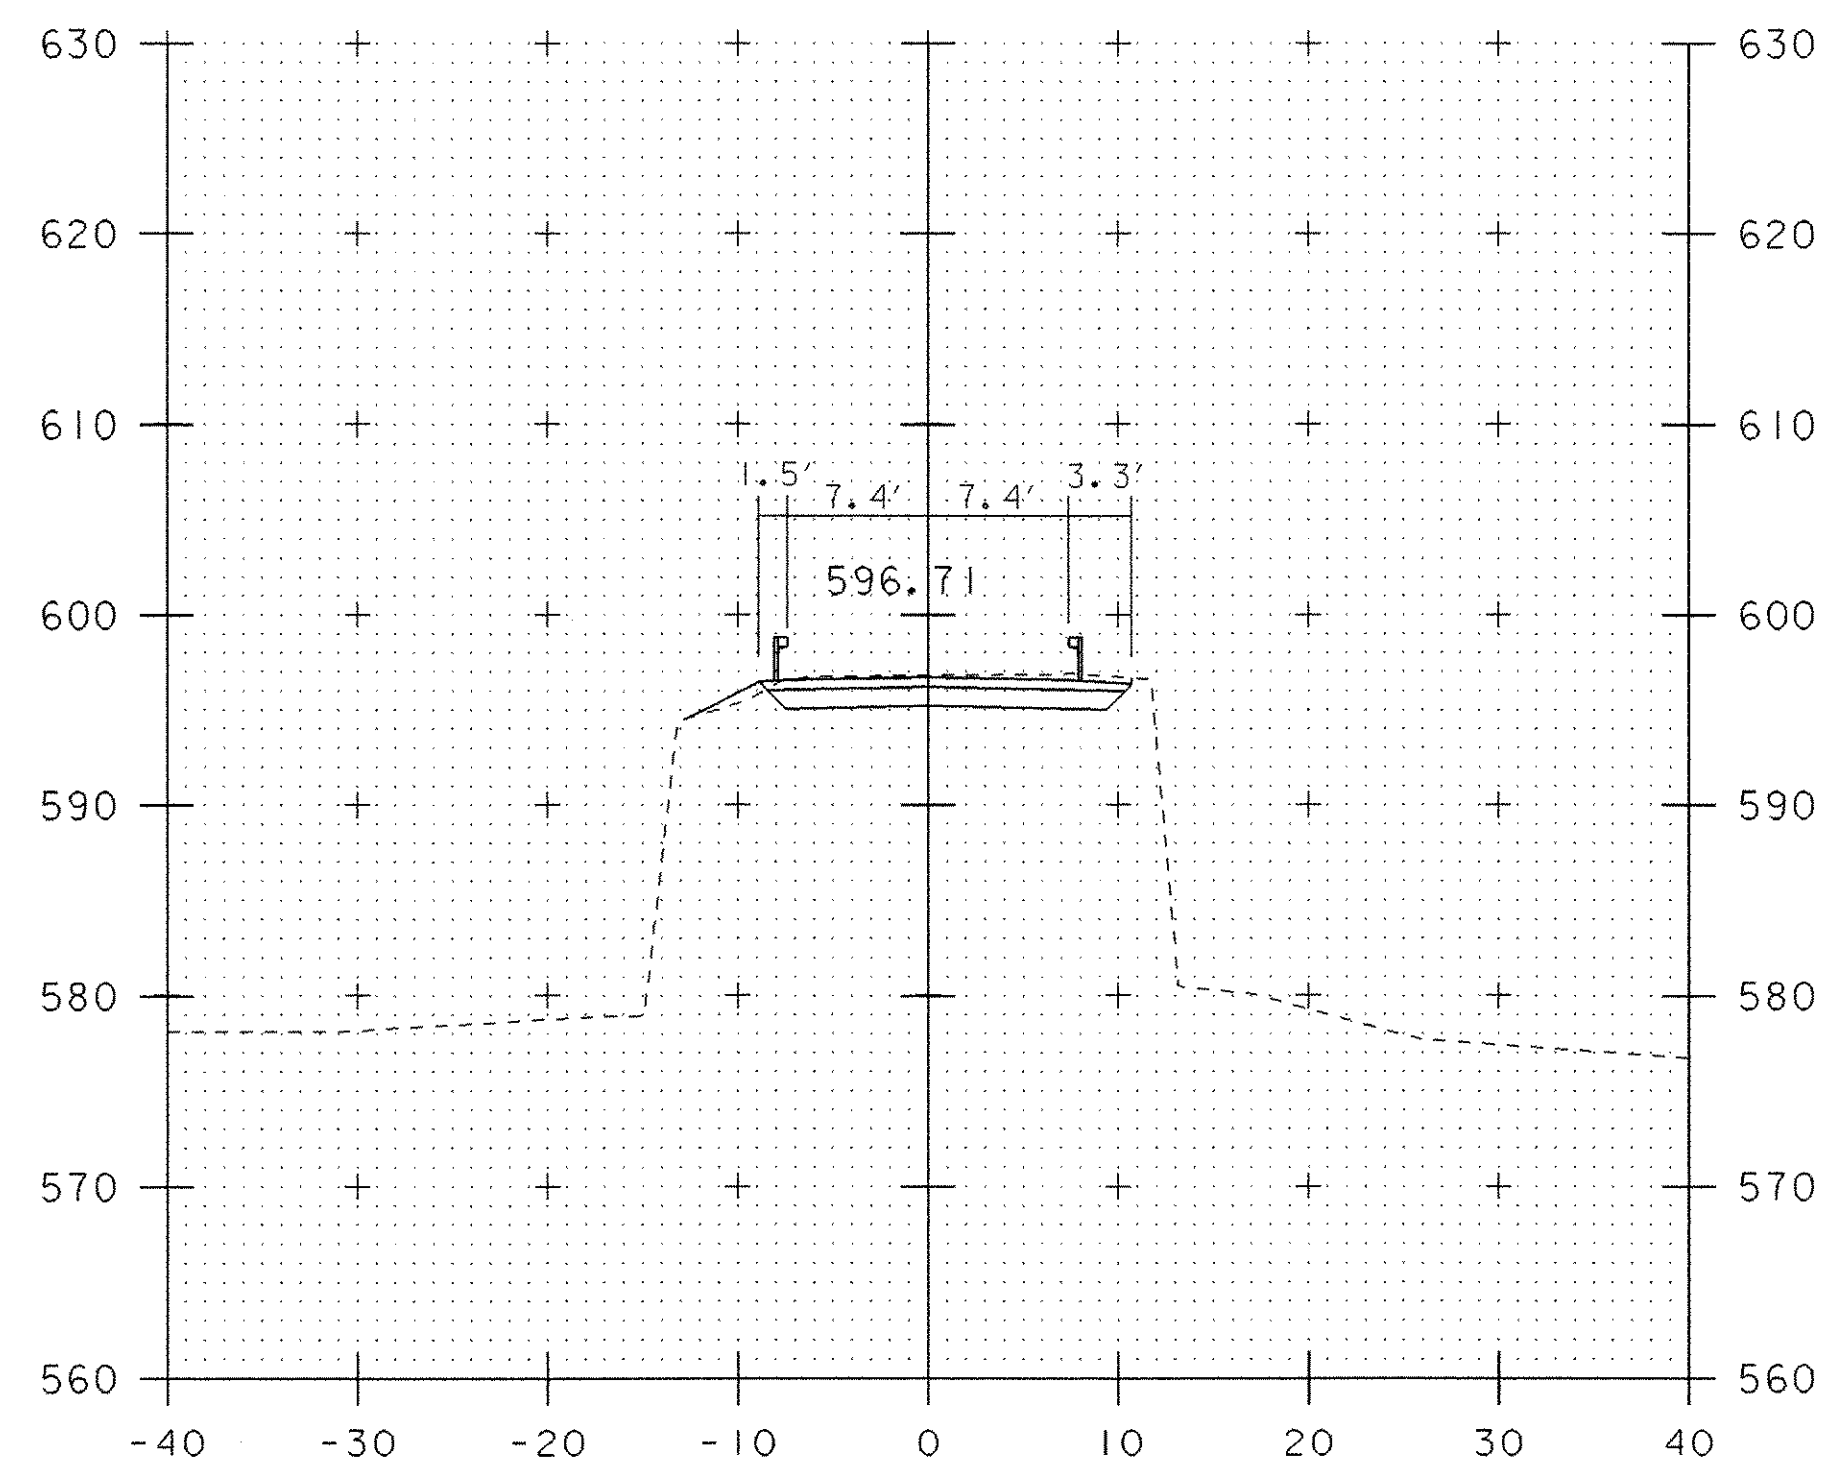

5+90

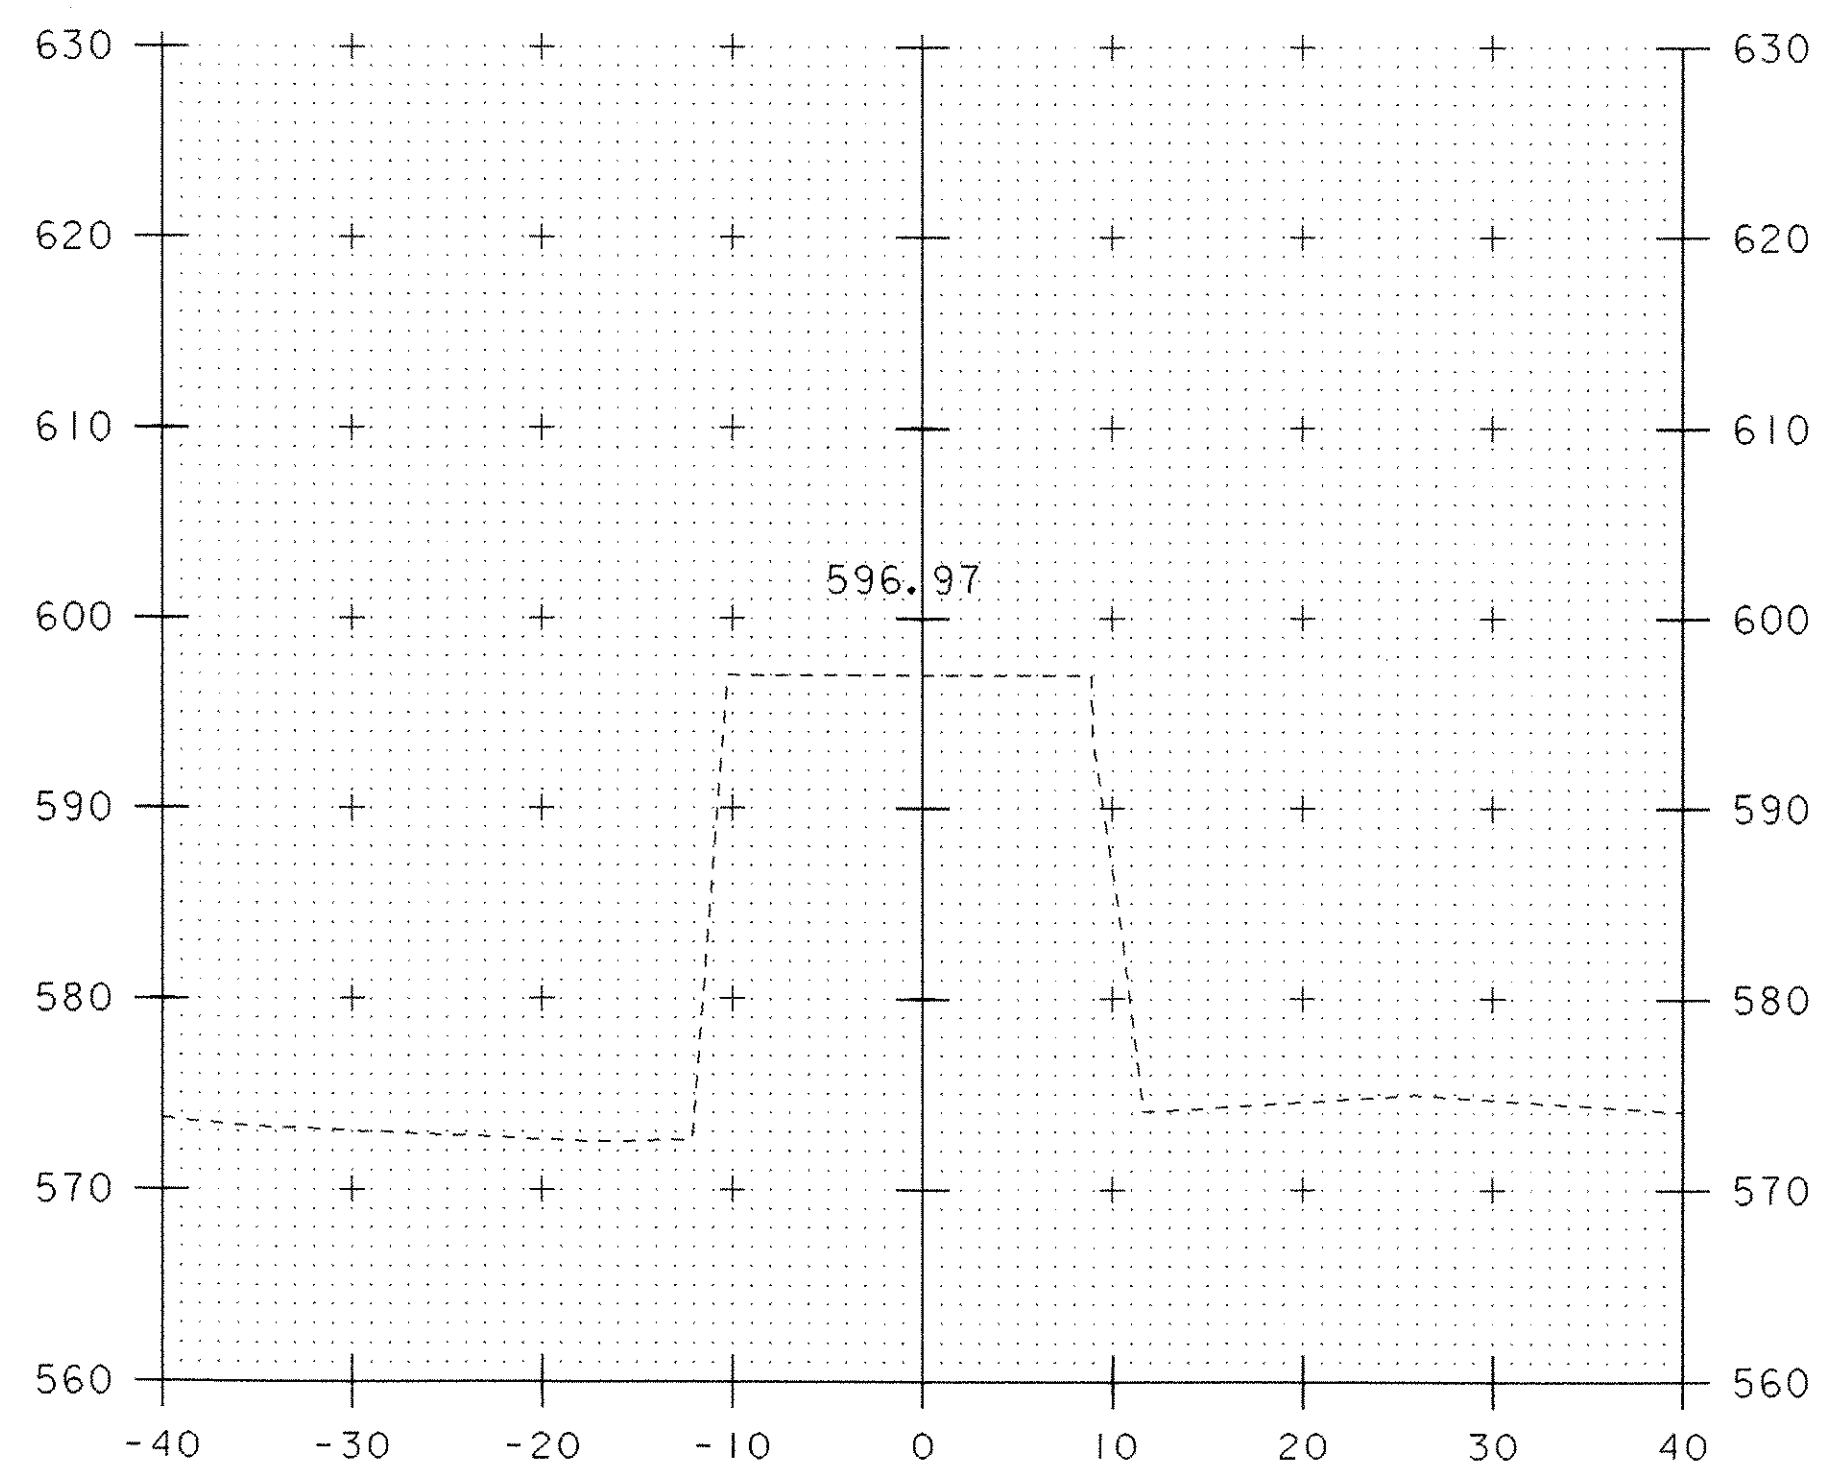

6+05
BEGIN
BRIDGE

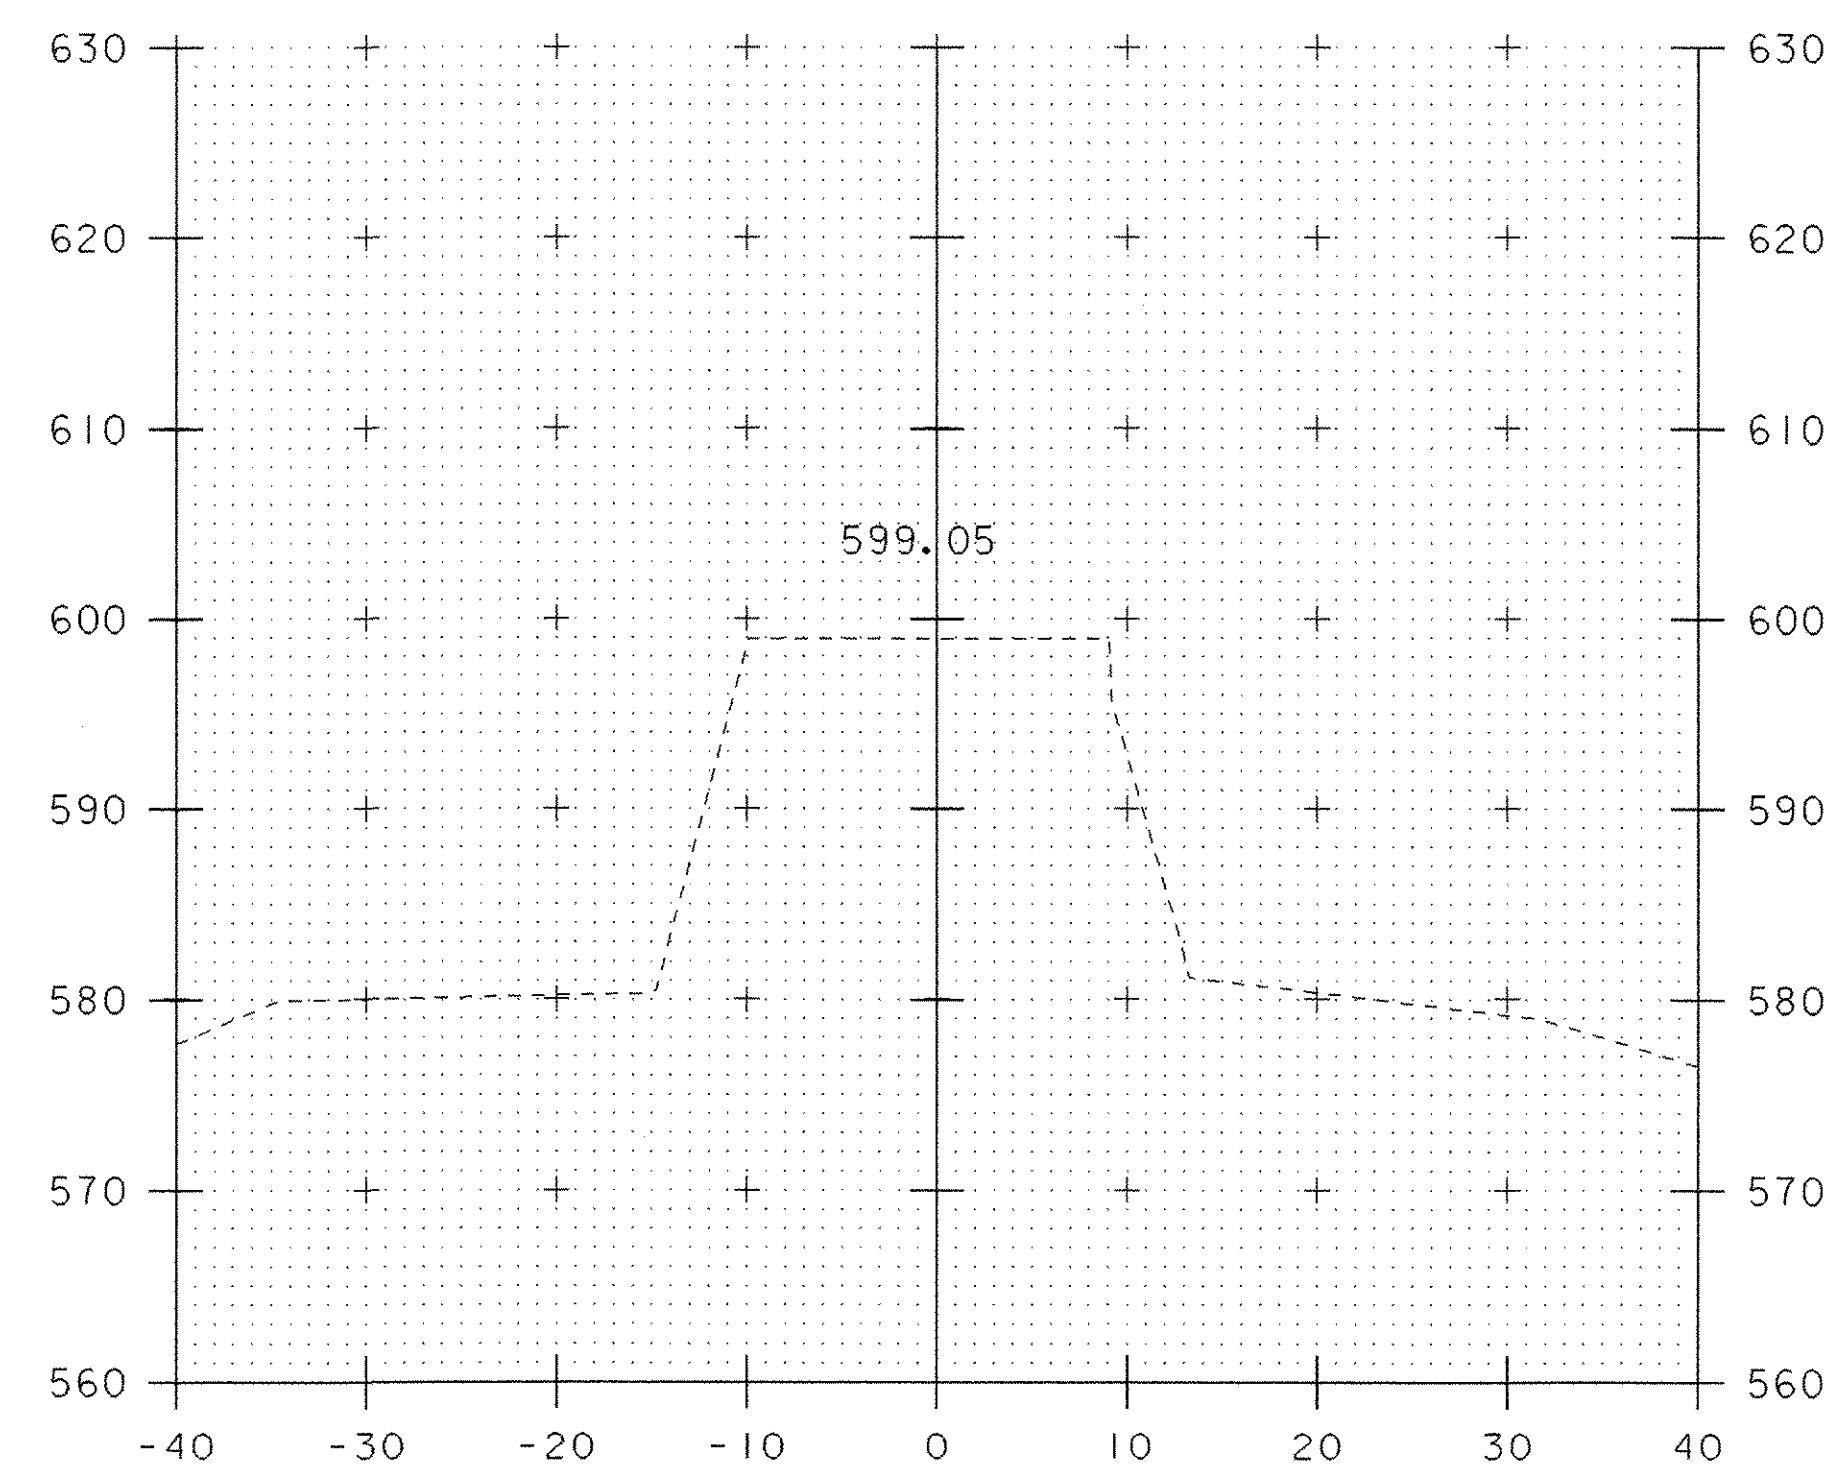

7+25.75

MAINLINE SECTIONS

PROJECT NAME:	WEATHERSFIELD	PLOT DATE:	I5-MAR-2007
PROJECT NUMBER:	BHO 1442(29)	DRAWN BY:	G. SHANGRAW
FILE NAME:	/96j234/str/s96j234xsl.dgn	DESIGNED BY:	T. FILLBACH
PROJECT LEADER:	W. SYMONDS	CHECKED BY:	T. SUMNER
DESIGNED BY:	T. FILLBACH	SHEET	52 OF 60

STA. 5+90 TO STA. 7+30