



10+00

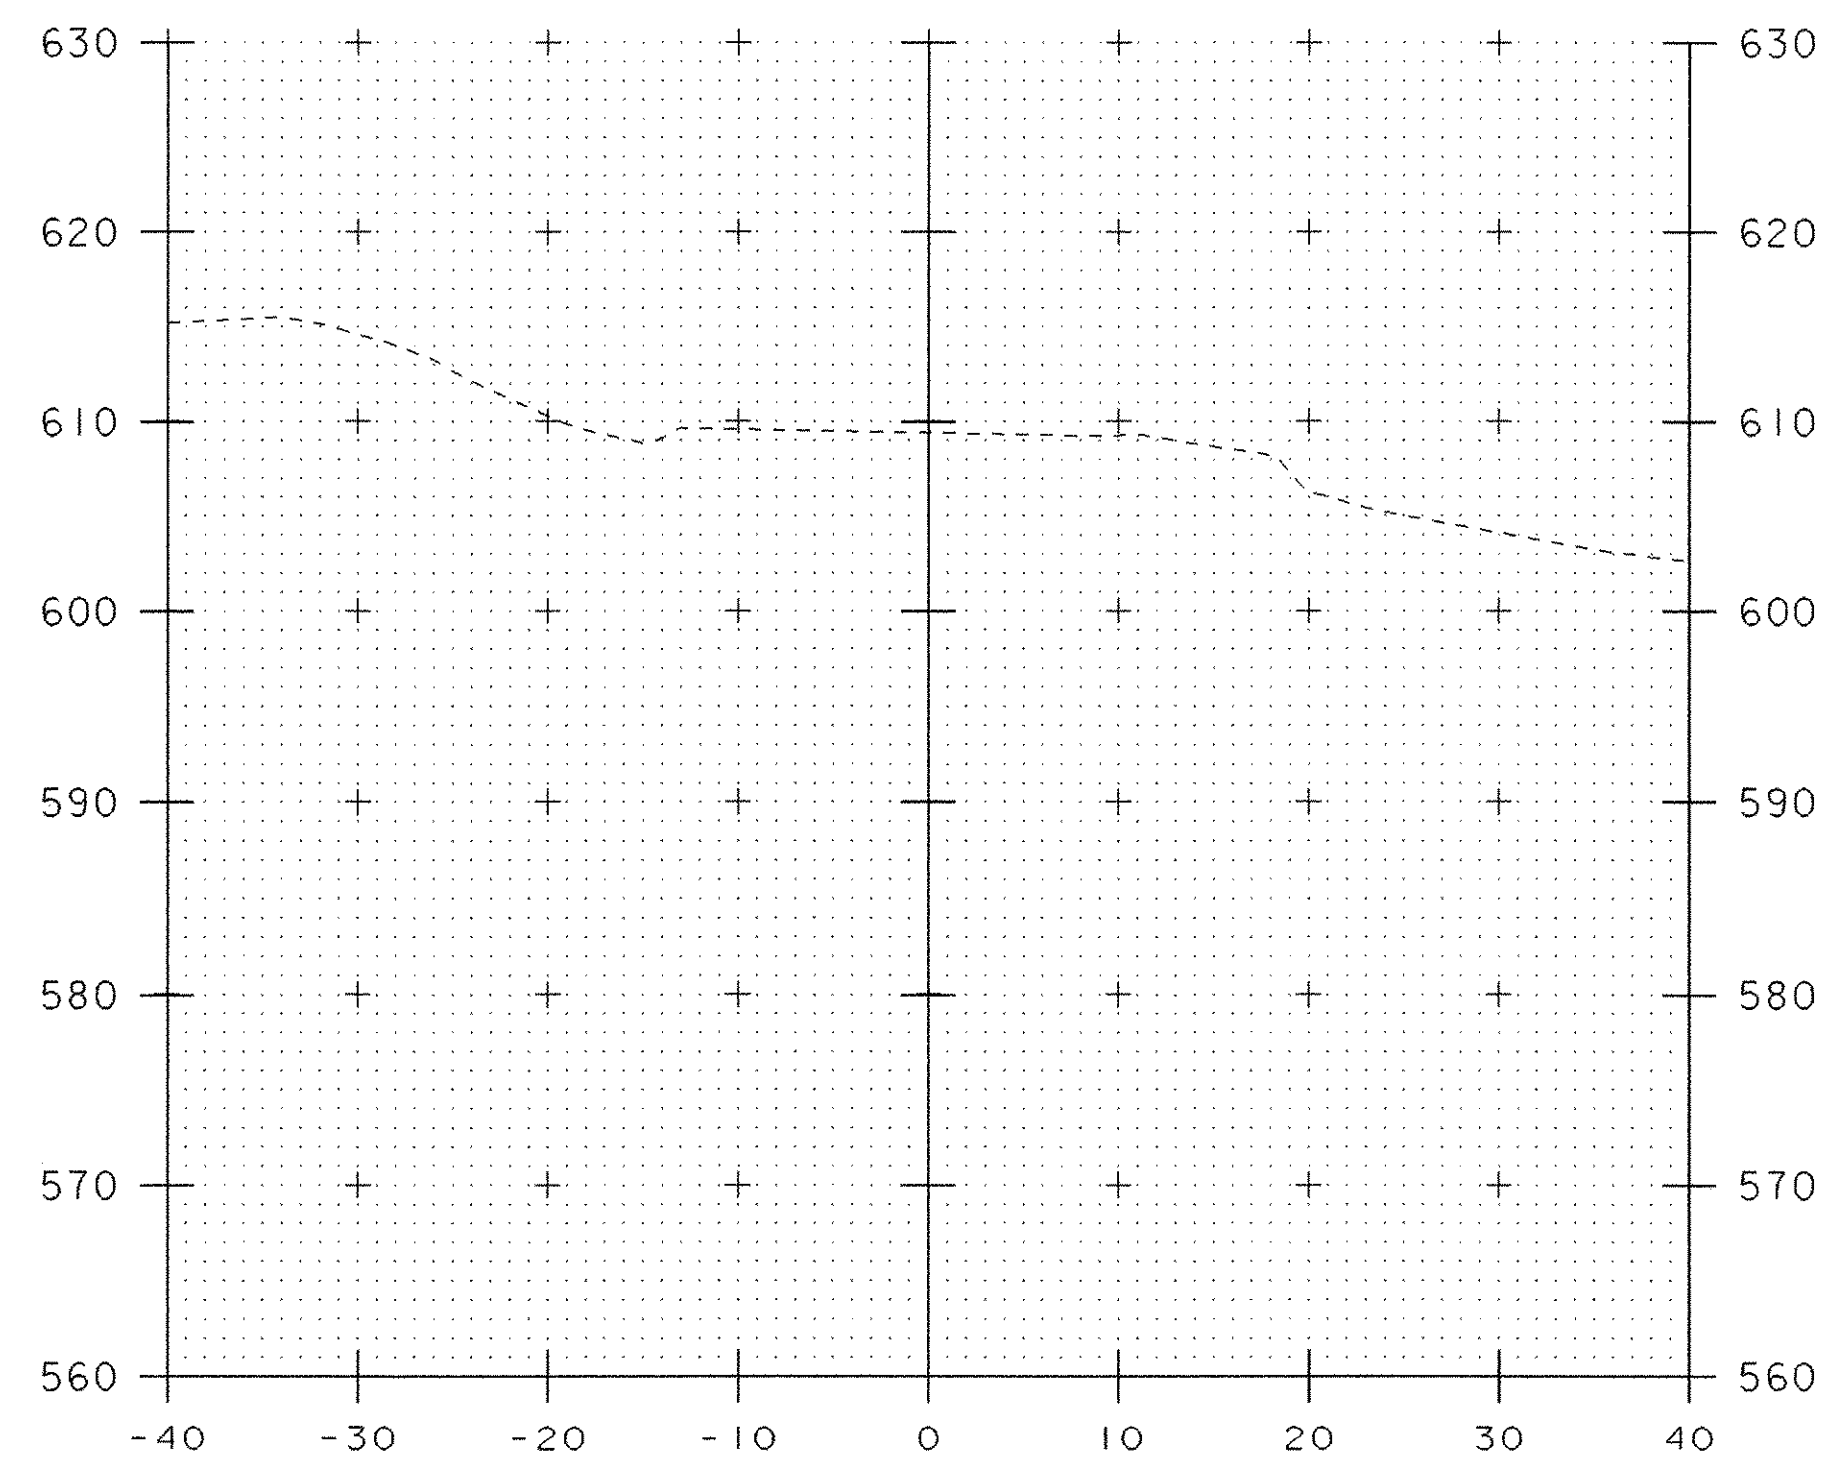

9+00

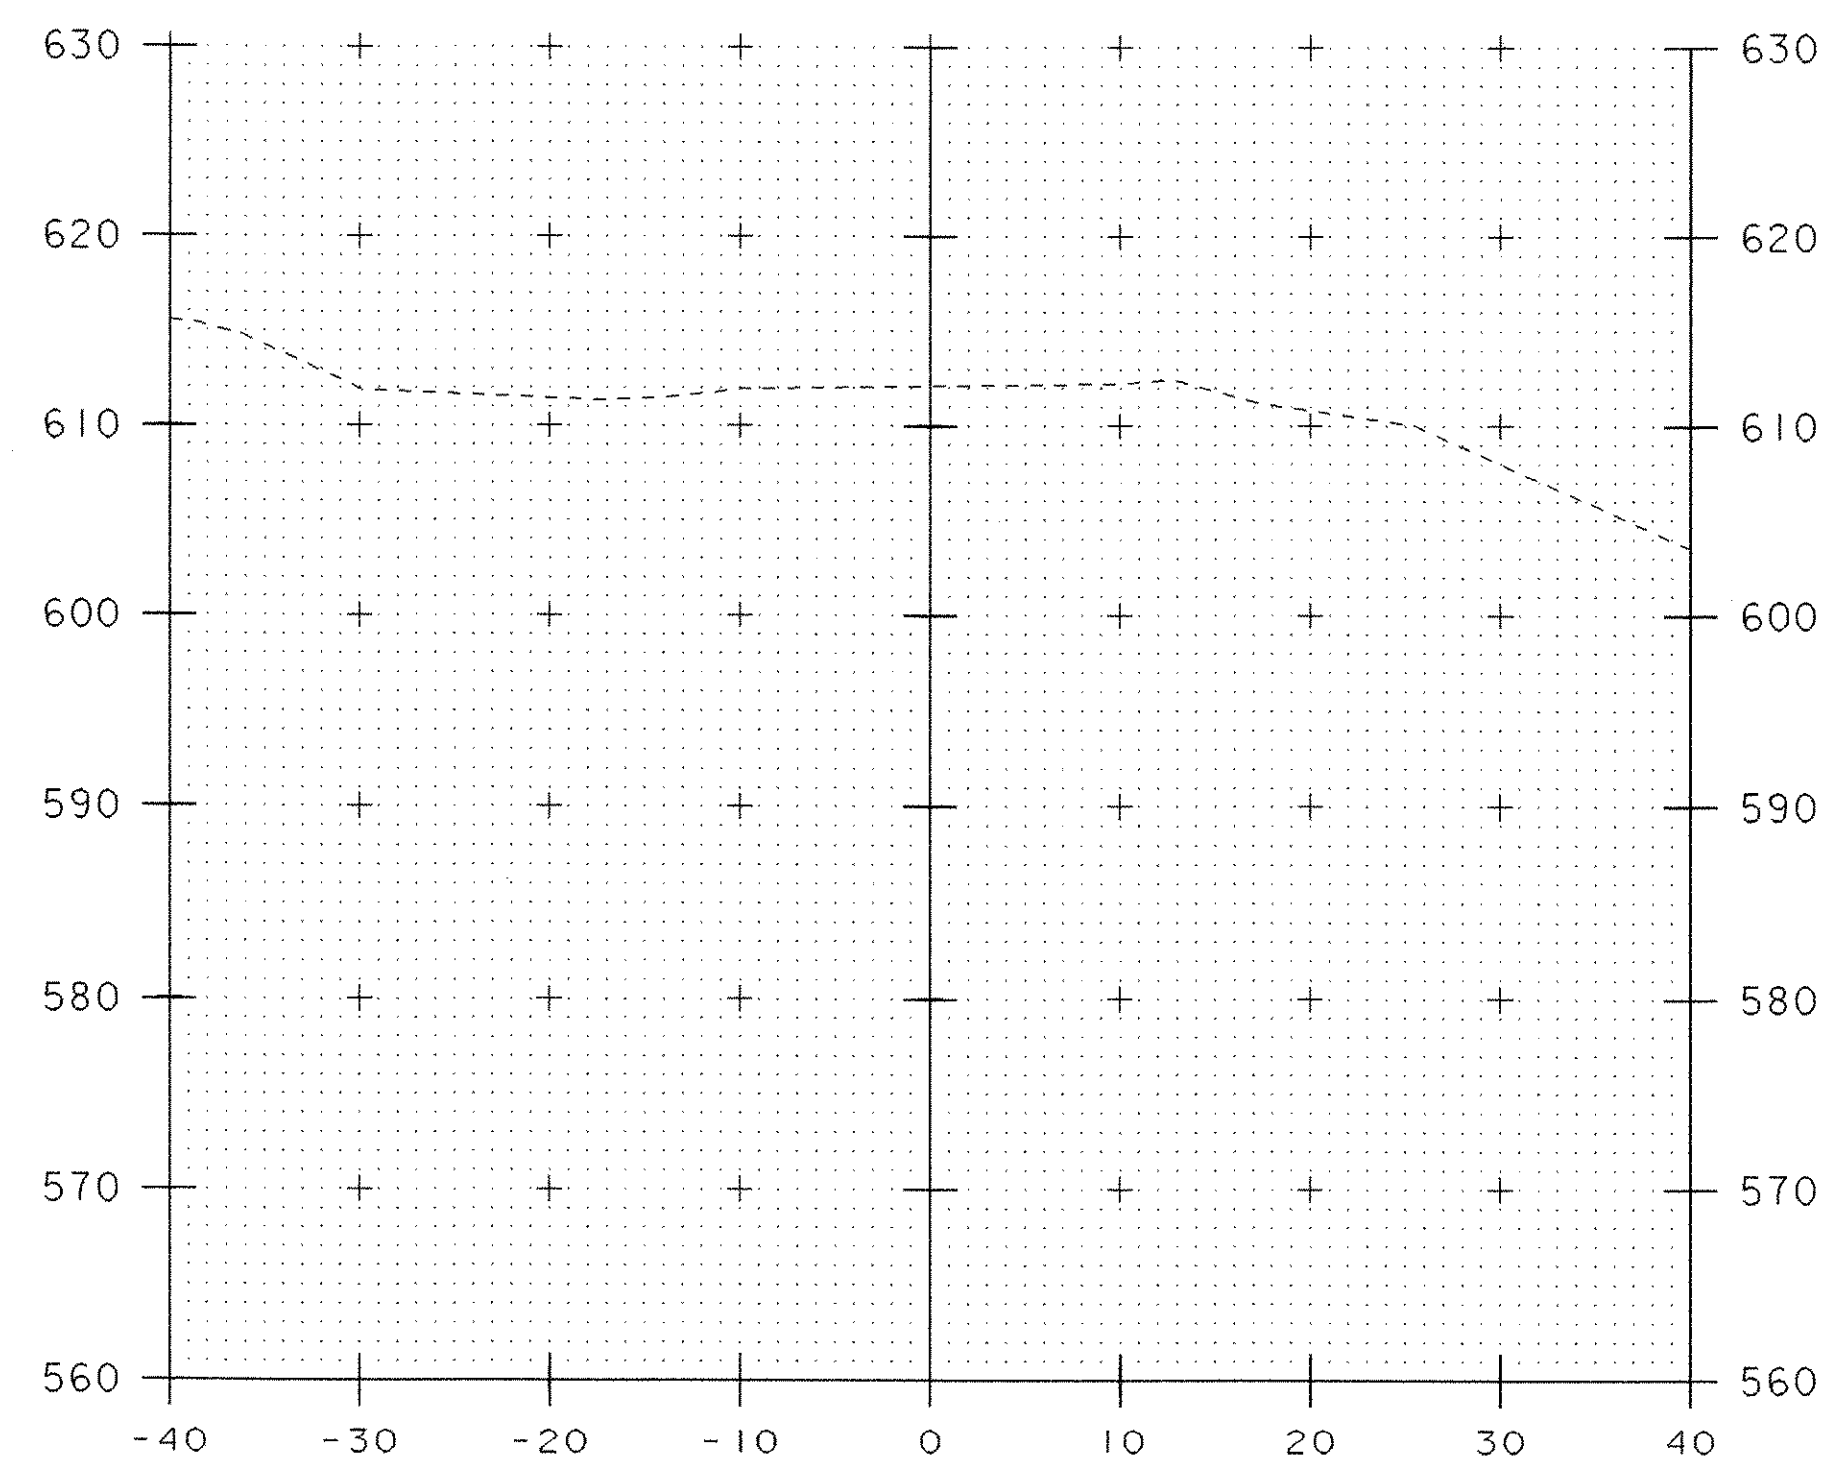

10+06

STA. 9+00 TO STA. 10+06

MAINLINE SECTIONS

PROJECT NAME: WEATHERSFIELD	PLOT DATE: 15-MAR-2007
PROJECT NUMBER: BHO 1442(29)	DRAWN BY: G. SHANGRAW
FILE NAME: /96j234/str/s96j234xsl.dgn	CHECKED BY: T. SUMNER
PROJECT LEADER: W. SYMONDS	SHEET 54 OF 60
DESIGNED BY: T. FILLBACH	
sj234m4.1	