


50+80

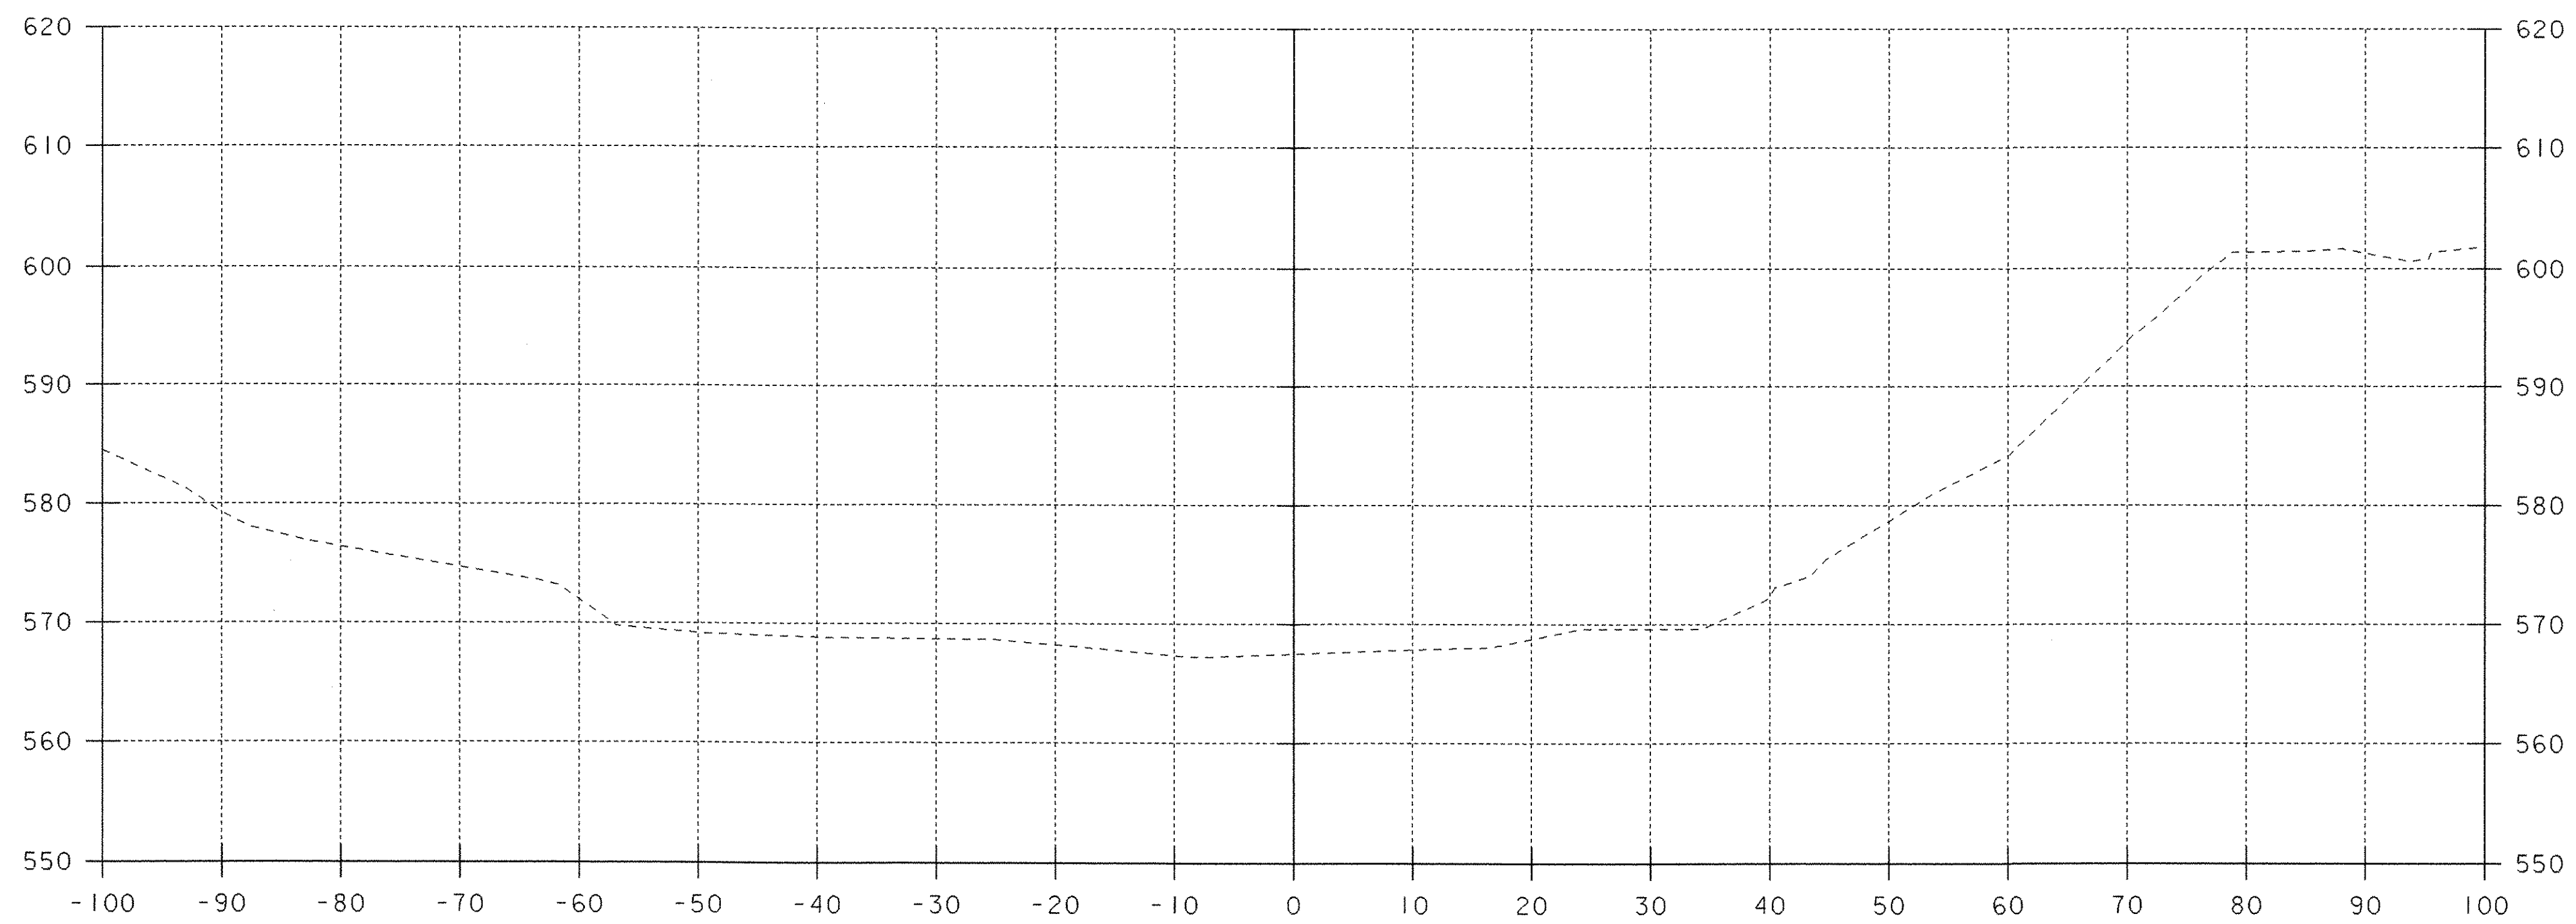

50+70

### CHANNEL SECTIONS

PROJECT NAME:	WEATHERSFIELD	PLOT DATE:	15-MAR-2007
PROJECT NUMBER:	BHO 1442(29)	DRAWN BY:	G. SHANGRAW
FILE NAME:	/96j234/s+tr/s96j234xsl.dgn	CHECKED BY:	T. SUMNER
PROJECT LEADER:	W. SYMONDS	SHEET	56 OF 60
DESIGNED BY:	T. FILLBACH		
sj234cx2.i			

STA. 50+70 TO STA. 50+80