


51+00

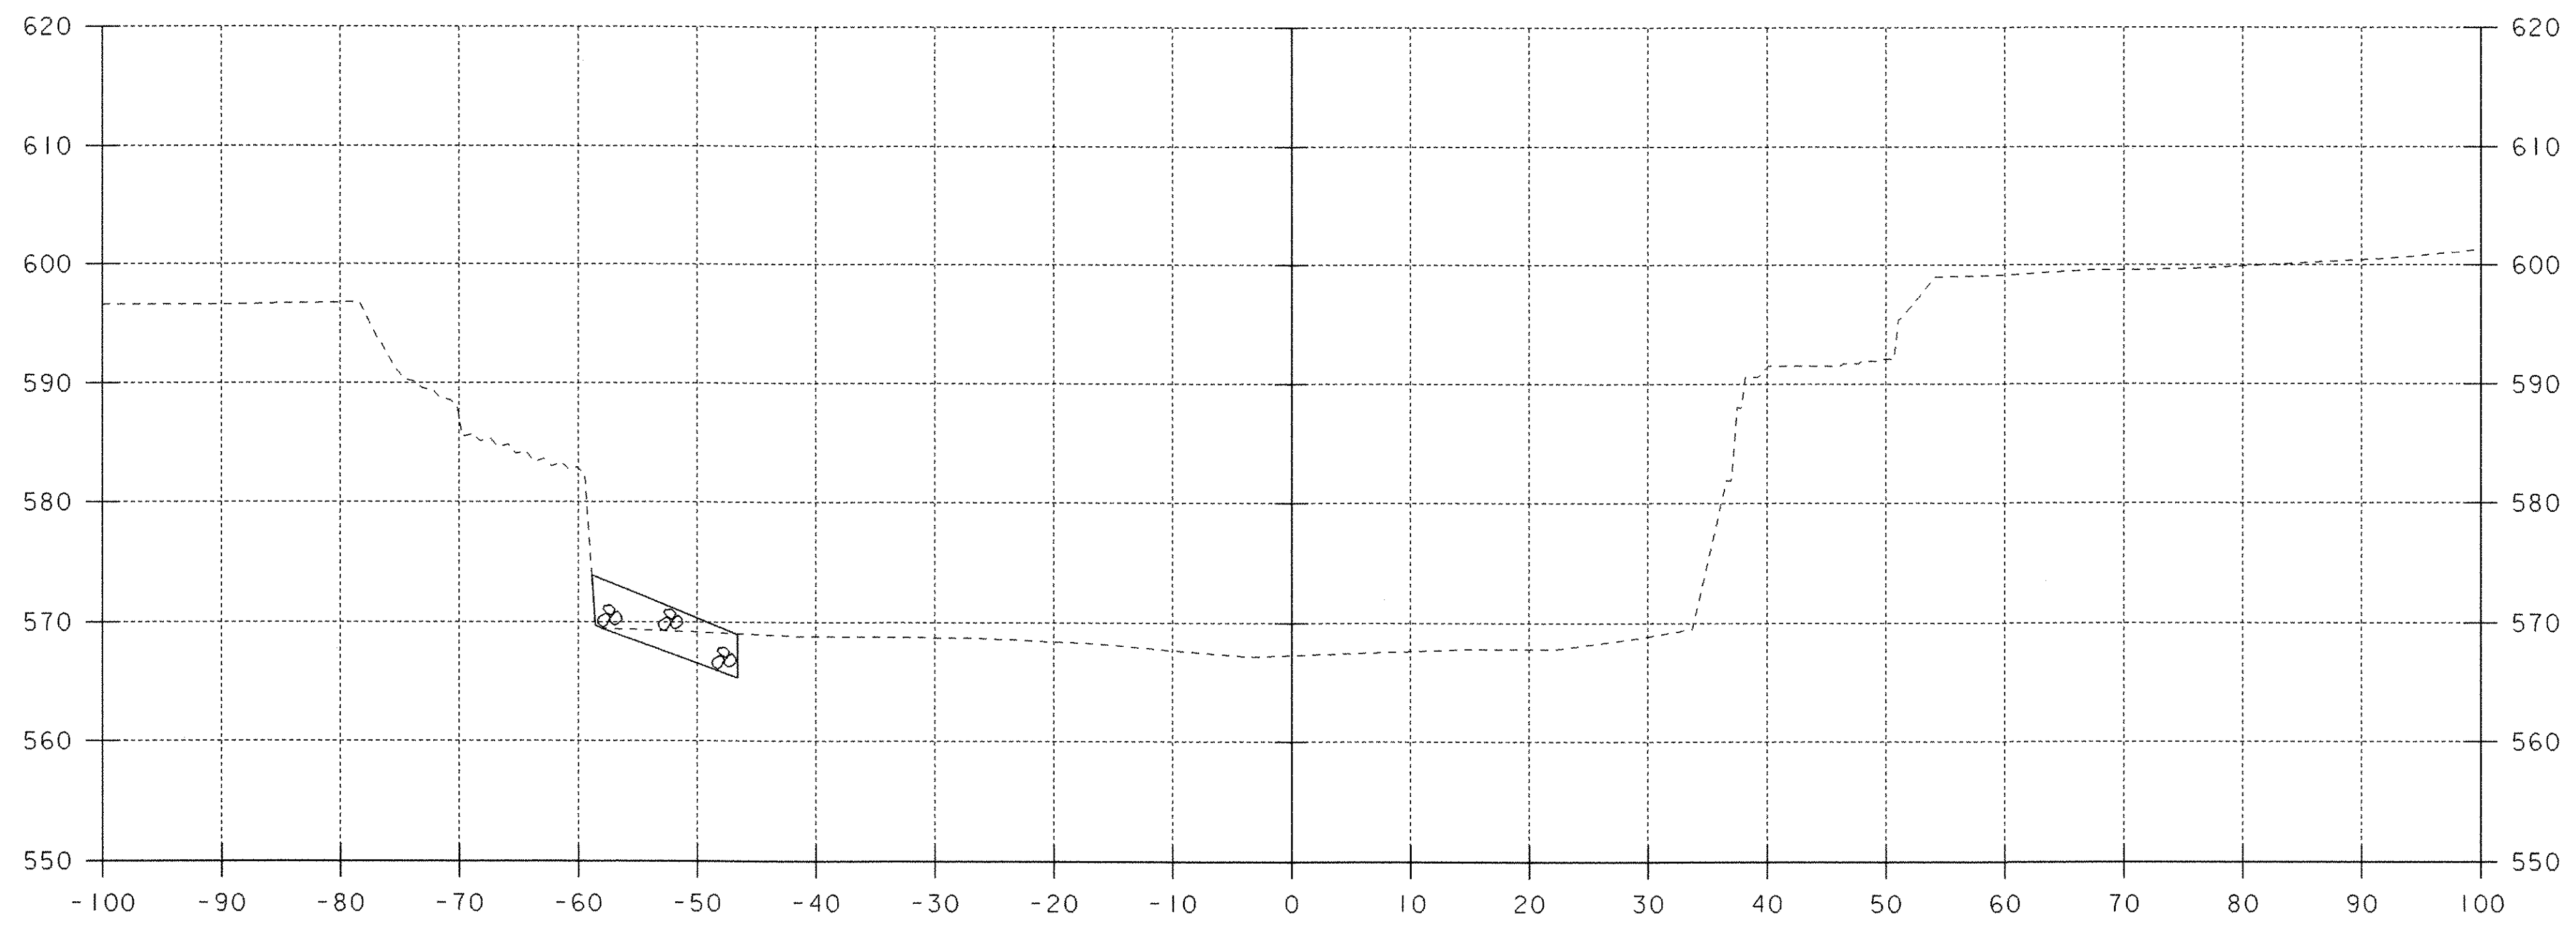

50+90

### CHANNEL SECTIONS

PROJECT NAME: WEATHERSFIELD	PLOT DATE: 15-MAR-2007
PROJECT NUMBER: BHO 1442(29)	DRAWN BY: G. SHANGRAW
FILE NAME: /96J234/s+tr/s96J234xsl.dgn	CHECKED BY: T. SUMNER
PROJECT LEADER: W. SYMONDS	SHEET 57 OF 60
DESIGNED BY: T. FILLBACH	
sj234cx3.1	

STA. 50+90 TO STA. 51+00