


**PLAN**  
SCALE 1:100

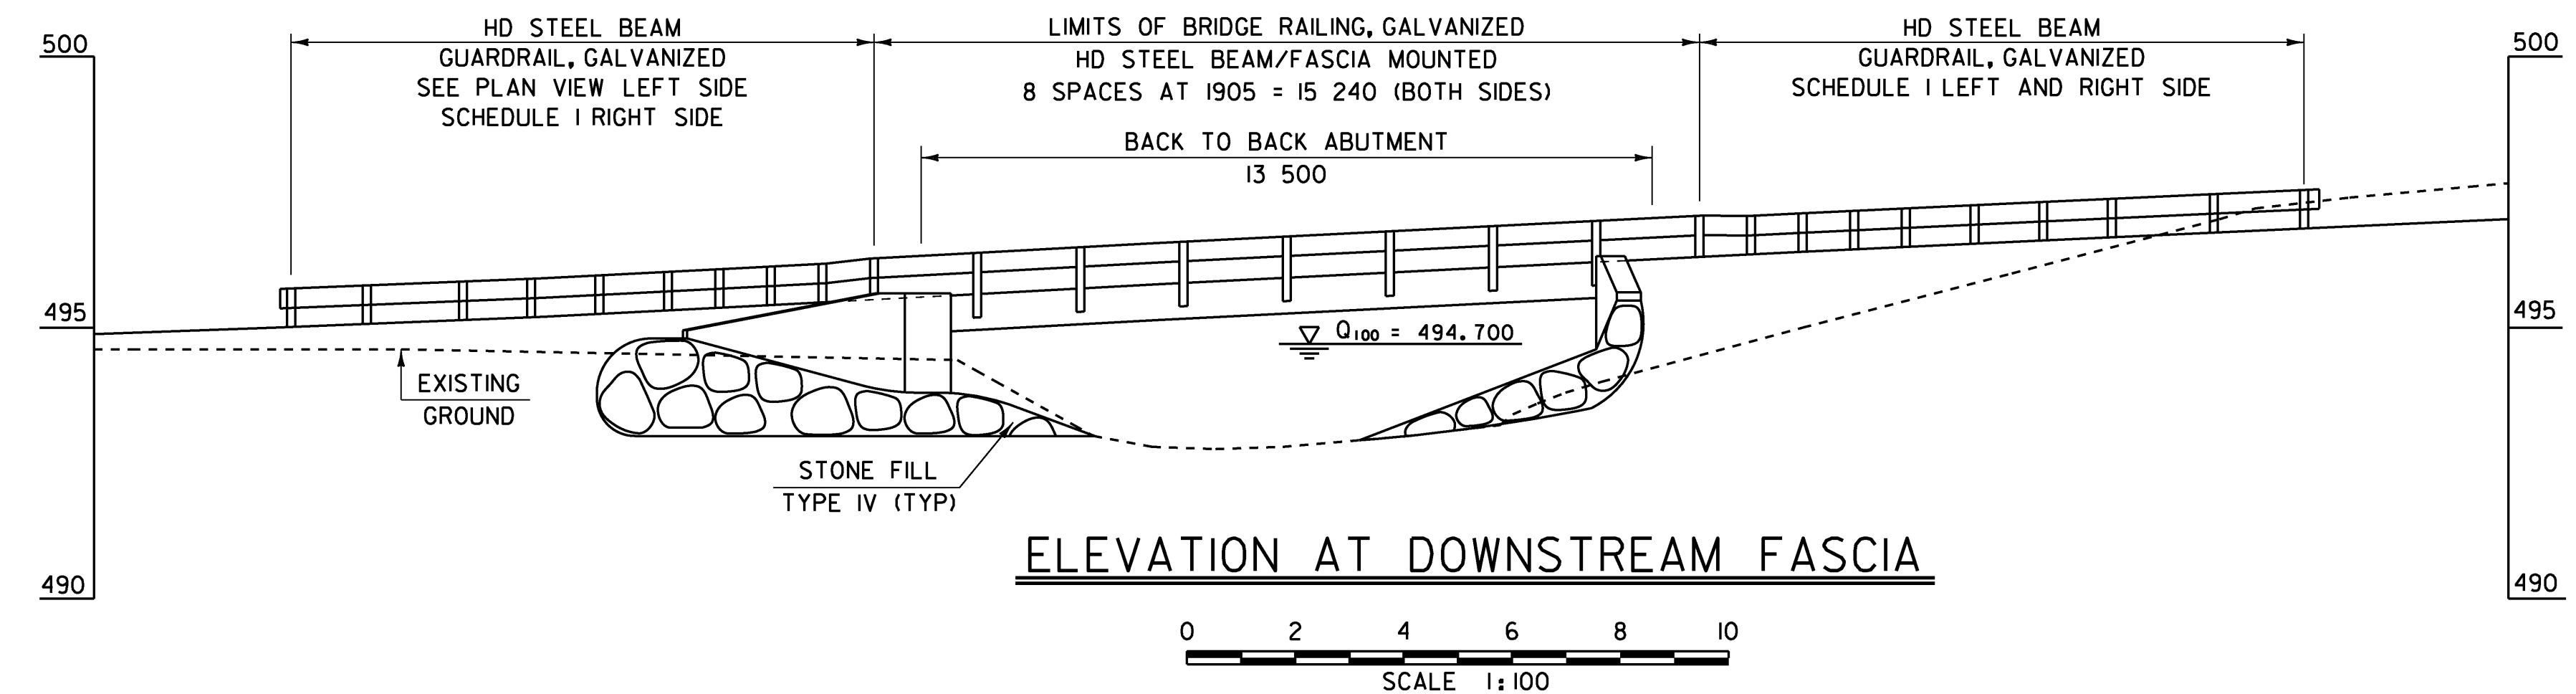

**ELEVATION AT DOWNSTREAM FASCIA**  
SCALE 1:100

BRIDGE 19 PLAN AND ELEVATION	
PROJECT NAME:	CHITTENDEN
PROJECT NUMBER:	STP 1443(45)
FILE NAME:	/s/r/1/96j236/sj236pe.dgn
PROJECT MANAGER:	C. CARLSON
DESIGNED BY:	K. UPMAL
PLOT DATE:	14-AUG-2009
DRAWN BY:	J. GILMORE
IPARM NAME:	sj088pel1
SHEET	34 OF 81