



WINGWALL #2 ELEVATION

NOTES

1. NF = NEAR FACE
2. FF = FAR FACE
3. EF = EACH FACE
4. ▲ = CUT TO FIT IN FIELD
5. 80 CLEAR UNLESS OTHERWISE SPECIFIED ON THE PLANS
6. 3000 MAX. WEEPHOLE SPACING
7. ALL LAPS NOT DETAILED SHALL BE 660 (MIN)

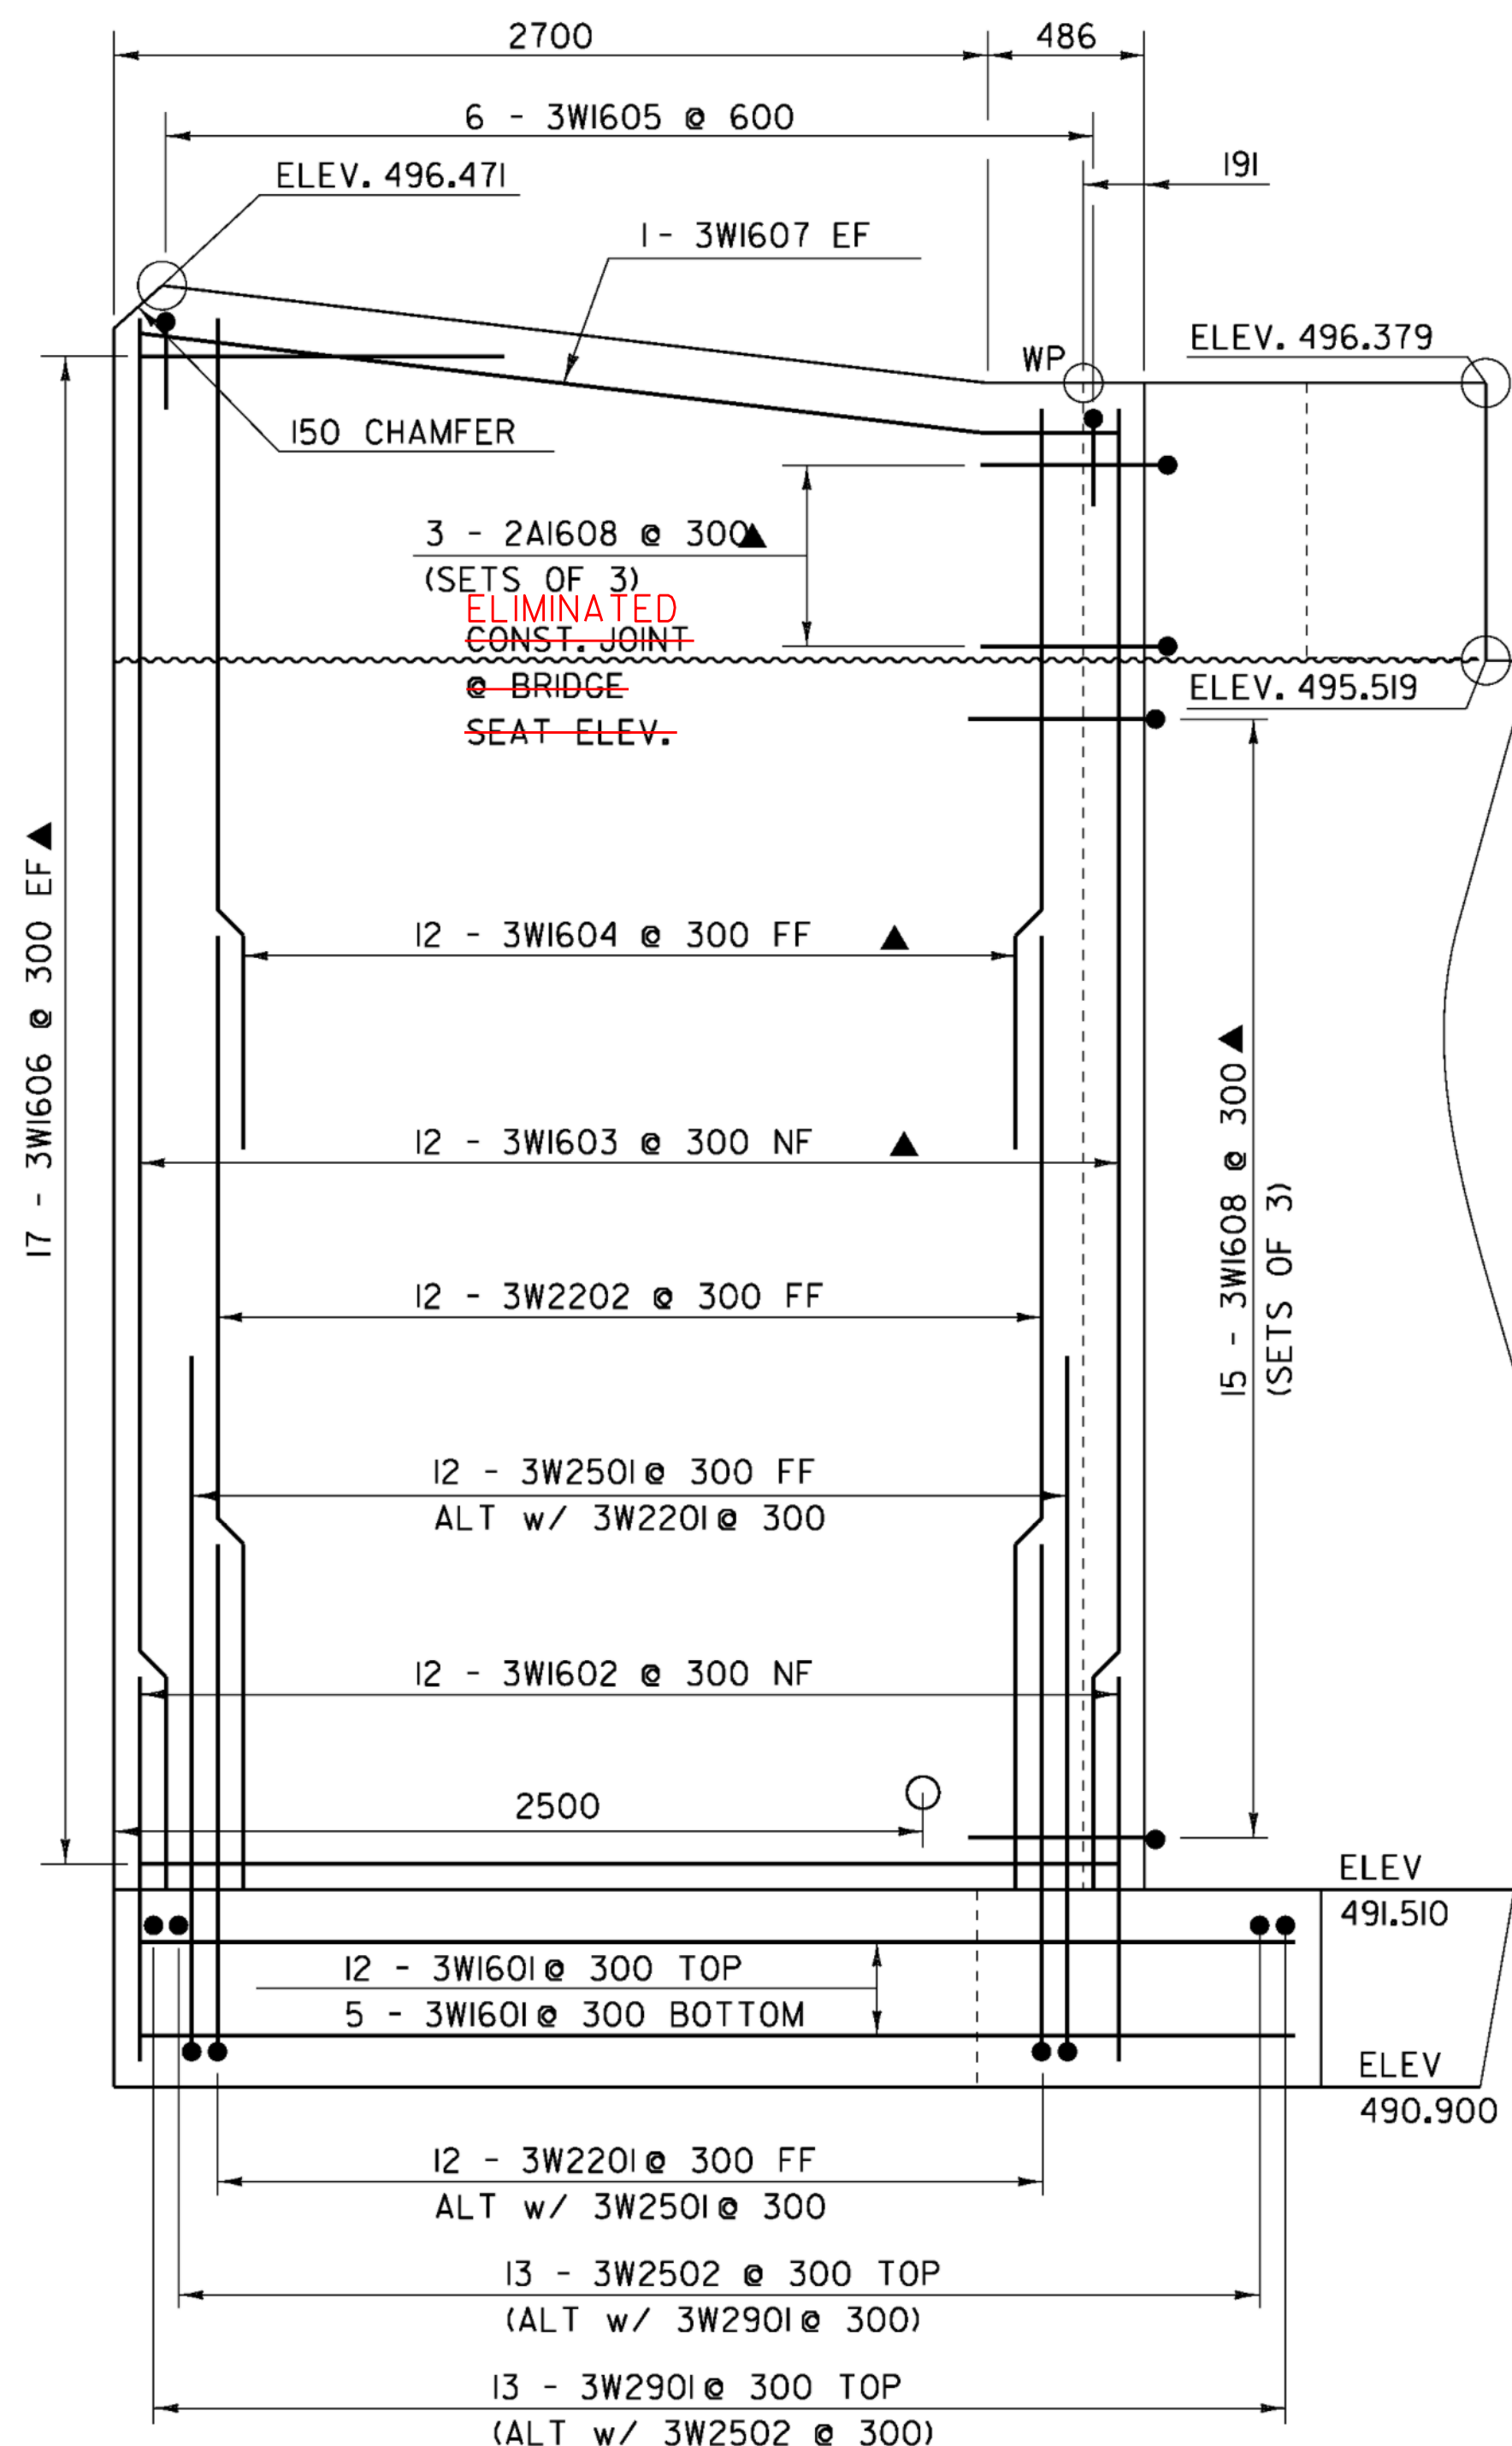

WINGWALL #3 ELEVATION

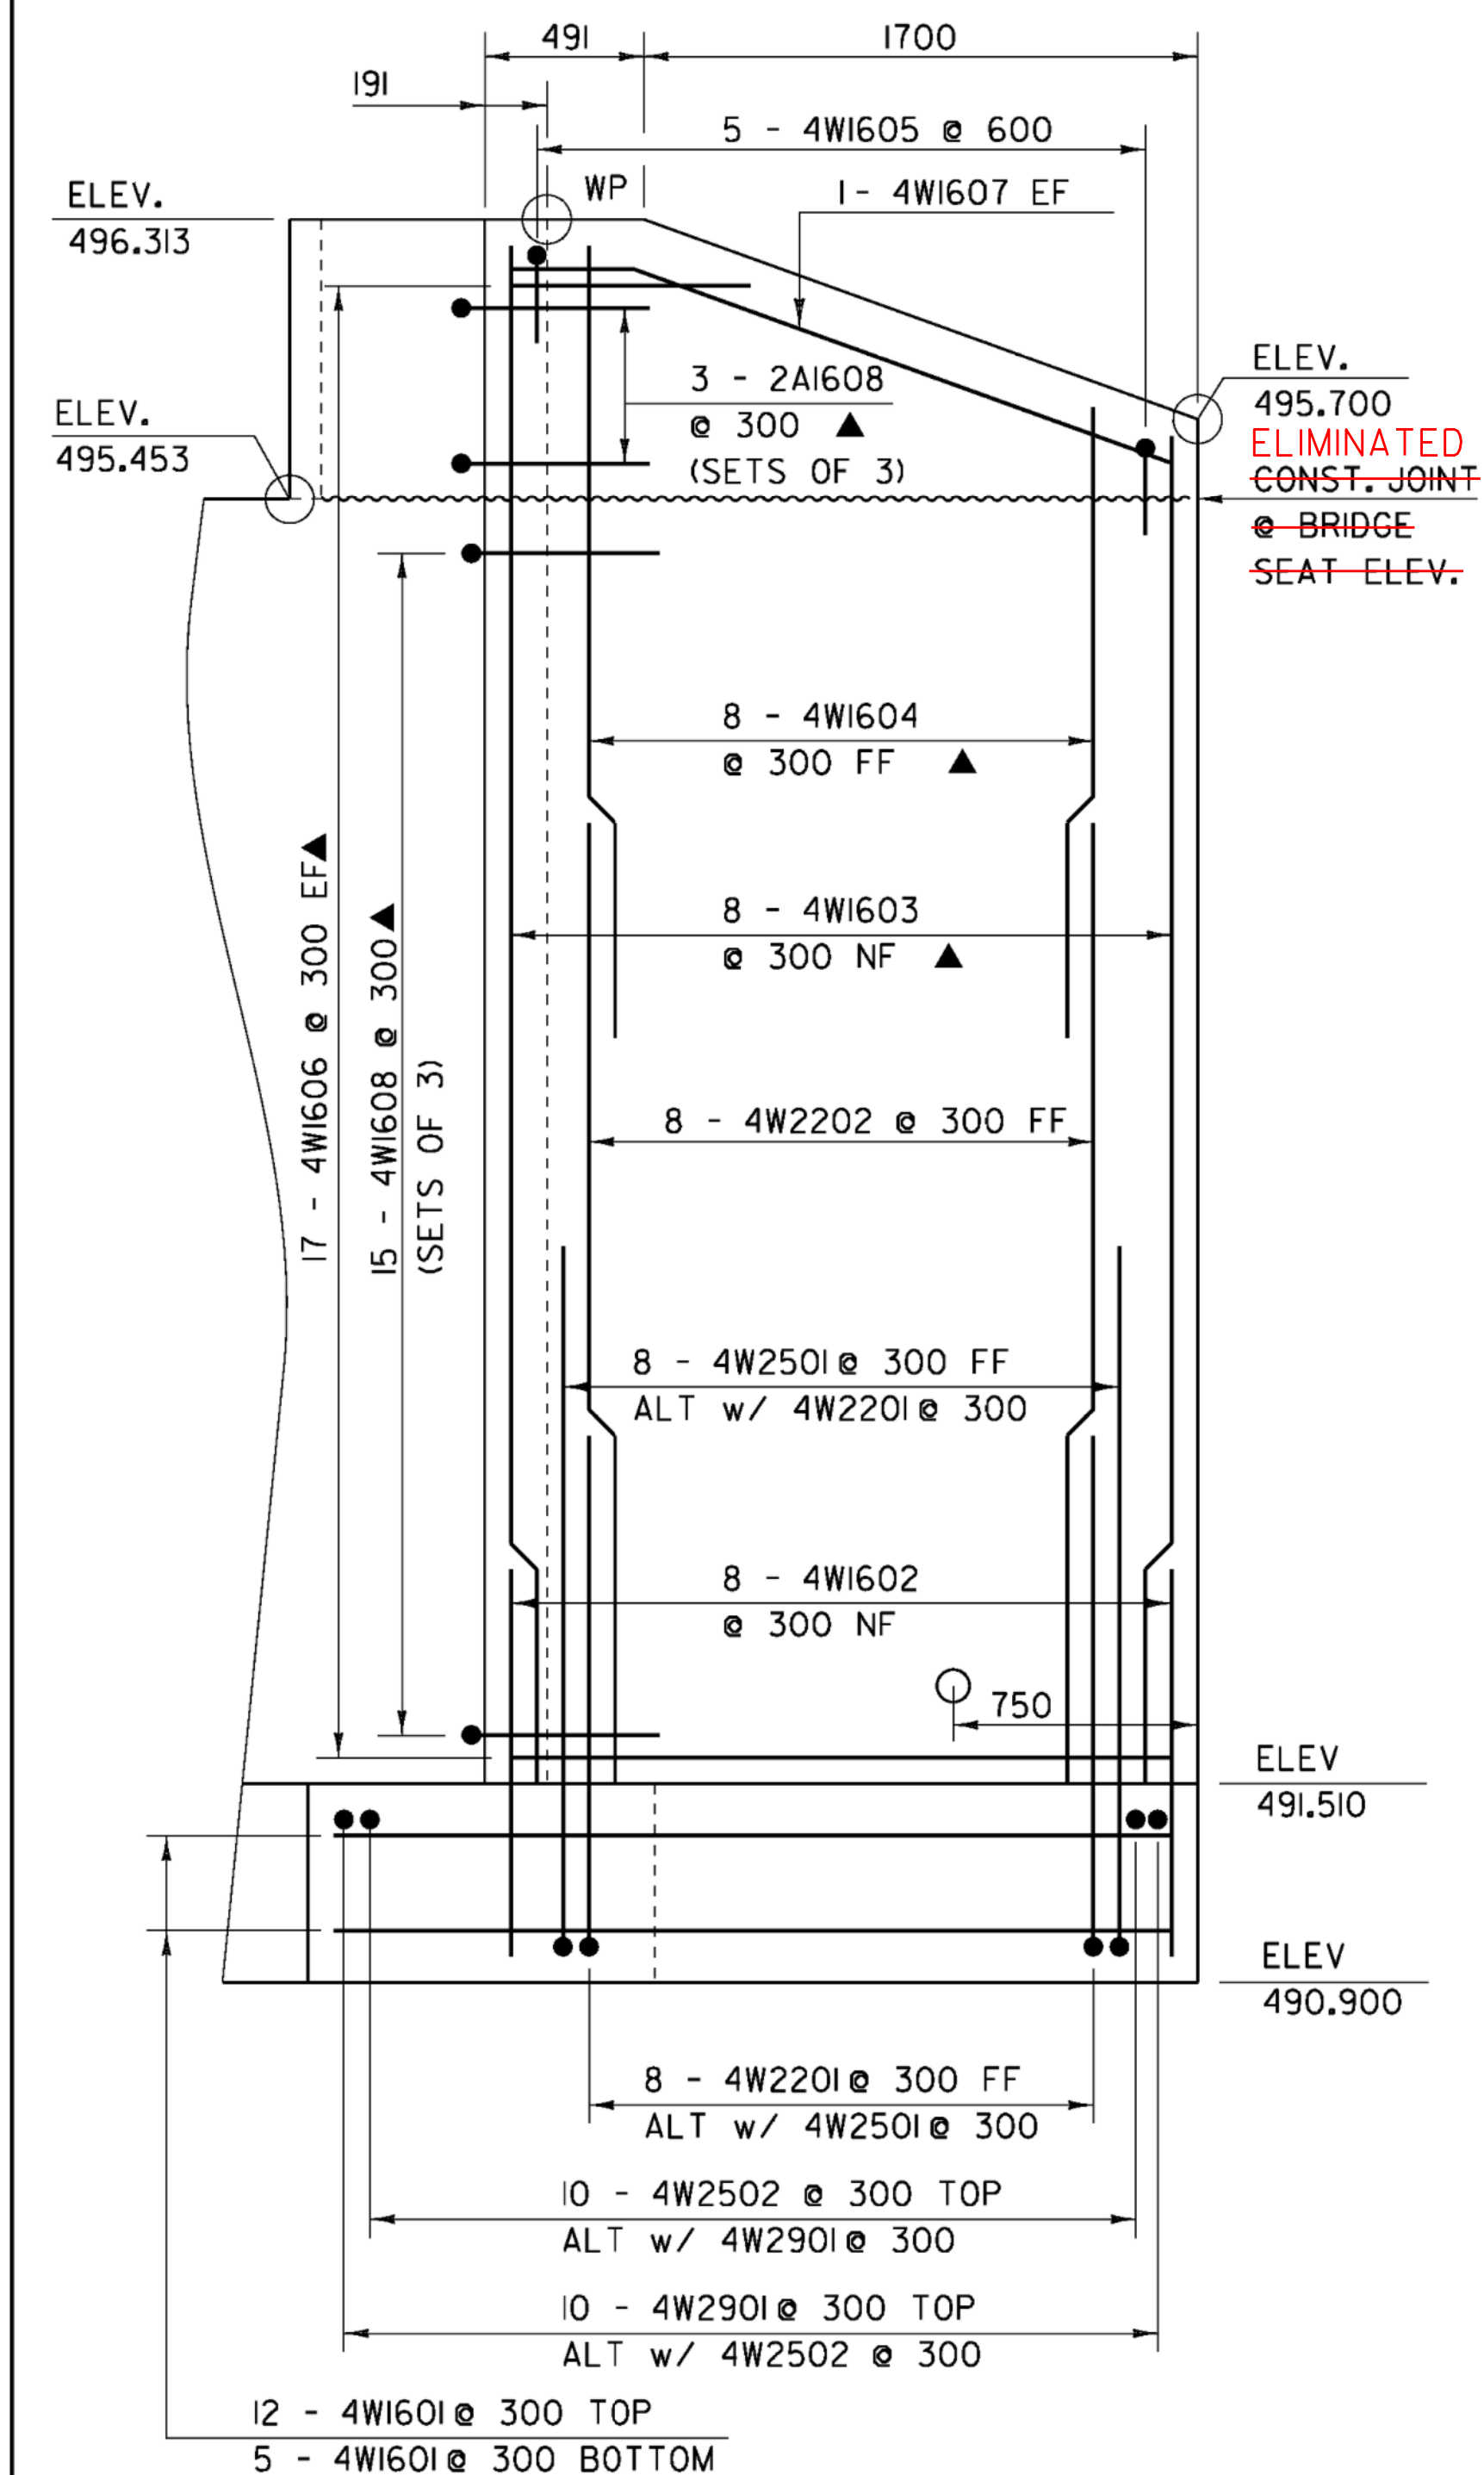

WINGWALL #4 ELEVATION

BRIDGE 19 WINGWALL ELEVATIONS

PROJECT NAME: CHITTENDEN  
PROJECT NUMBER: STP 1443(45)

FILE NAME: 96j236\str\s236ww.dgn  
PROJECT MANAGER: C. CARLSON  
DESIGNED BY: K. UPMAL  
PLOT DATE: 14-AUG-2009  
DRAWN BY: C. WEEBER  
CHECKED BY: C. CARLSON  
iparm sj236wwelev.l  
SHEET 39 OF 81

