


STA. 7+015.50 NEAR RIGHT
 BEGIN UNCLASSIFIED CHANNEL EXCAVATION
 GEOTEXTILE UNDER STONE FILL
 STONE FILL TYPE IV
 GRUBBING MATERIAL

7+015

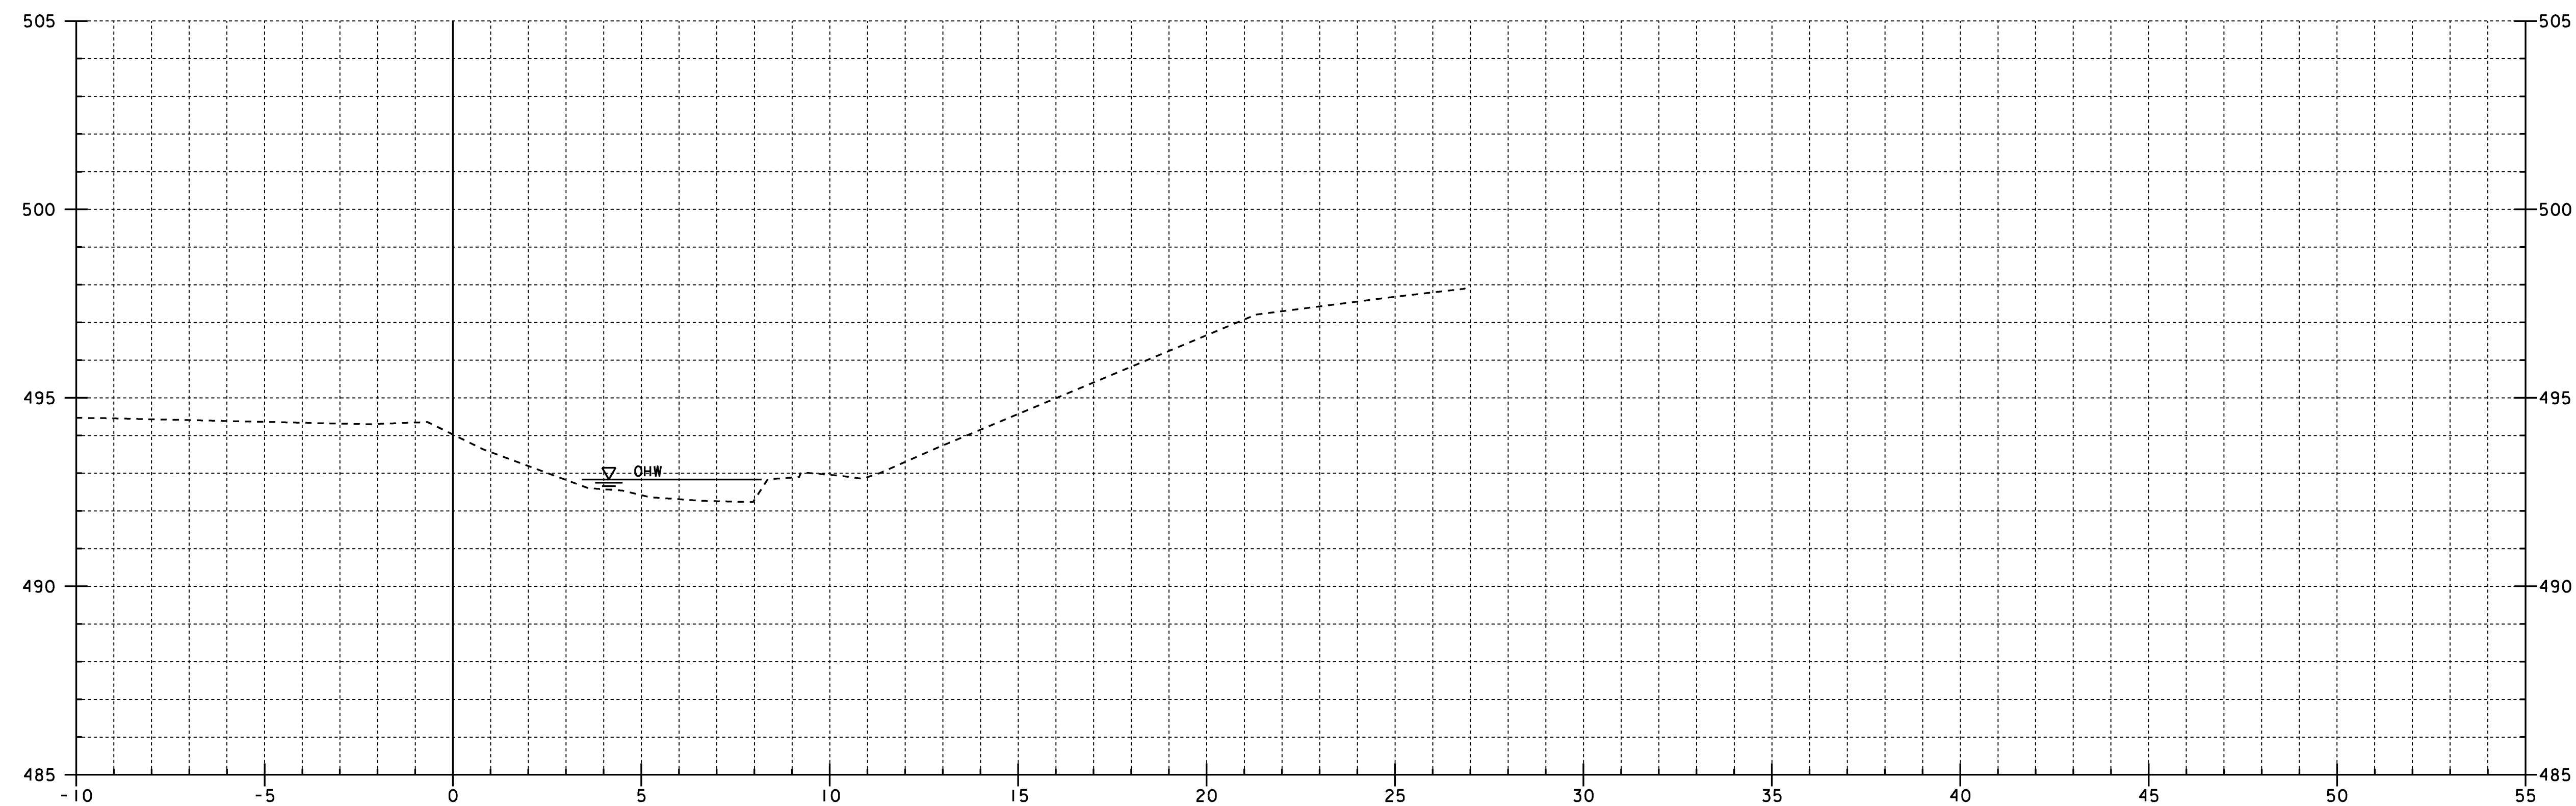

7+010

BRIDGE 19 CHANNEL CROSS SECTIONS 2

PROJECT NAME: CHITTENDEN
 PROJECT NUMBER: STP 1443(45)

FILE NAME: /96J236/str/sj236xs.dgn
 PROJECT MANAGER: C. CARLSON
 DESIGNED BY: K. UPMAL

PLOT DATE: 14-AUG-2009
 DRAWN BY: STR
 IPARM NAME: sj236cx2.1
 SHEET 48 OF 81

STATION 7+010 - 7+015