


STA. 7+025.180 NEAR RIGHT
 STOP GRUBBING MATERIAL

STA. 7+025.000 FAR RIGHT
 BEGIN UNCLASSIFIED CHANNEL EXCAVATION
 GEOTEXTILE UNDER STONE FILL
 STONE FILL TYPE IV
 GRUBBING MATERIAL

7+025

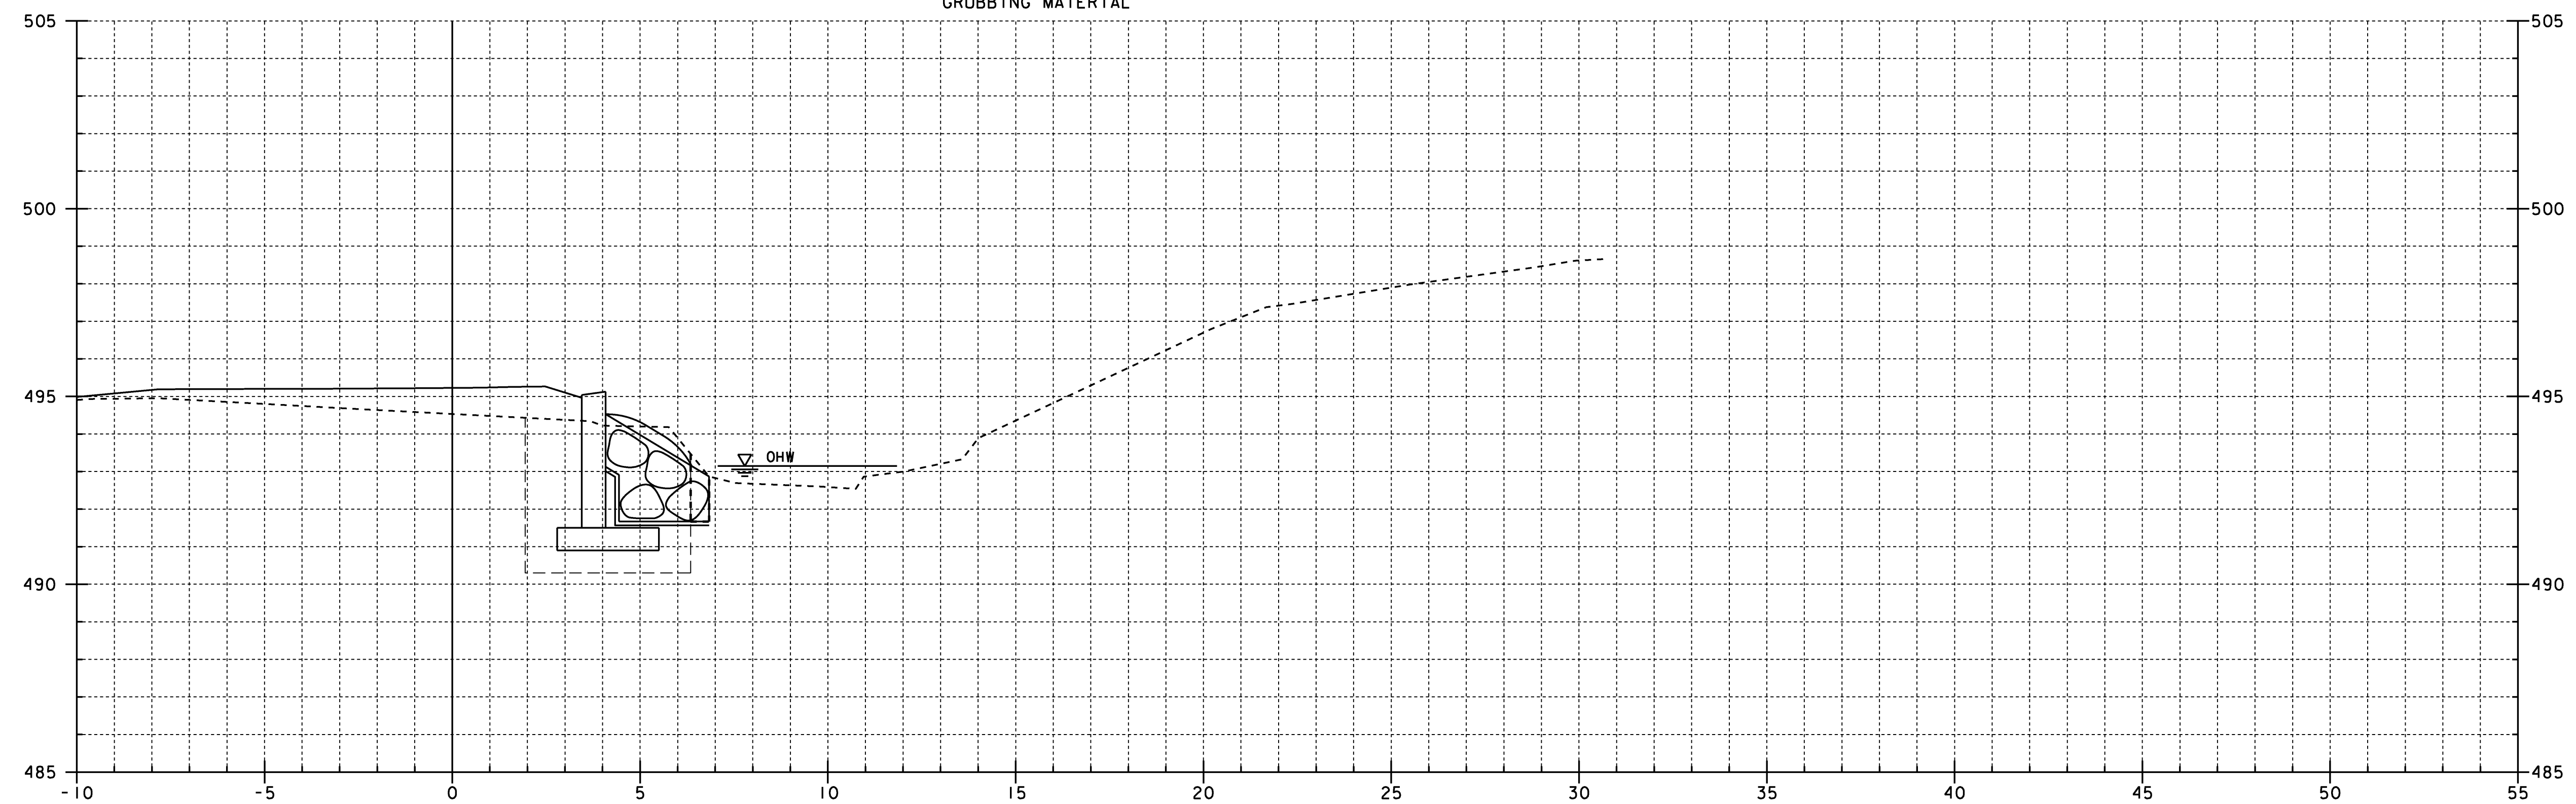

7+020

STA. 7+017.800 NEAR RIGHT
 BEGIN GRANULAR BACKFILL FOR STRUCTURES

BRIDGE 19 CHANNEL CROSS SECTIONS 3

PROJECT NAME: CHITTENDEN	PLOT DATE: 14-AUG-2009
PROJECT NUMBER: STP 1443(45)	DRAWN BY: STR
FILE NAME: /96J236/str/sj236xs.dgn	IPARM NAME: sj236cx3.l
PROJECT MANAGER: C. CARLSON	SHEET 49 OF 81
DESIGNED BY: K. UPMAL	