
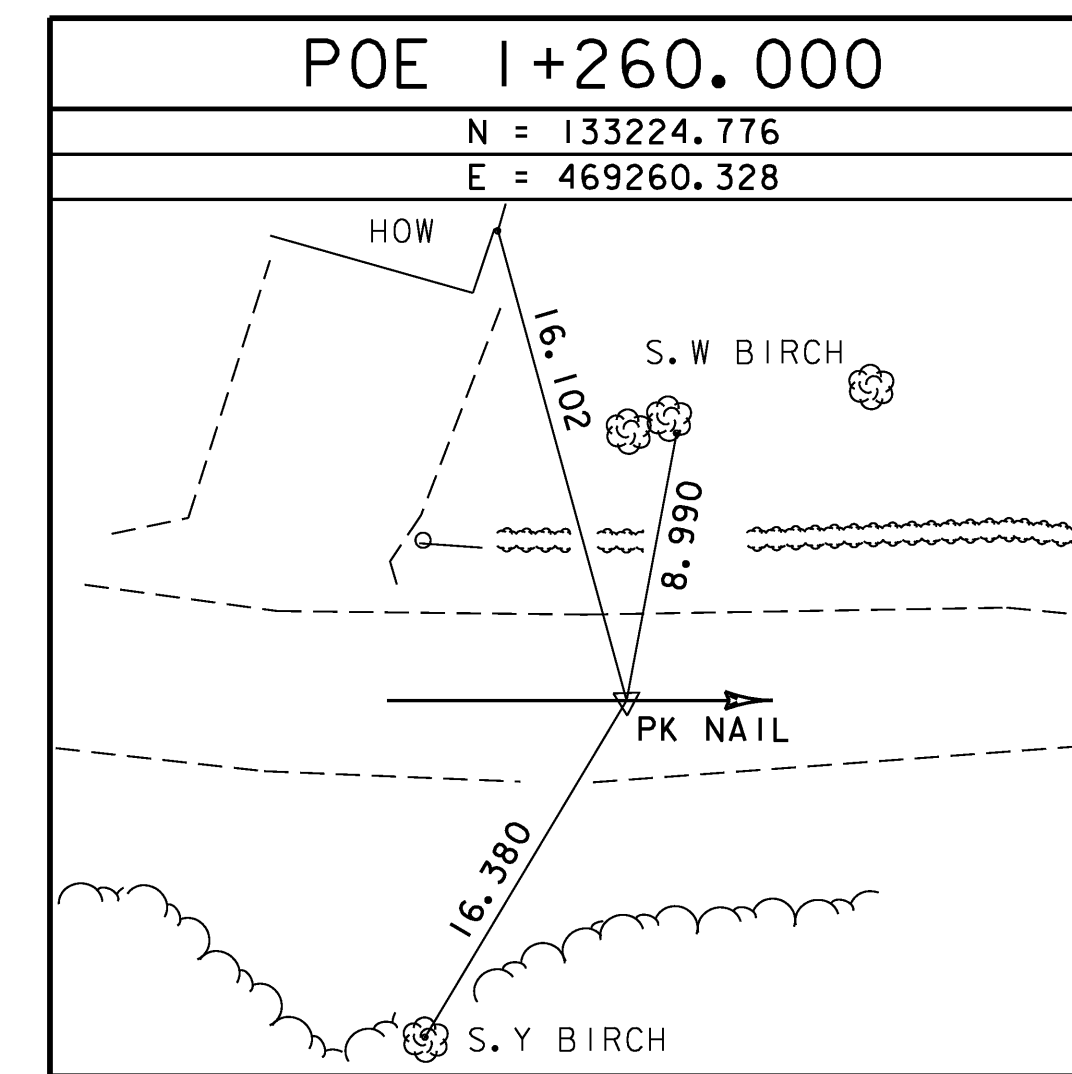
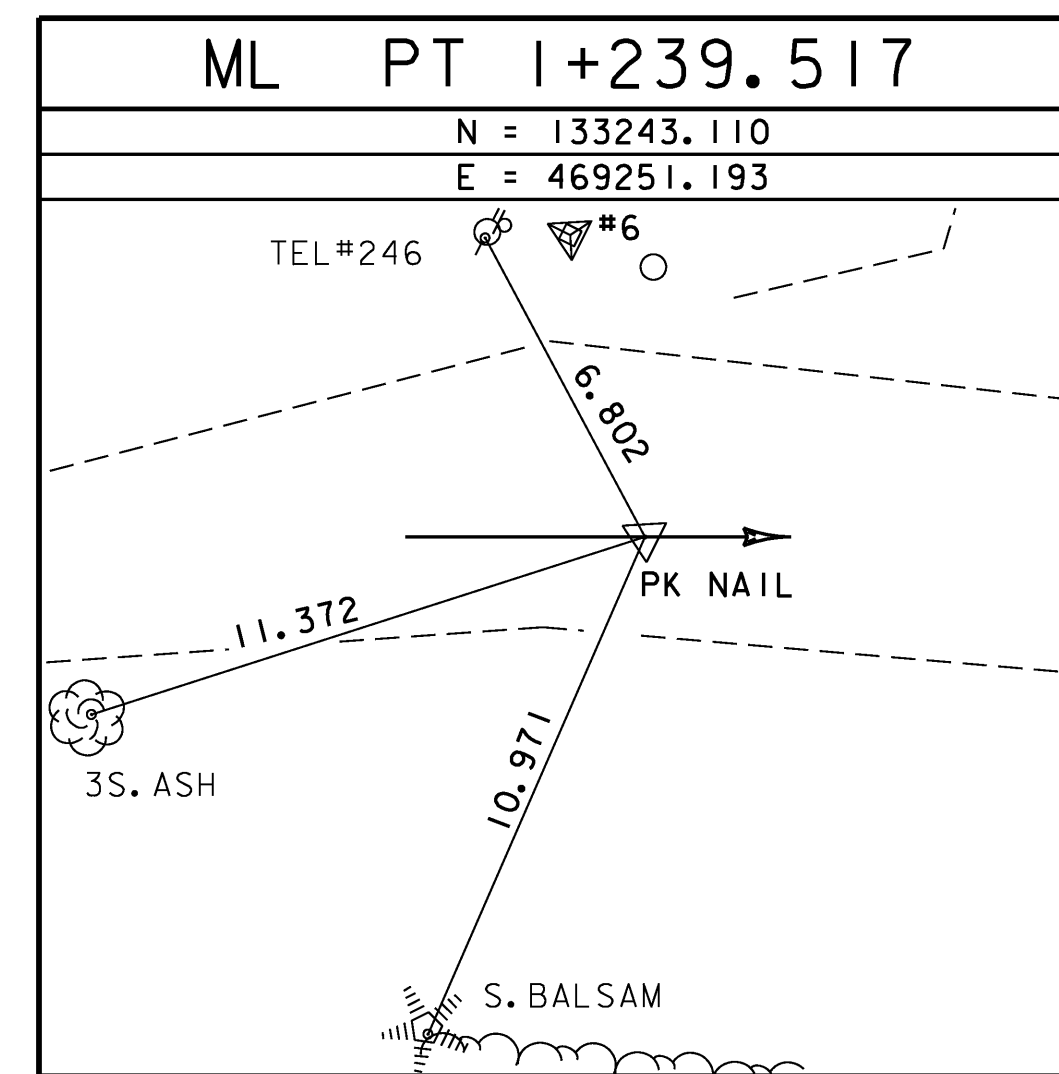
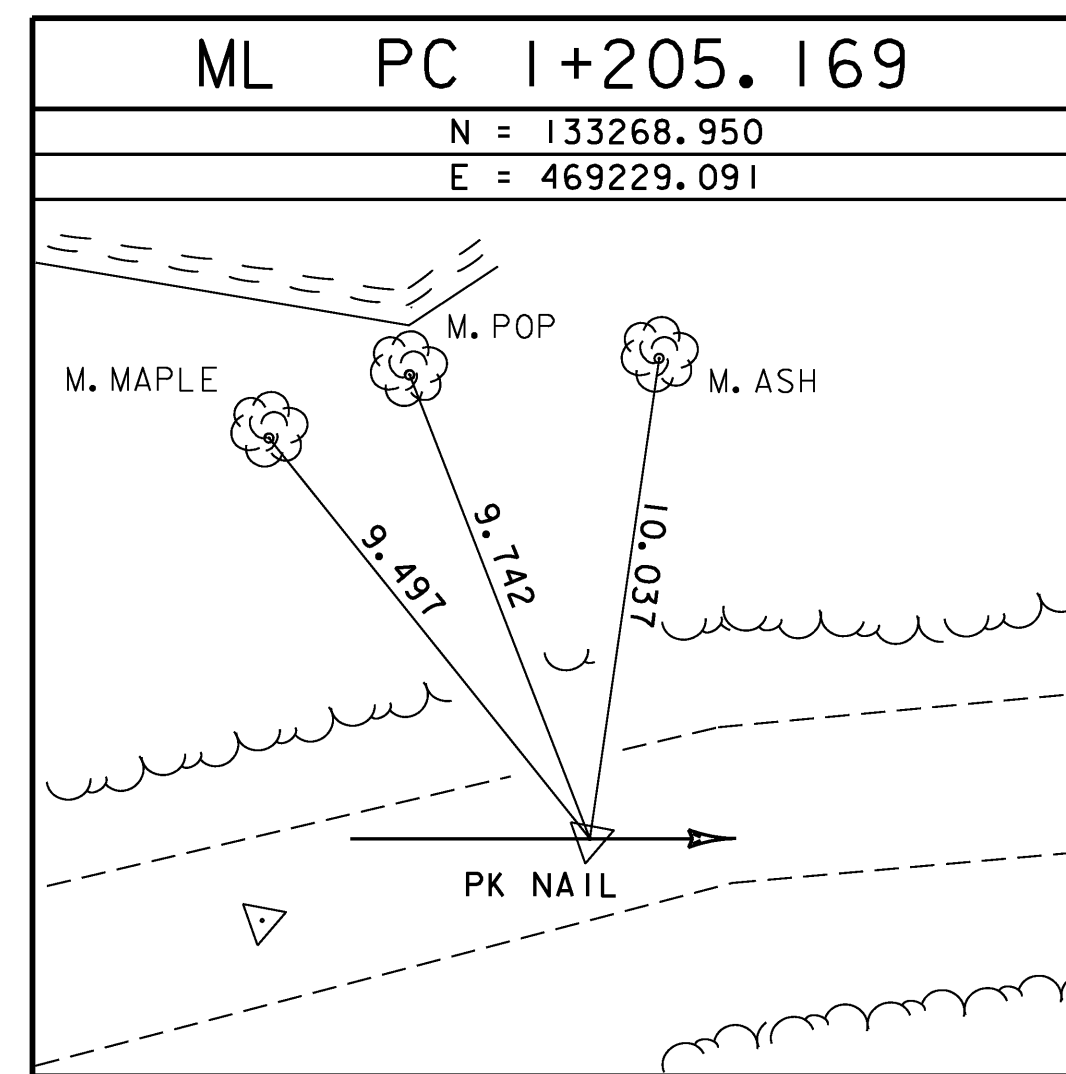
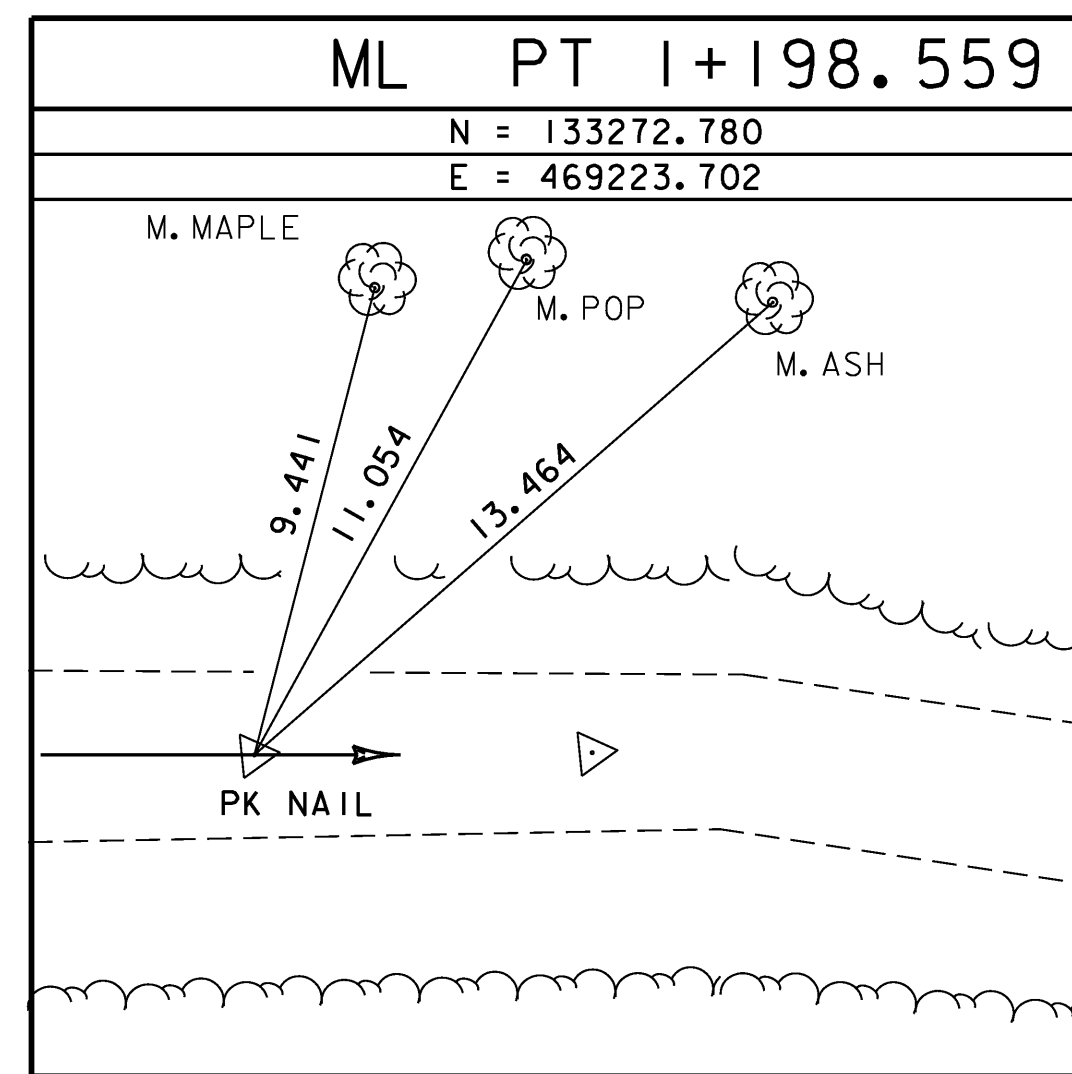


GPS CONTROL POINTS

TRAVERSE TIES

ALIGNMENT TIES

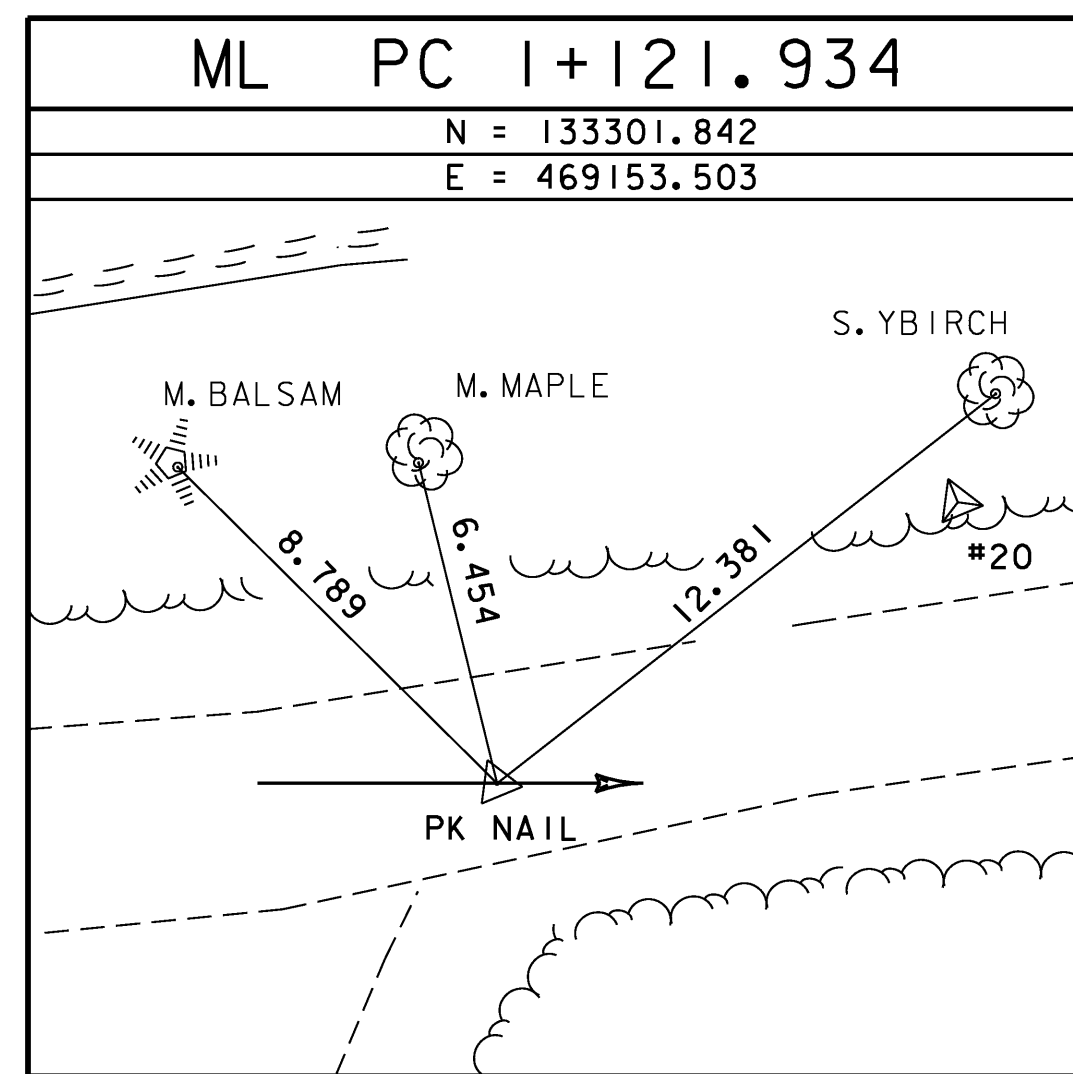

\* ALIGNMENT STAKED ON JANUARY 2, 2002 BY L. ORVIS & T. WILSON

**BRIDGE 20 TIE SHEET**

PROJECT NAME: CHITTENDEN	PLOT DATE: 14-AUG-2009
PROJECT NUMBER: STP 1443(46)	DRAWN BY: J.HULETT
FILE NAME: /96j236/str/sj236tie.dgn	IPARM NAME: sj236+12.1
PROJECT MANAGER: C. CARLSON	SHEET 58 OF 81
DESIGNED BY: K. UPMAL	

TIE DISTANCES ARE SHOWN IN METERS

<b>DATUM</b>	
VERTICAL	NAVD88
HORIZONTAL	NAD-83(92)