




MATCH LINE
(SEE SHEET 31)

MATCH LINE
(SEE SHEET 31)

-  TYPE III BARRICADES (MOD.)
-  TRAFFIC DRUMS (REFLECTORIZED)

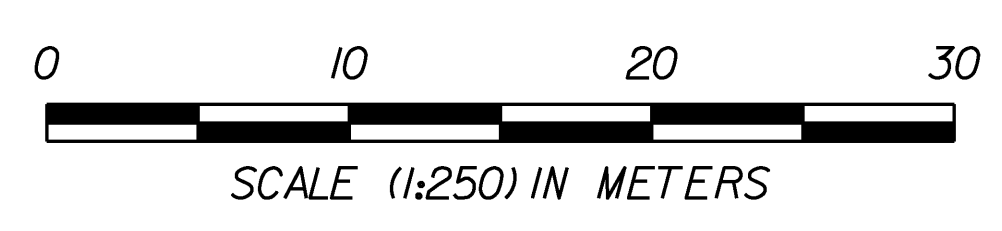

BRIDGE 20 TRAFFIC CONTROL	
PROJECT NAME:	CHITTENDEN
PROJECT NUMBER:	STP 1443(46)
FILE NAME:	/96j236/str/sj236trf.dgn
PROJECT MANAGER:	C. CARLSON
DESIGNED BY:	K. UPMAL
PLOT DATE:	25-AUG-2009
DRAWN BY:	STR
IPARM NAME:	sj236+f2.1
SHEET	62 OF 81