


WINGWALL #4 ELEVATION

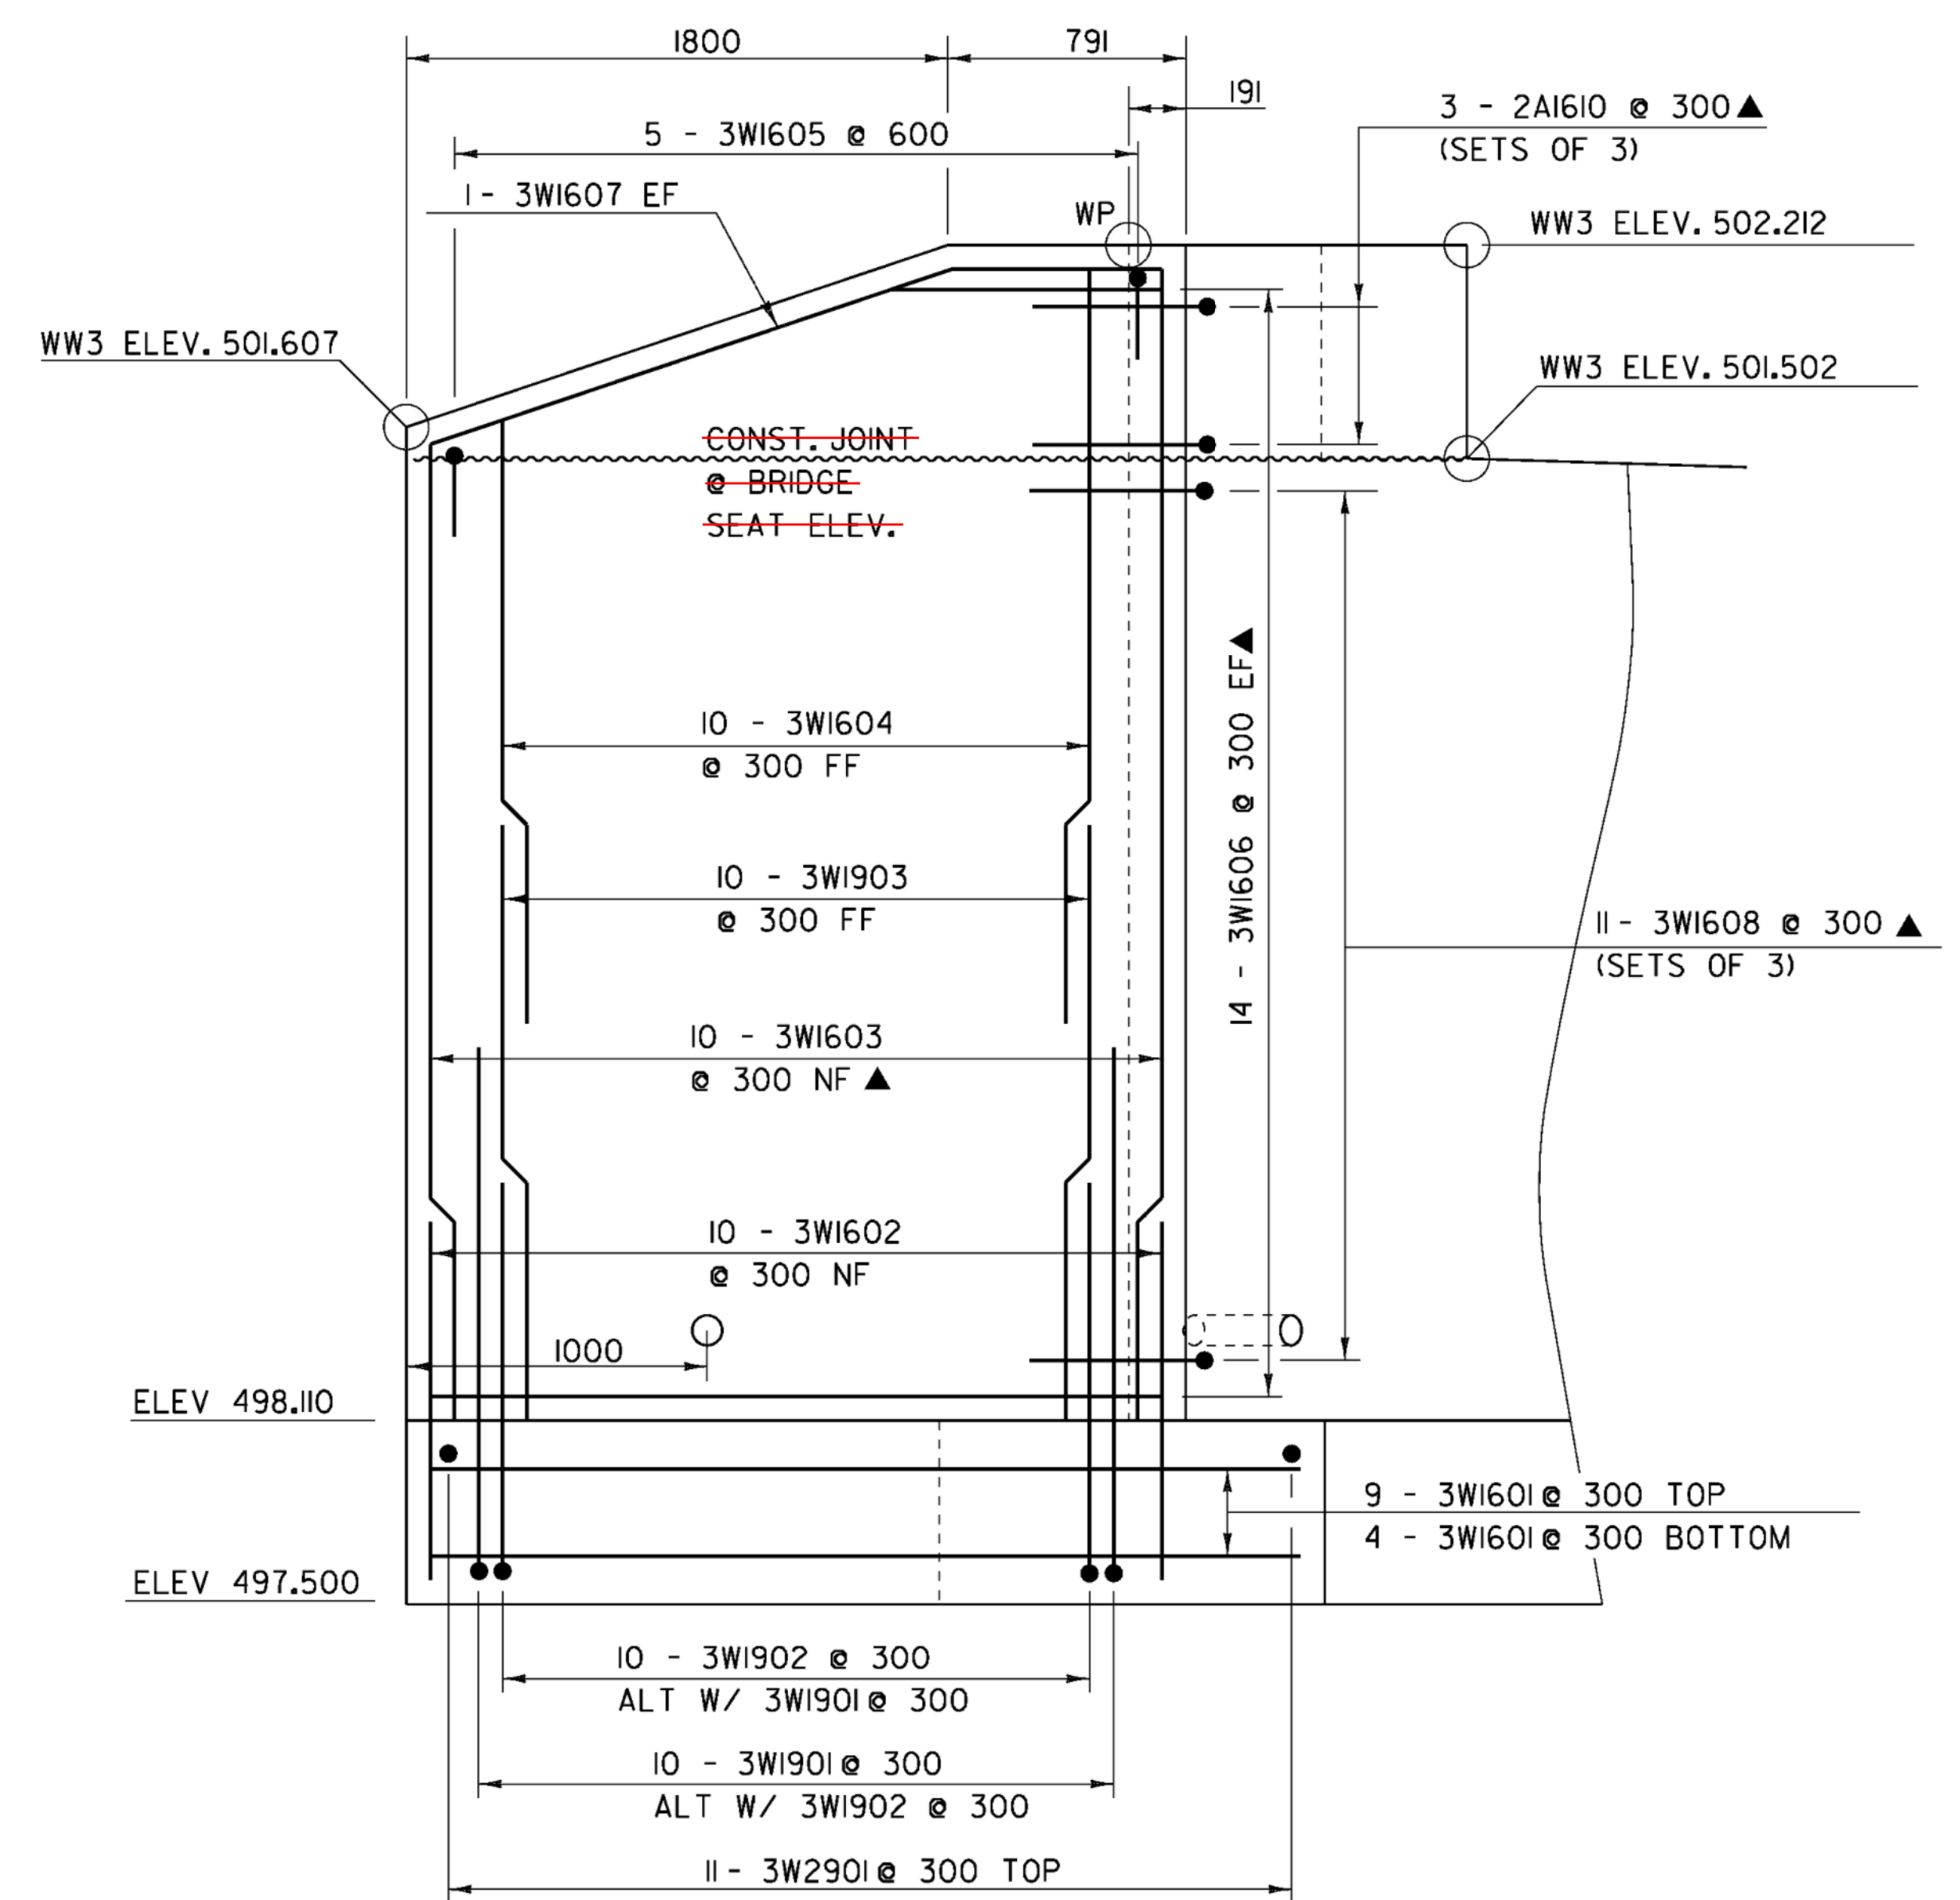

WINGWALL #3 ELEVATION

NOTES

1. NF = NEAR FACE
2. FF = FAR FACE
3. EF = EACH FACE
4. ▲ = CUT TO FIT IN FIELD
5. 80 CLEAR UNLESS OTHERWISE SPECIFIED ON THE PLANS
6. 3000 MAX. WEEPHOLE SPACING
7. ALL LAPS NOT DETAILED SHALL BE 660(MIN)



BRIDGE 20 WINGWALL ELEVATIONS

PROJECT NAME: CHITTENDEN
 PROJECT NUMBER: STP 1443(46)

FILE NAME: 96J236/str/sj236ww.dgn
 PROJECT MANAGER: C. CARLSON
 DESIGNED BY: K. UPMAL
 iparm sj236br20ww2elev.t

PLOT DATE: 14-AUG-2009
 DRAWN BY: C. WEEBER
 CHECKED BY: C. CARLSON
 SHEET 70 OF 81