


BRIDGE 20 SUBBASE TRANSITION DIAGRAM
(NOT TO SCALE)

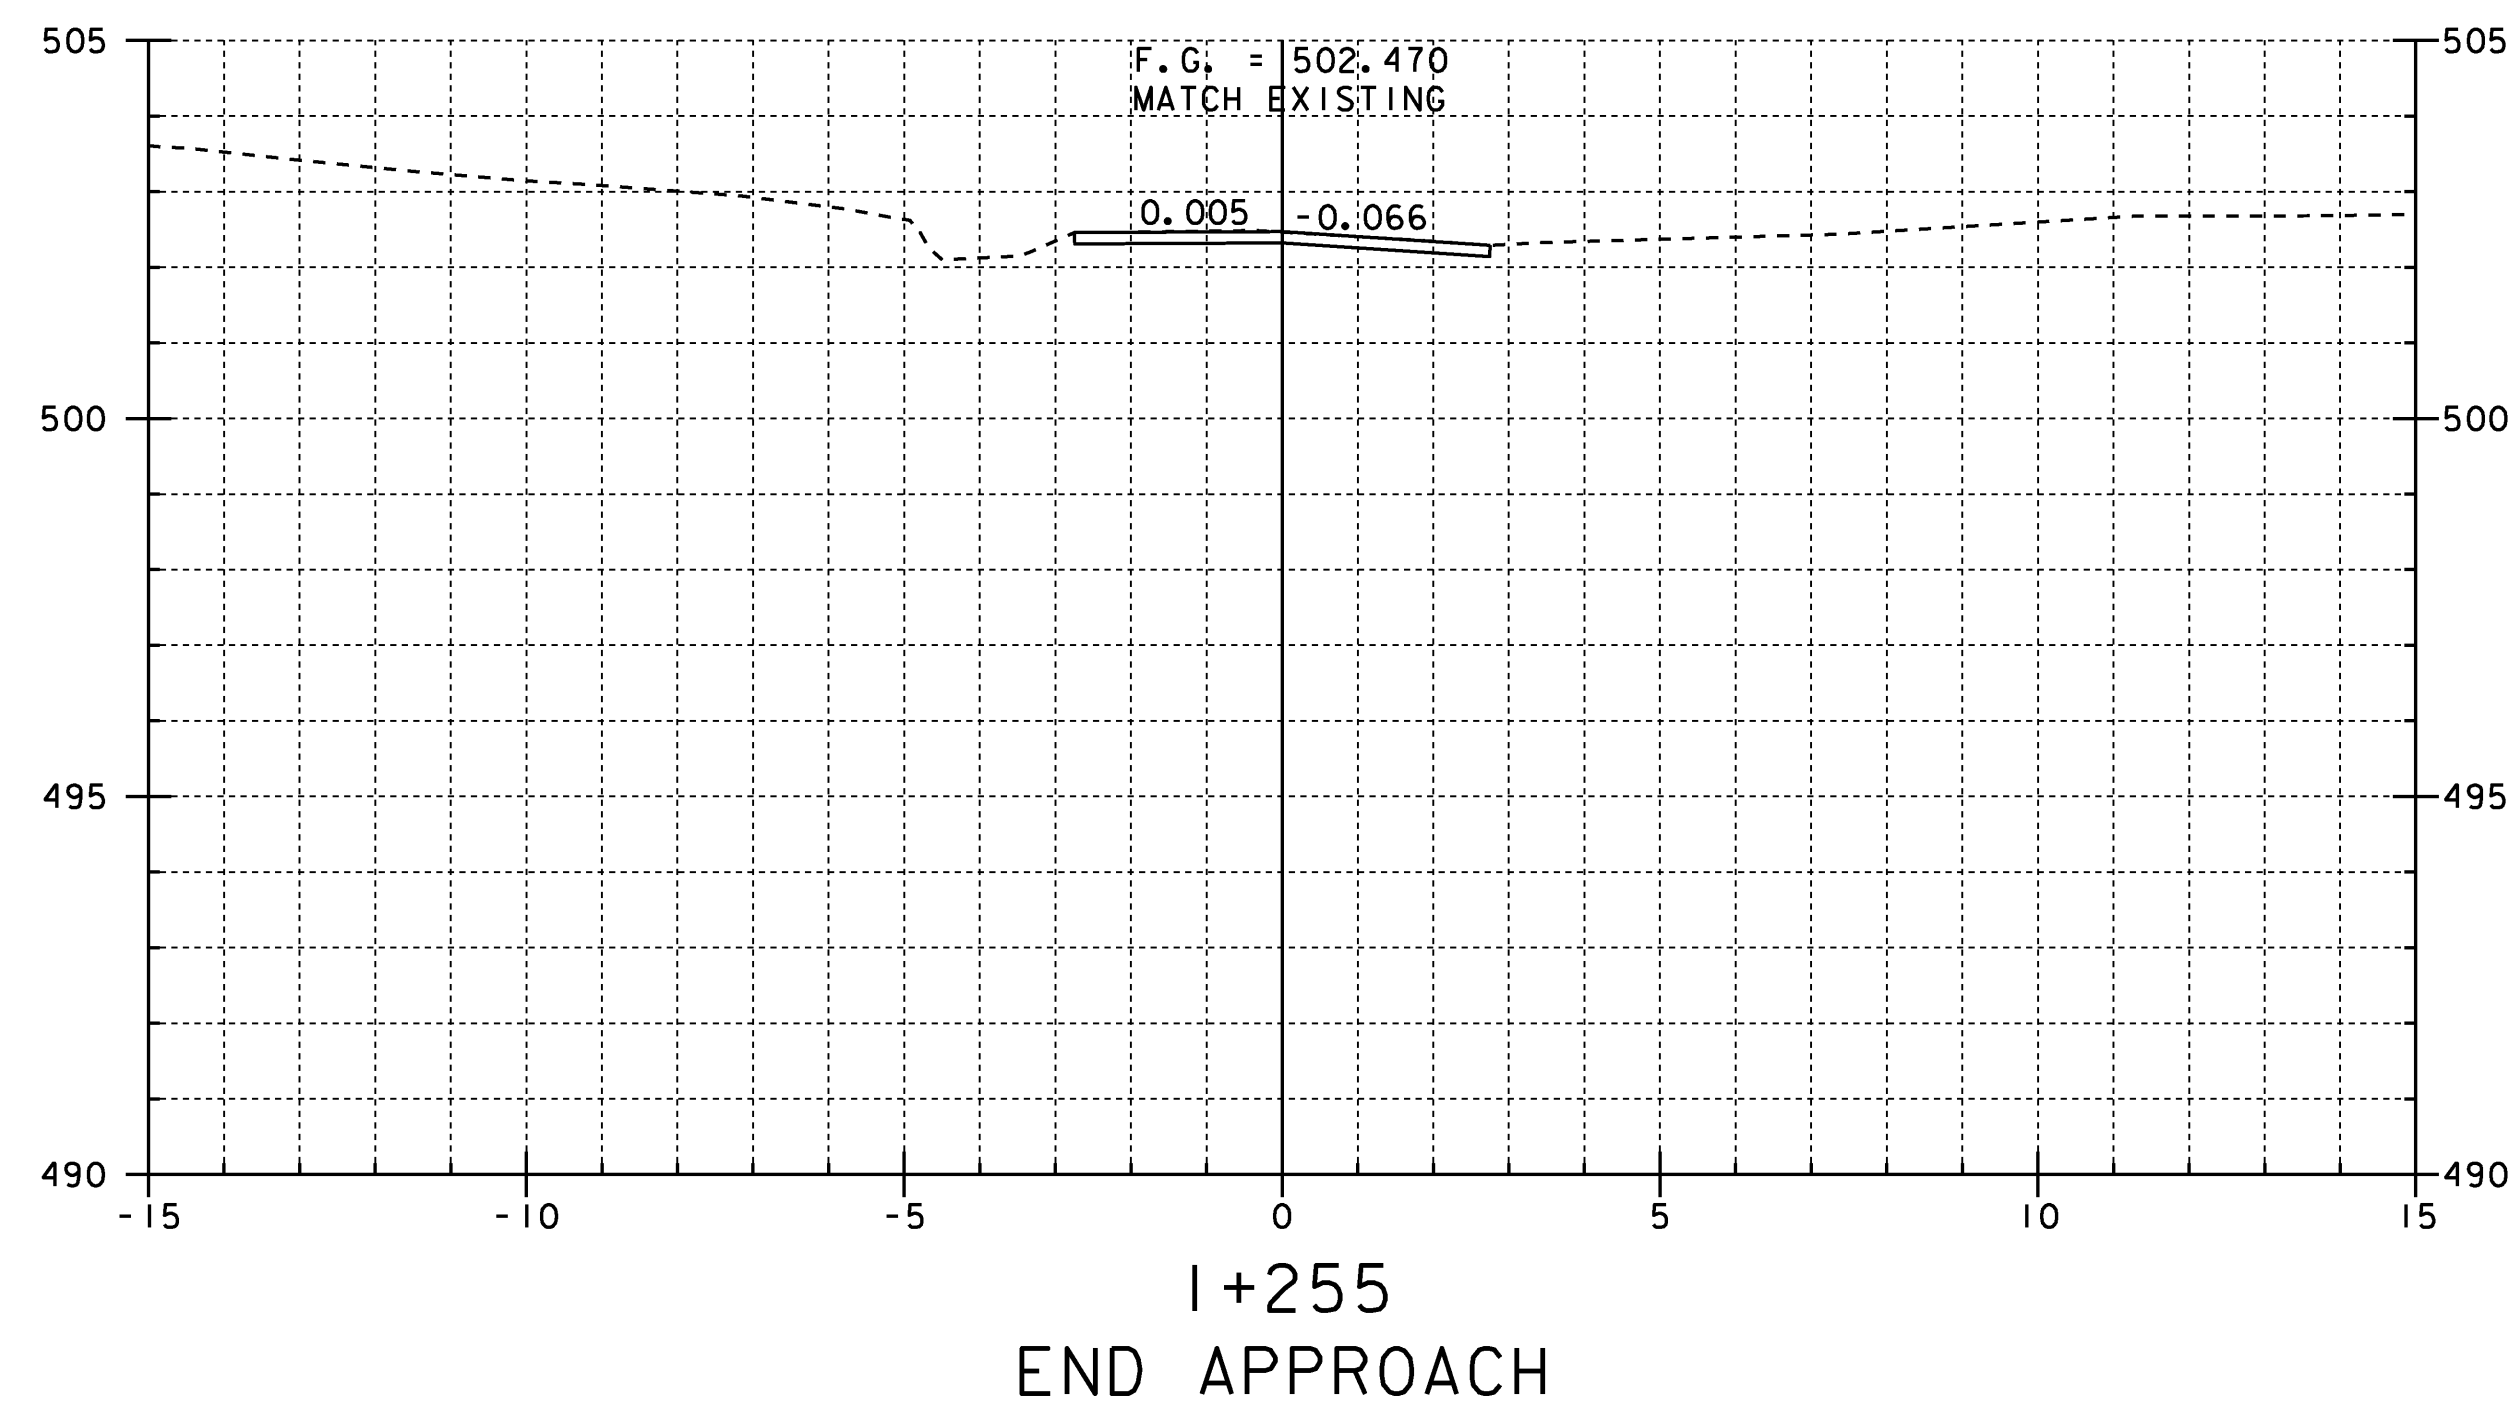

BRIDGE 20 MAINLINE CROSS SECTIONS 6

PROJECT NAME:	CHITTENDEN
PROJECT NUMBER:	STP I443(46)
FILE NAME:	/96J236/str/sj236xs.dgn
PROJECT MANAGER:	C. CARLSON
DESIGNED BY:	K. UPMAL
PLOT DATE:	14-AUG-2009
DRAWN BY:	STR
IPARM NAME:	sj236mlt
	SHEET 77 OF 81