


ABUT #1 FOOTING  
 AREA = 46.965 M<sup>2</sup>  
 W/2FT = 71.0452 M<sup>2</sup>

ABUT #2 FOOTING  
 AREA = 43.442 M<sup>2</sup>  
 W/2FT = 66.0995 M<sup>2</sup>

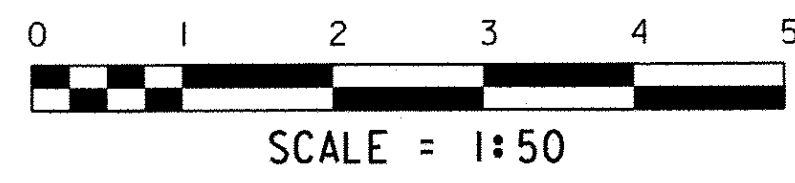

PROJECT NAME:	CHITTENDEN	FILE NAME:	96j236/str/sj236_CoffXs.dgn	PLOT DATE:	26-MAY-2010
PROJECT NUMBER:	STP 1443(45)	PROJECT LEADER:	C. CARLSON	DRAWN BY:	C. MOONEY
		DESIGNED BY:	C. CARLSON	CHECKED BY:	C. CARLSON
		BR 20 COFFERDAM LAYOUT		SHEET	1 OF 18