


7+017.80

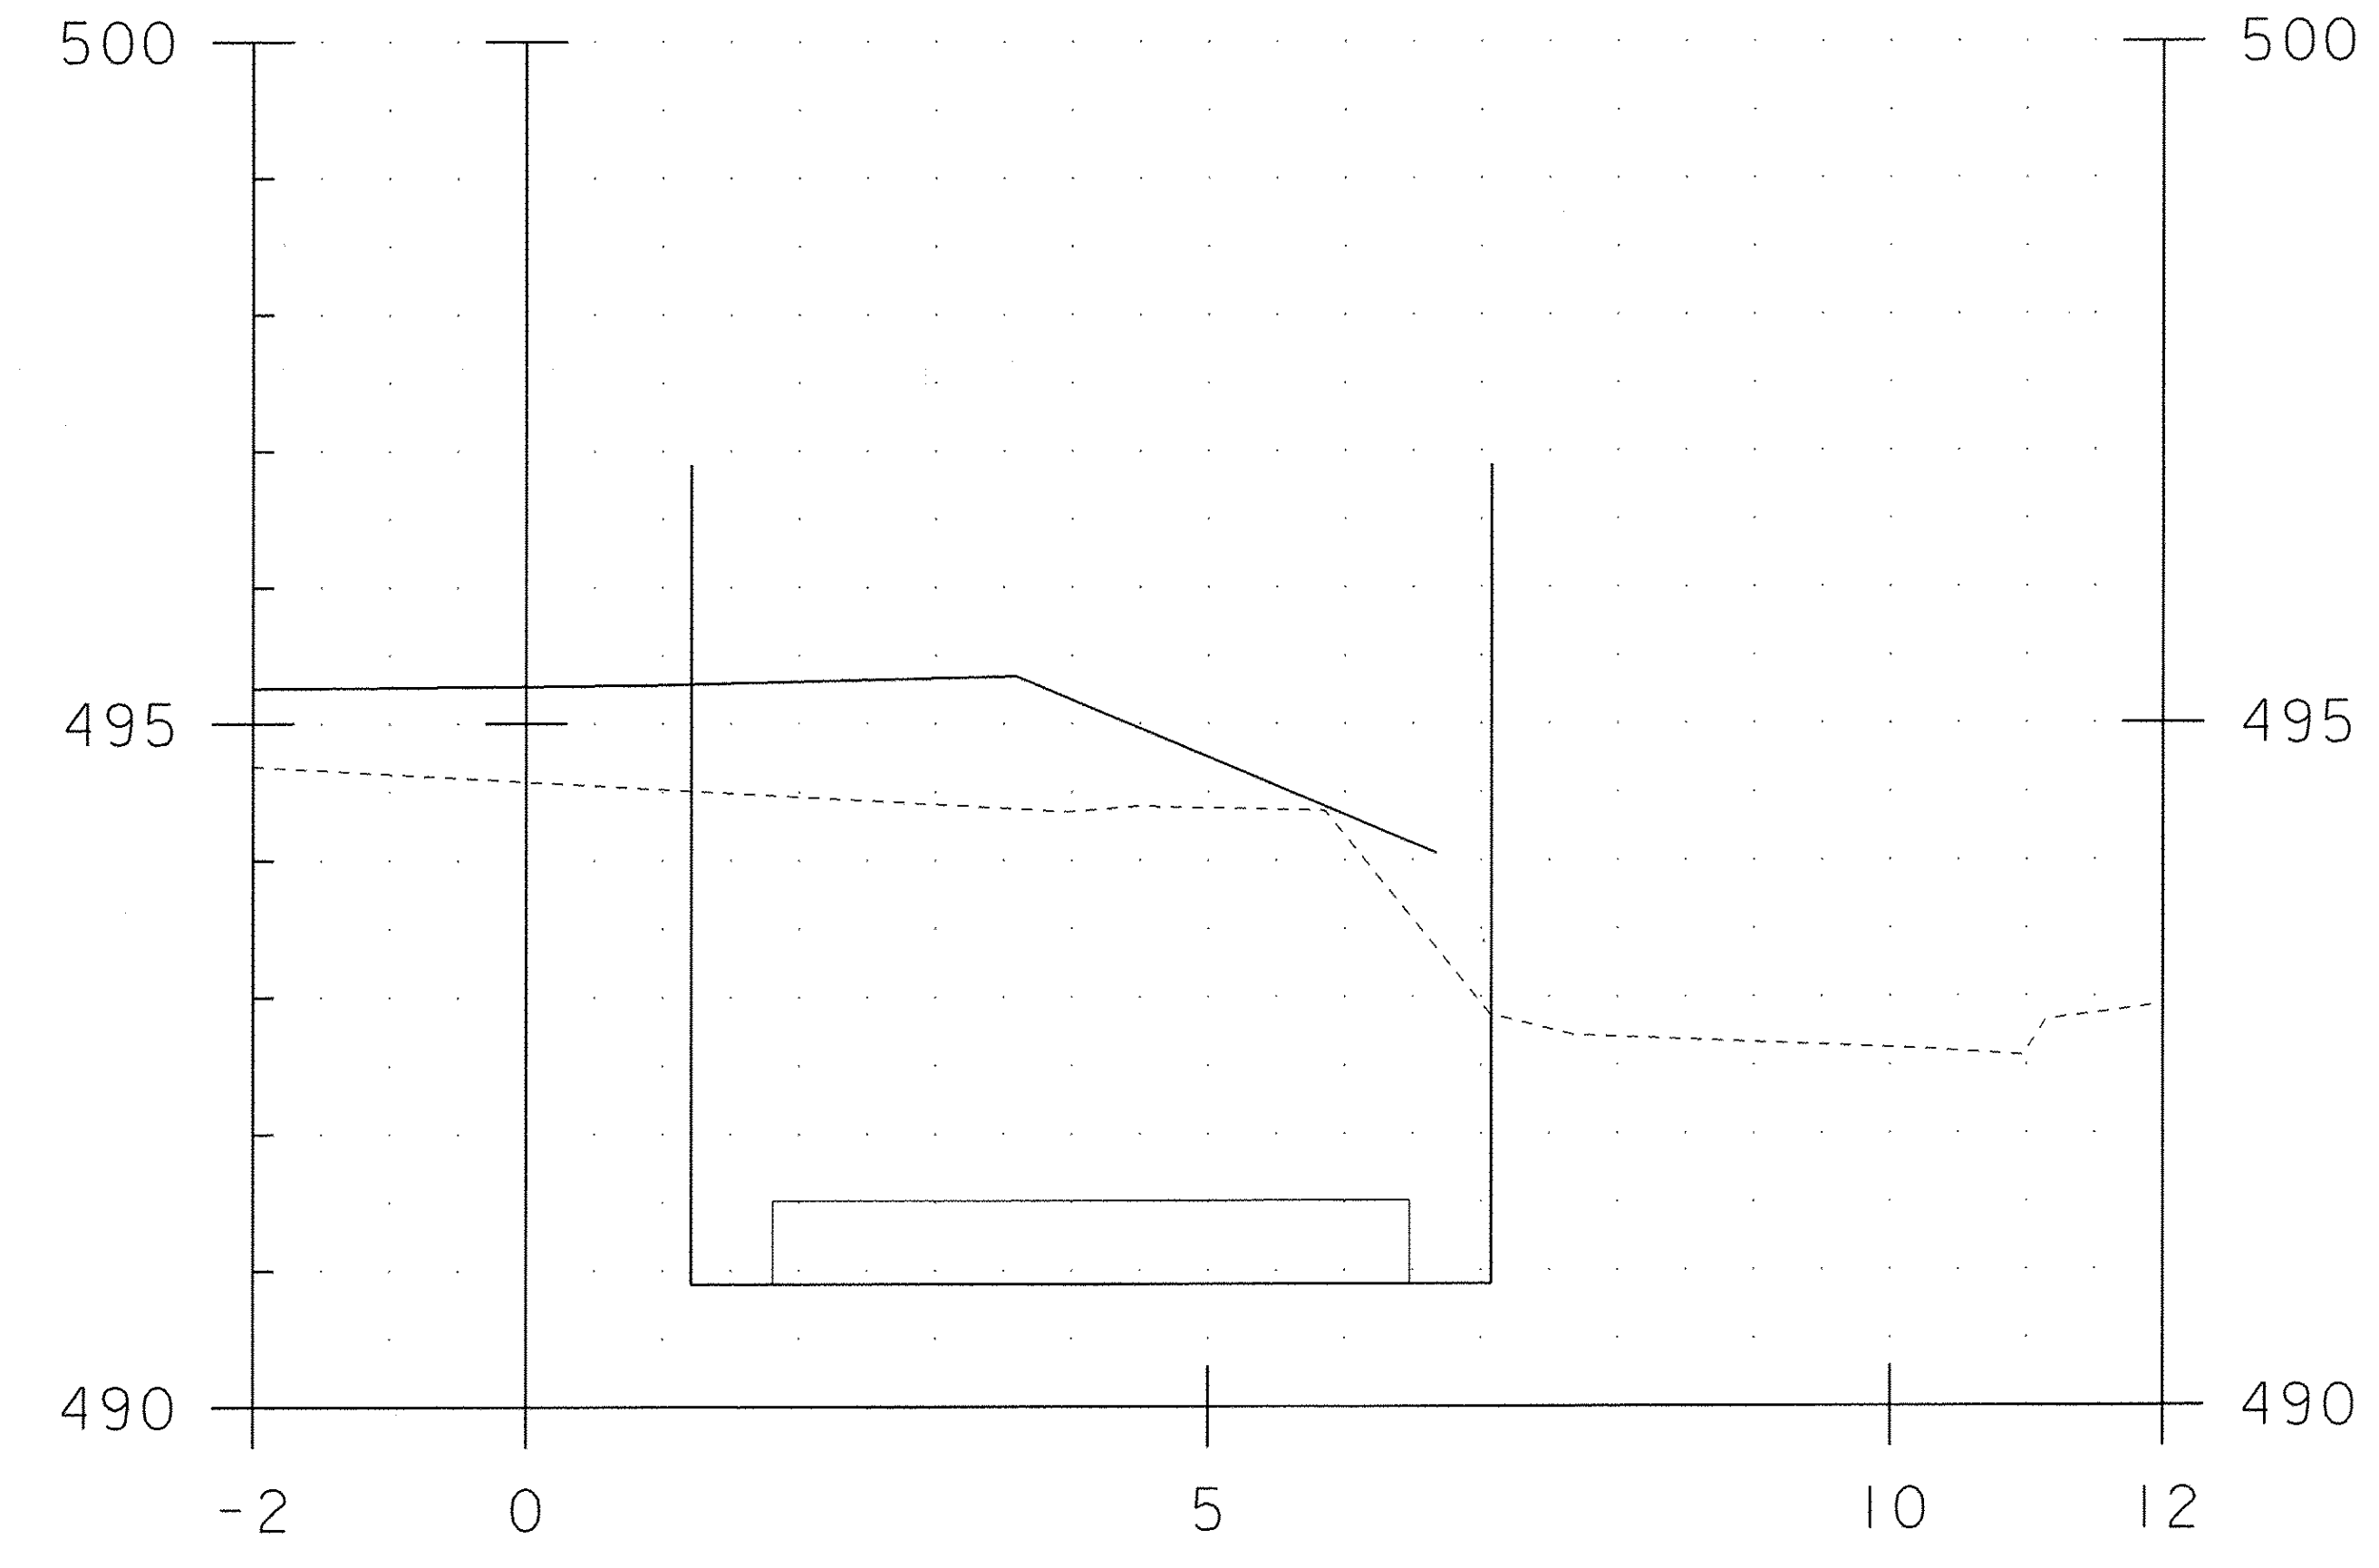

7+020.73

Coffer Ex - 19.613 m²

BRIDGE 19 ABUTMENT 1
COFFERDAM SECTIONS 1

PROJECT NAME:	CHITTENDEN	FILE NAME:	96j236/str/sj236_Coffxs.dgn	PLOT DATE:	26-MAY-2010
PROJECT NUMBER:	STP 1443(45)	PROJECT LEADER:	C. CARLSON	DRAWN BY:	C. MOONEY
		DESIGNED BY:	C. CARLSON	CHECKED BY:	C. CARLSON
		BR 19 ABUT 1 COFFERDAM XS 1		SHEET	2 OF 18

STA. 7+018 TO STA. 7+021