


7+021.58 COFFER EX - 21.7142 M²

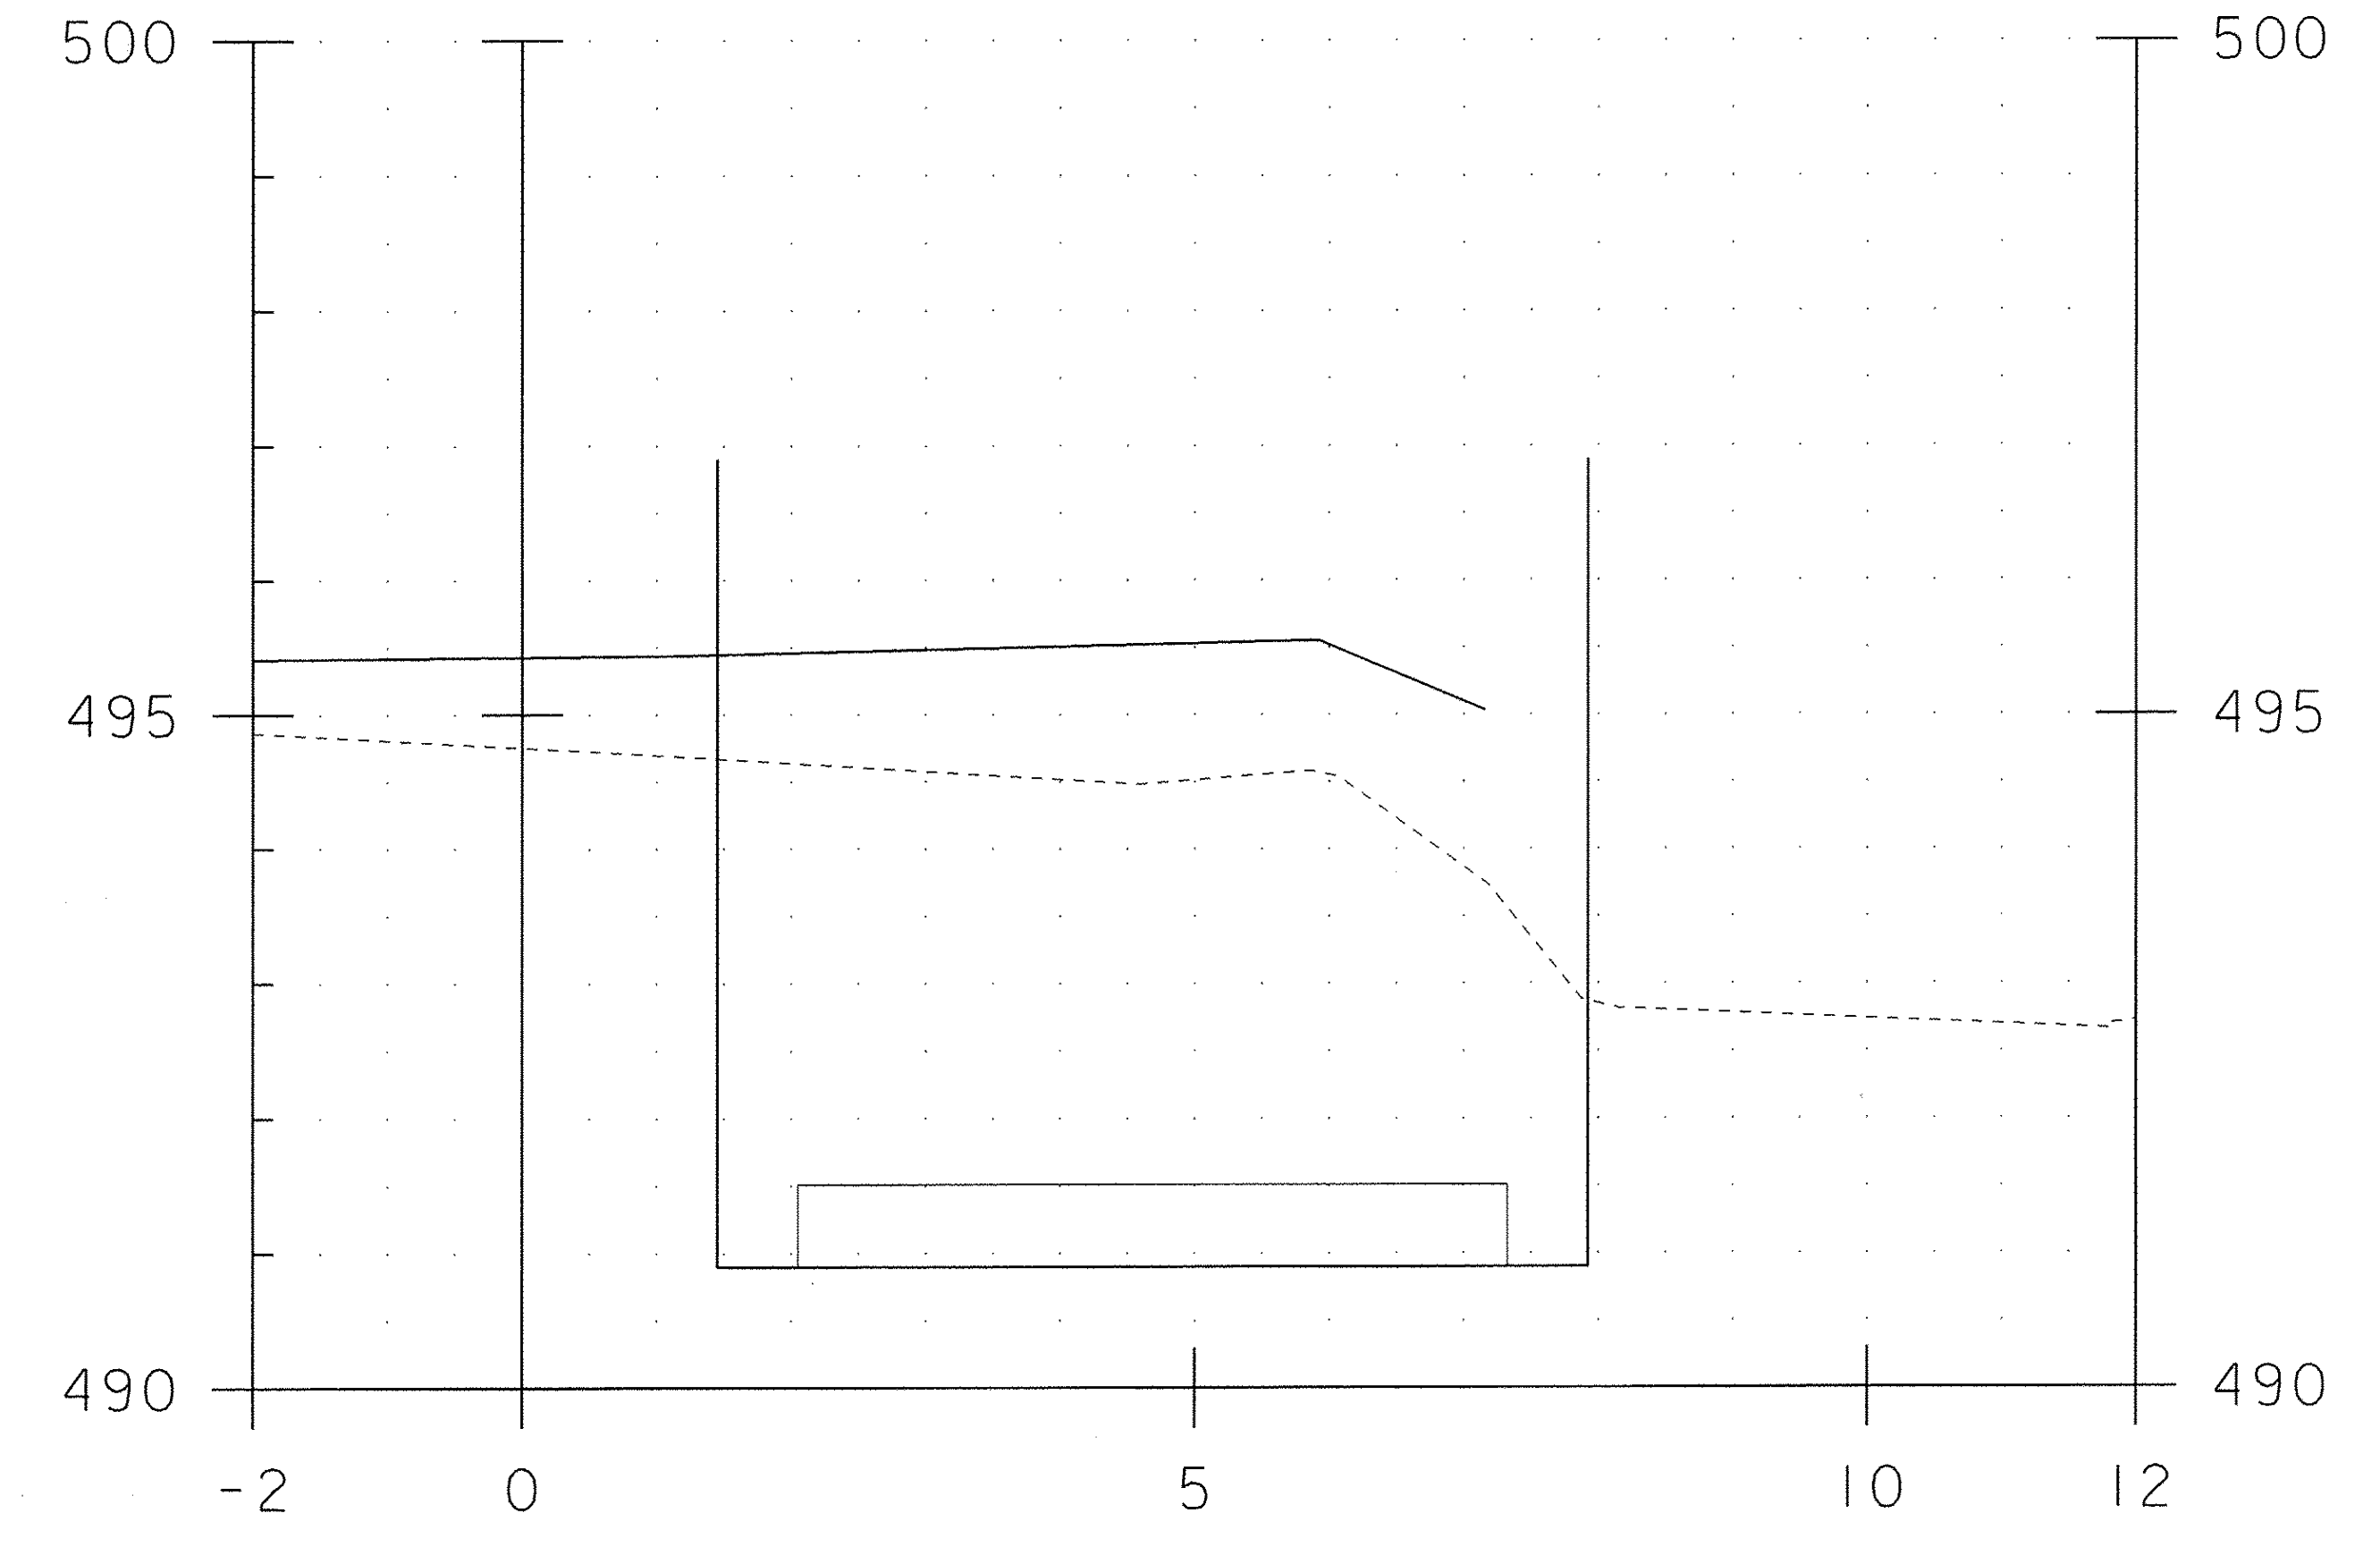

7+023.30 COFFER EX - 22.2701 M²

BRIDGE 19 ABUTMENT 1
COFFERDAM SECTIONS 2

PROJECT NAME:	CHITTENDEN	PLLOT DATE:	26-MAY-2010
PROJECT NUMBER:	STP 1443(45)	DRAWN BY:	C. MOONEY
FILE NAME:	96j236/str/sj236-CoffXs.dgn	CHECKED BY:	C. CARLSON
PROJECT LEADER:	C. CARLSON	SHEET	3 OF 18
DESIGNED BY:	C. CARLSON		
BR 19 ABUT 1 COFFERDAM XS 2			

STA. 7+022 TO STA. 7+023