


7+029.82 COFFER EX - 20.0846 M²

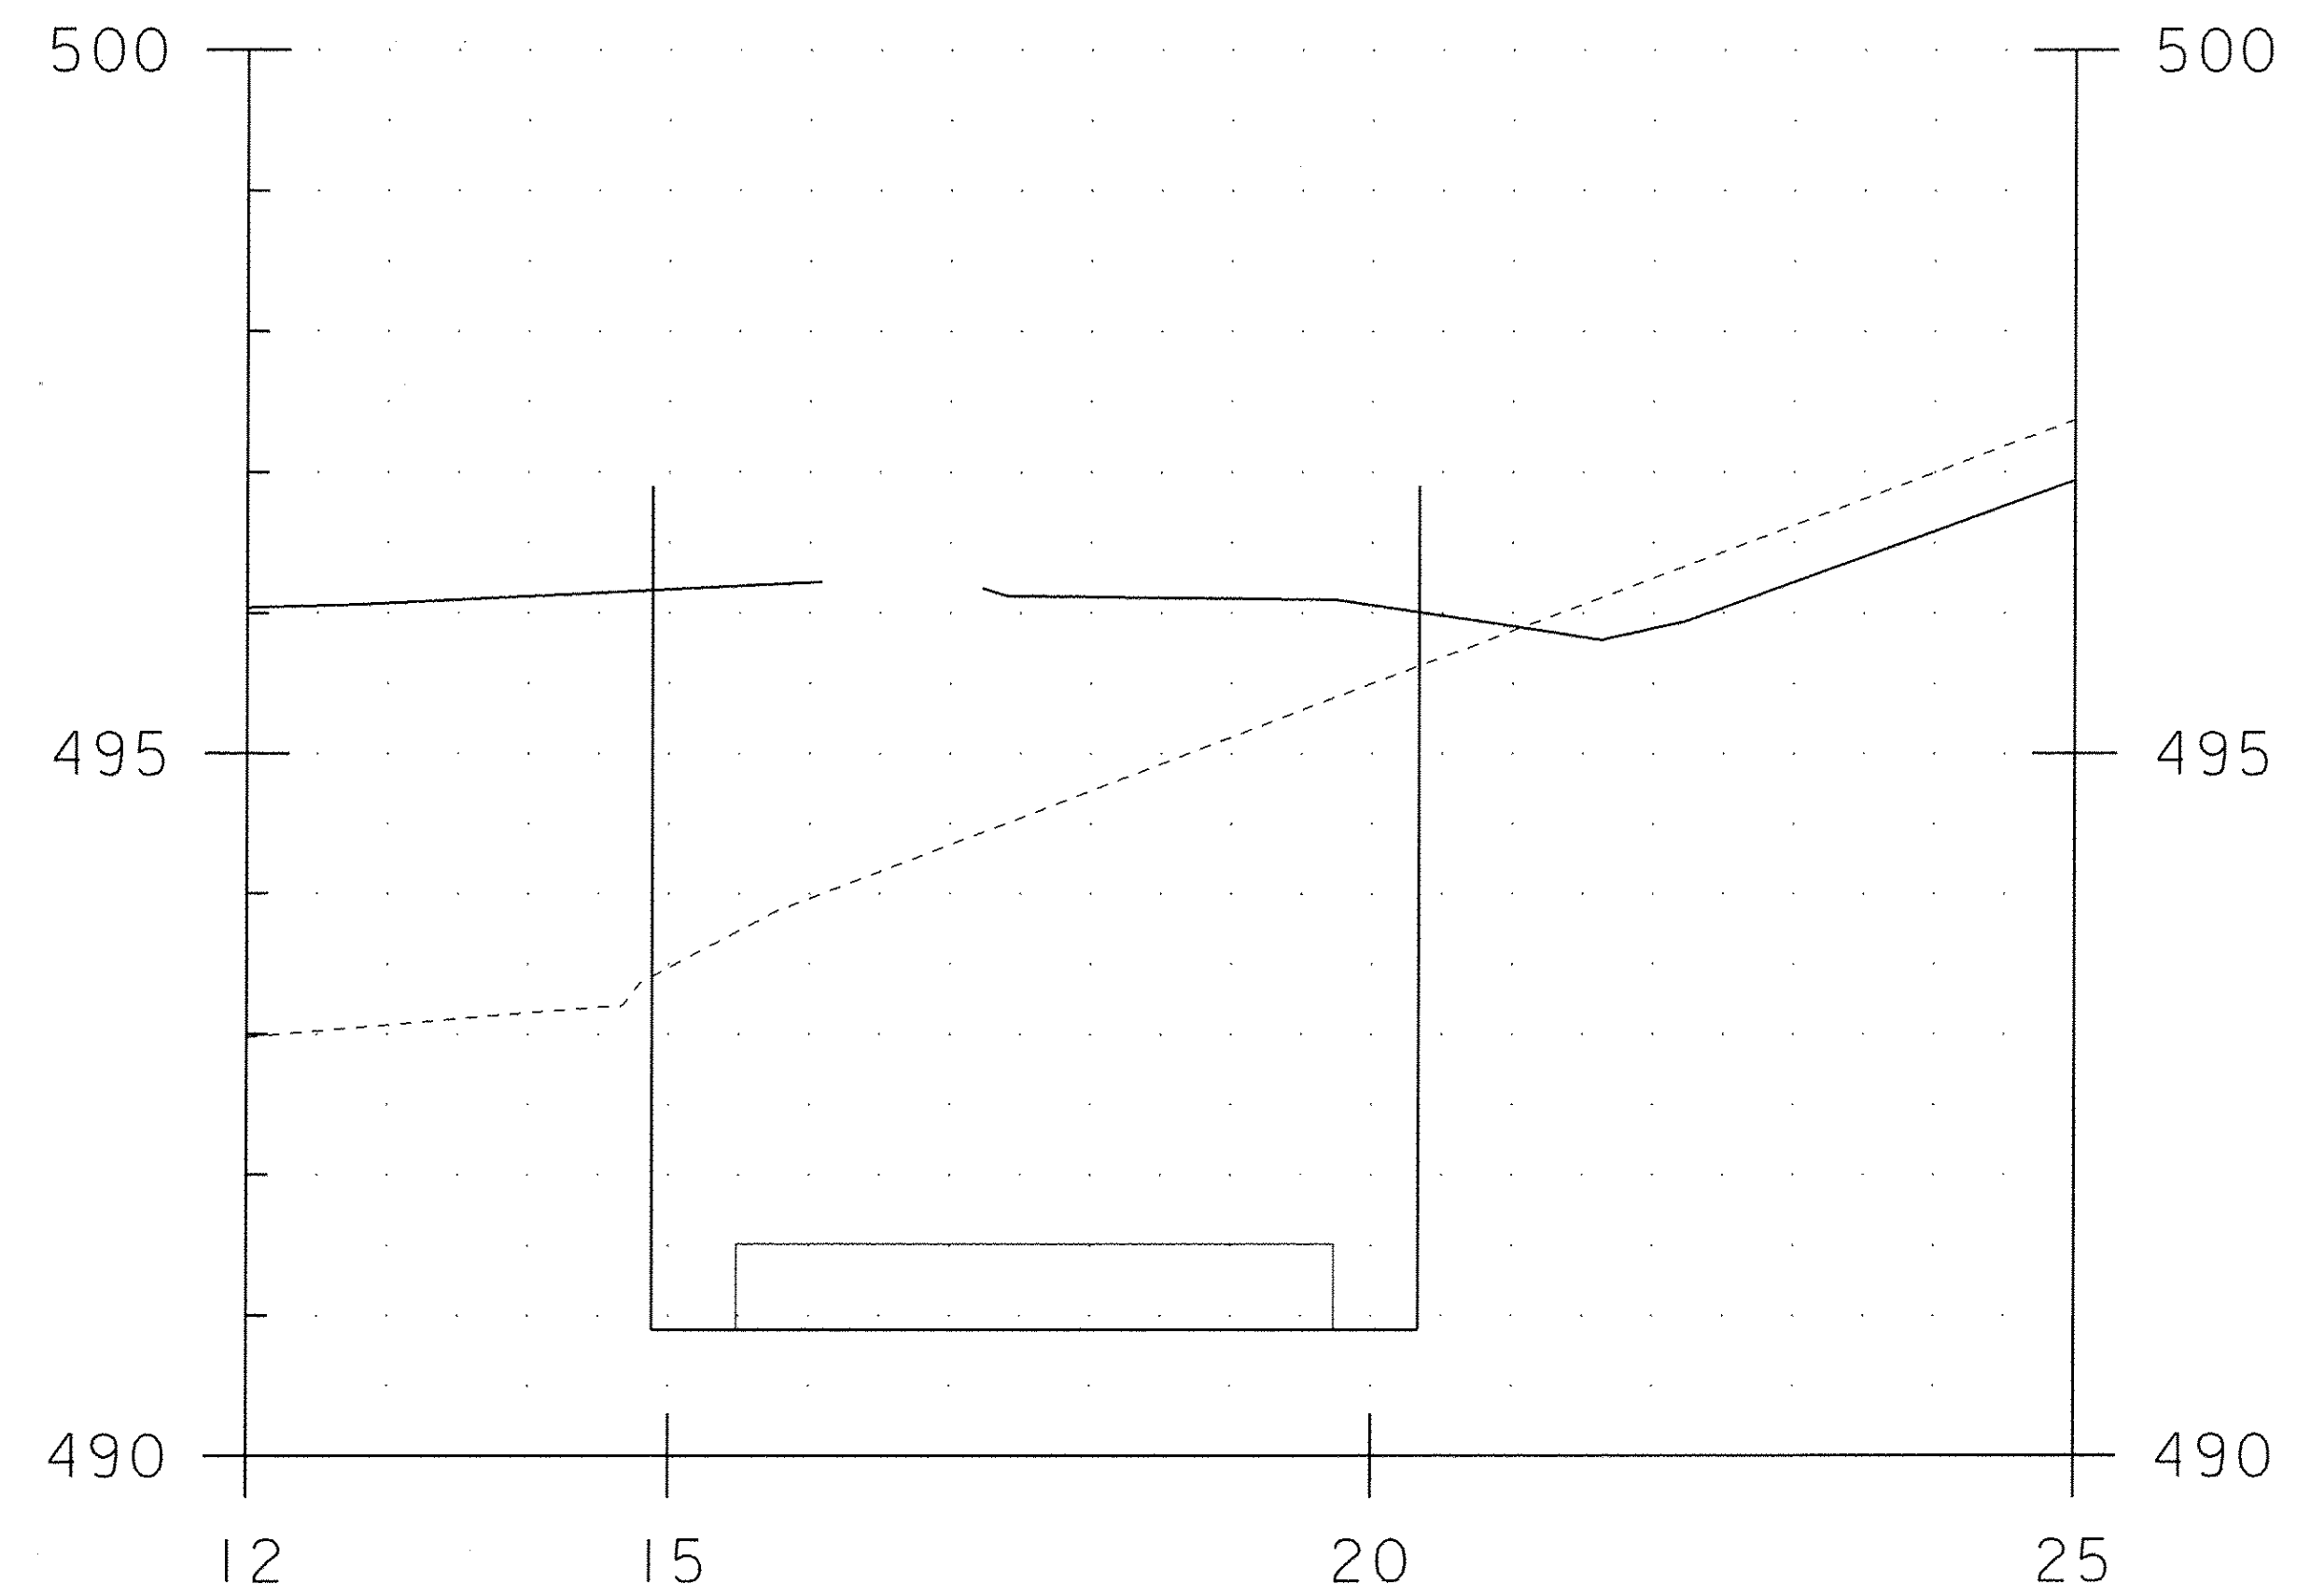

7+031.04 COFFER EX 20.0174 M²

BRIDGE 19 ABUTMENT 2
COFFERDAM SECTIONS 2

PROJECT NAME: CHITTENDEN
PROJECT NUMBER: STP 1443(45)

FILE NAME: 96j236/str/sj236-CoffXs.dgn PLOT DATE: 26-MAY-2010
PROJECT LEADER: C. CARLSON DRAWN BY: C. MOONEY
DESIGNED BY: C. CARLSON CHECKED BY: C. CARLSON
BR 19 ABUT 2 COFFERDAM XS 2 SHEET 7 OF 18

STA. 7+030 TO STA. 7+031