


ABUT. # 1 FOOTING
 AREA = 35.1605 M²
 W/2' = 54.4539 M²

ABUT. # 2 FOOTING
 AREA = 39.7228 M²
 W/2' = 61.4157 M²

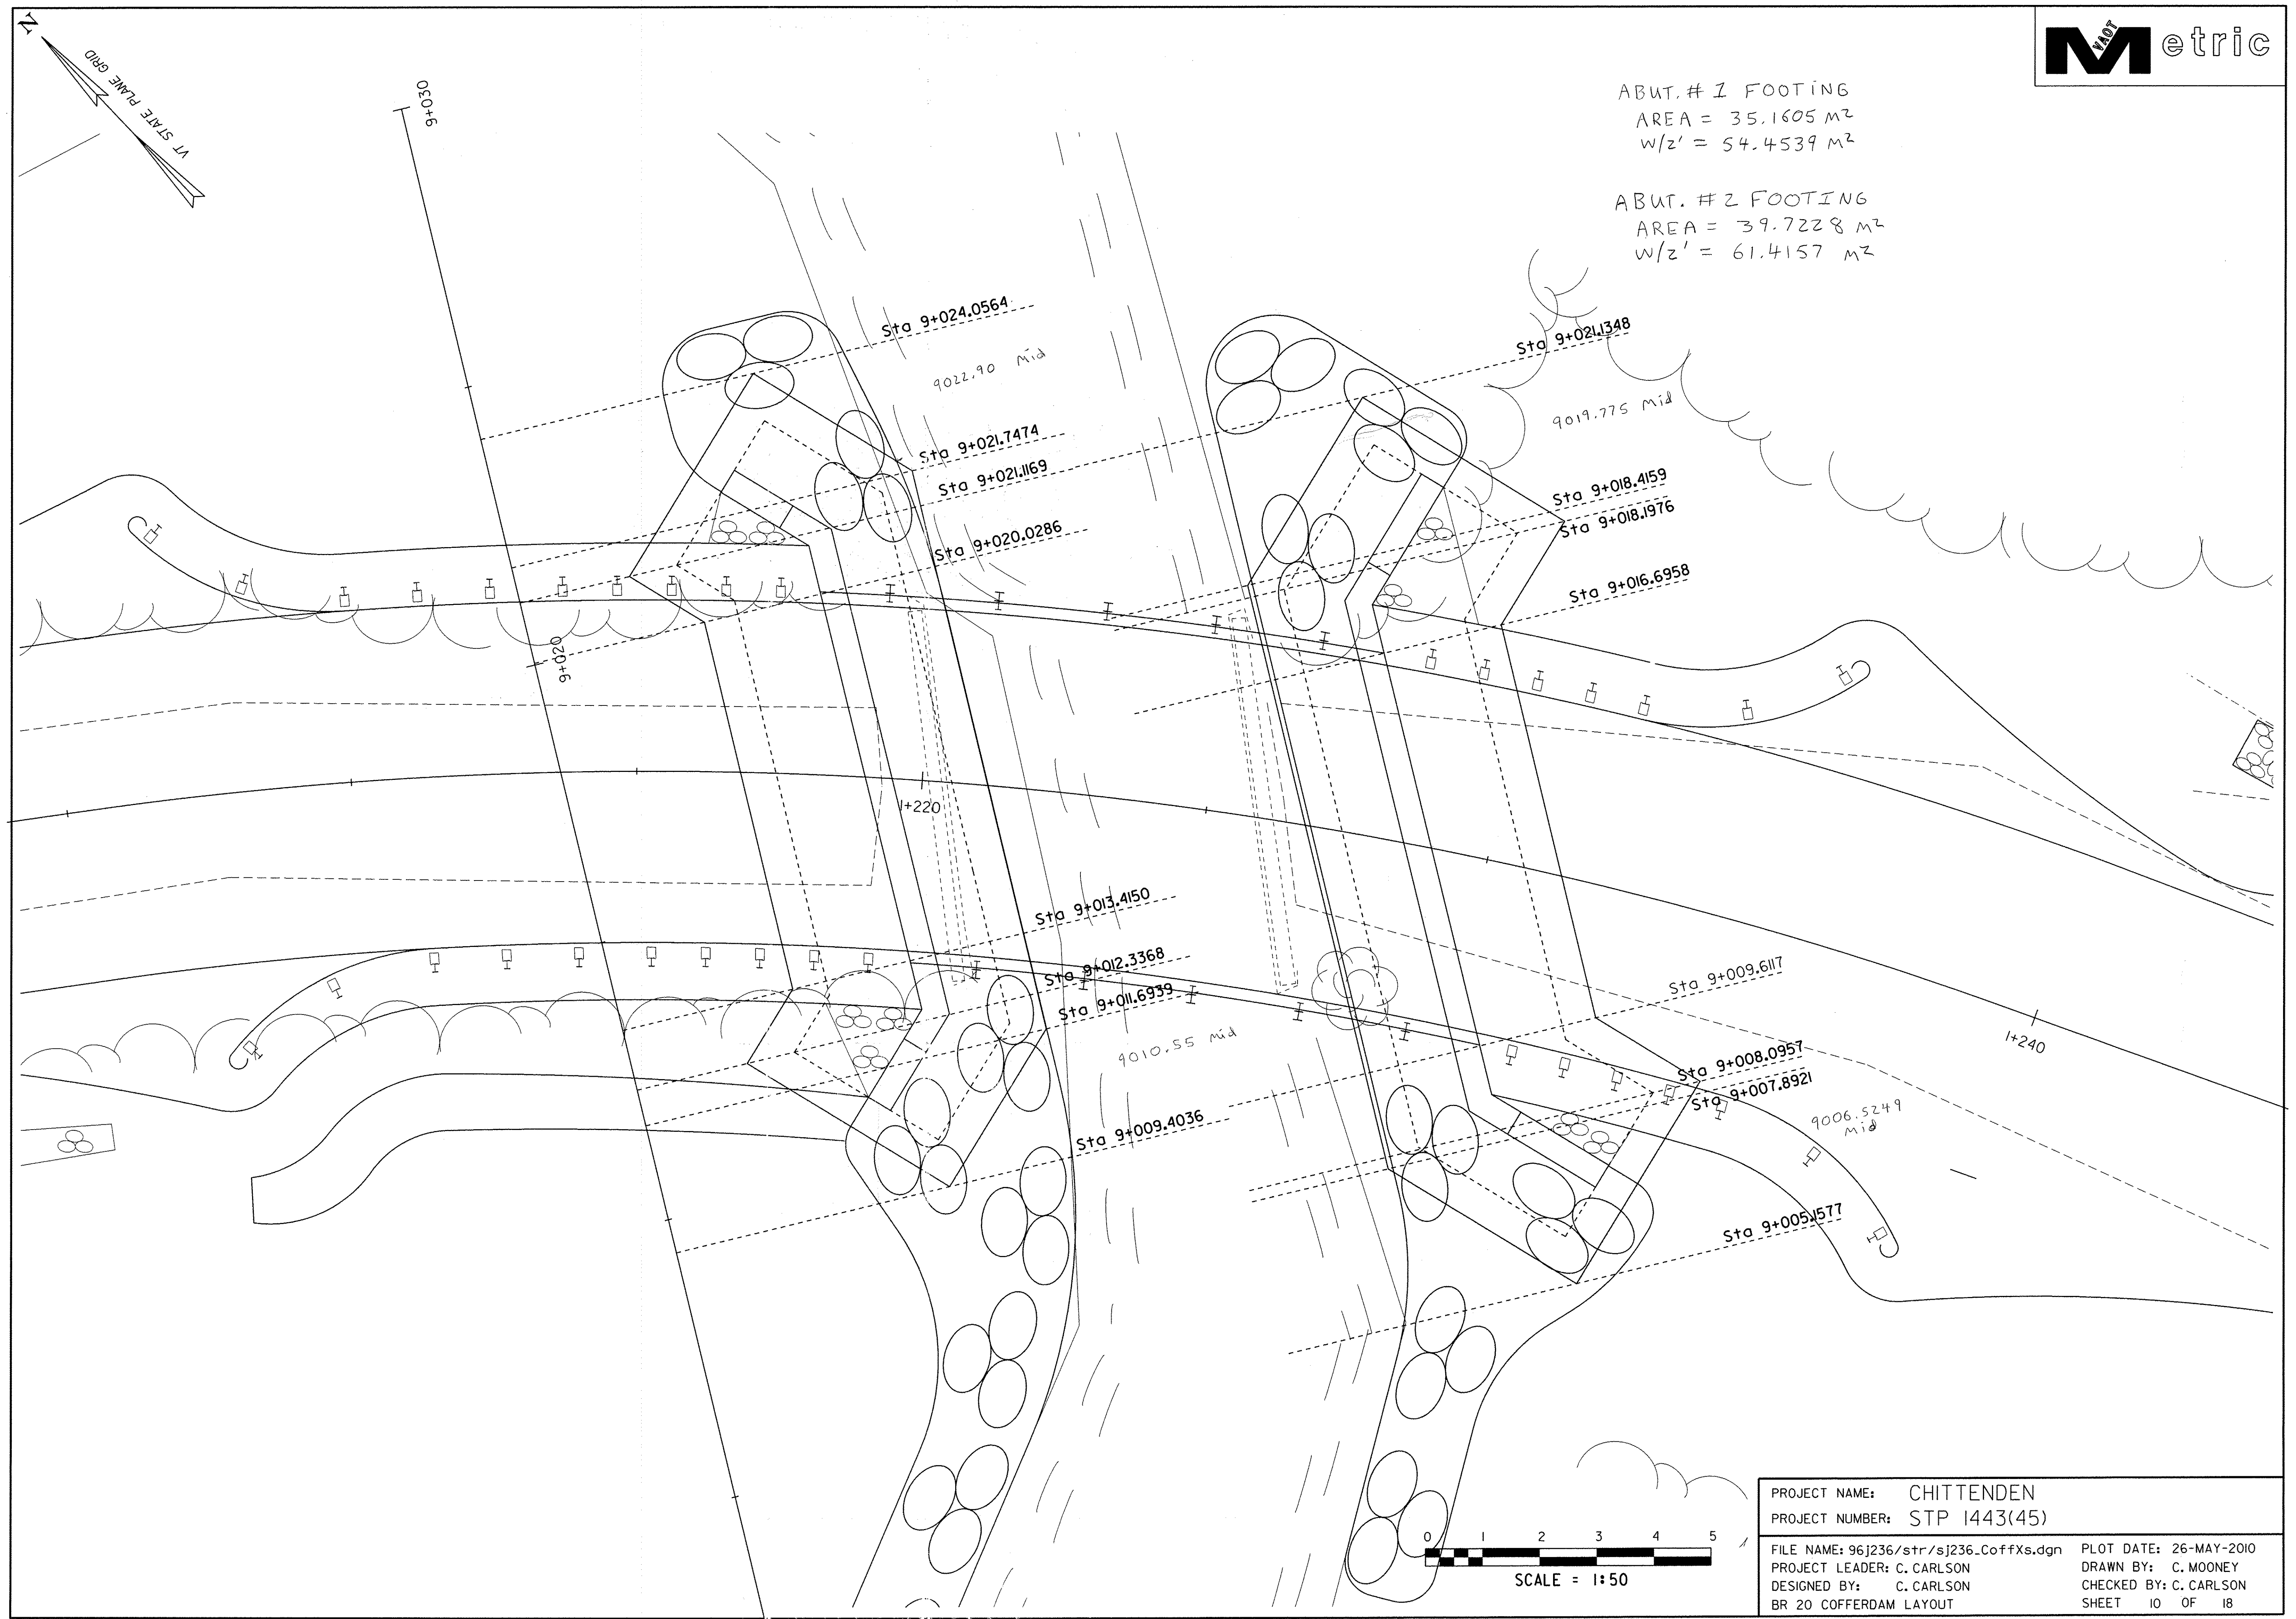

PROJECT NAME:	CHITTENDEN	PLOT DATE:	26-MAY-2010
PROJECT NUMBER:	STP 1443(45)	DRAWN BY:	C. MOONEY
FILE NAME:	96J236/str/sj236_CoffXs.dgn	DESIGNED BY:	C. CARLSON
PROJECT LEADER:	C. CARLSON	CHECKED BY:	C. CARLSON
BR 20 COFFERDAM LAYOUT		SHEET	10 OF 18