


9+009.40

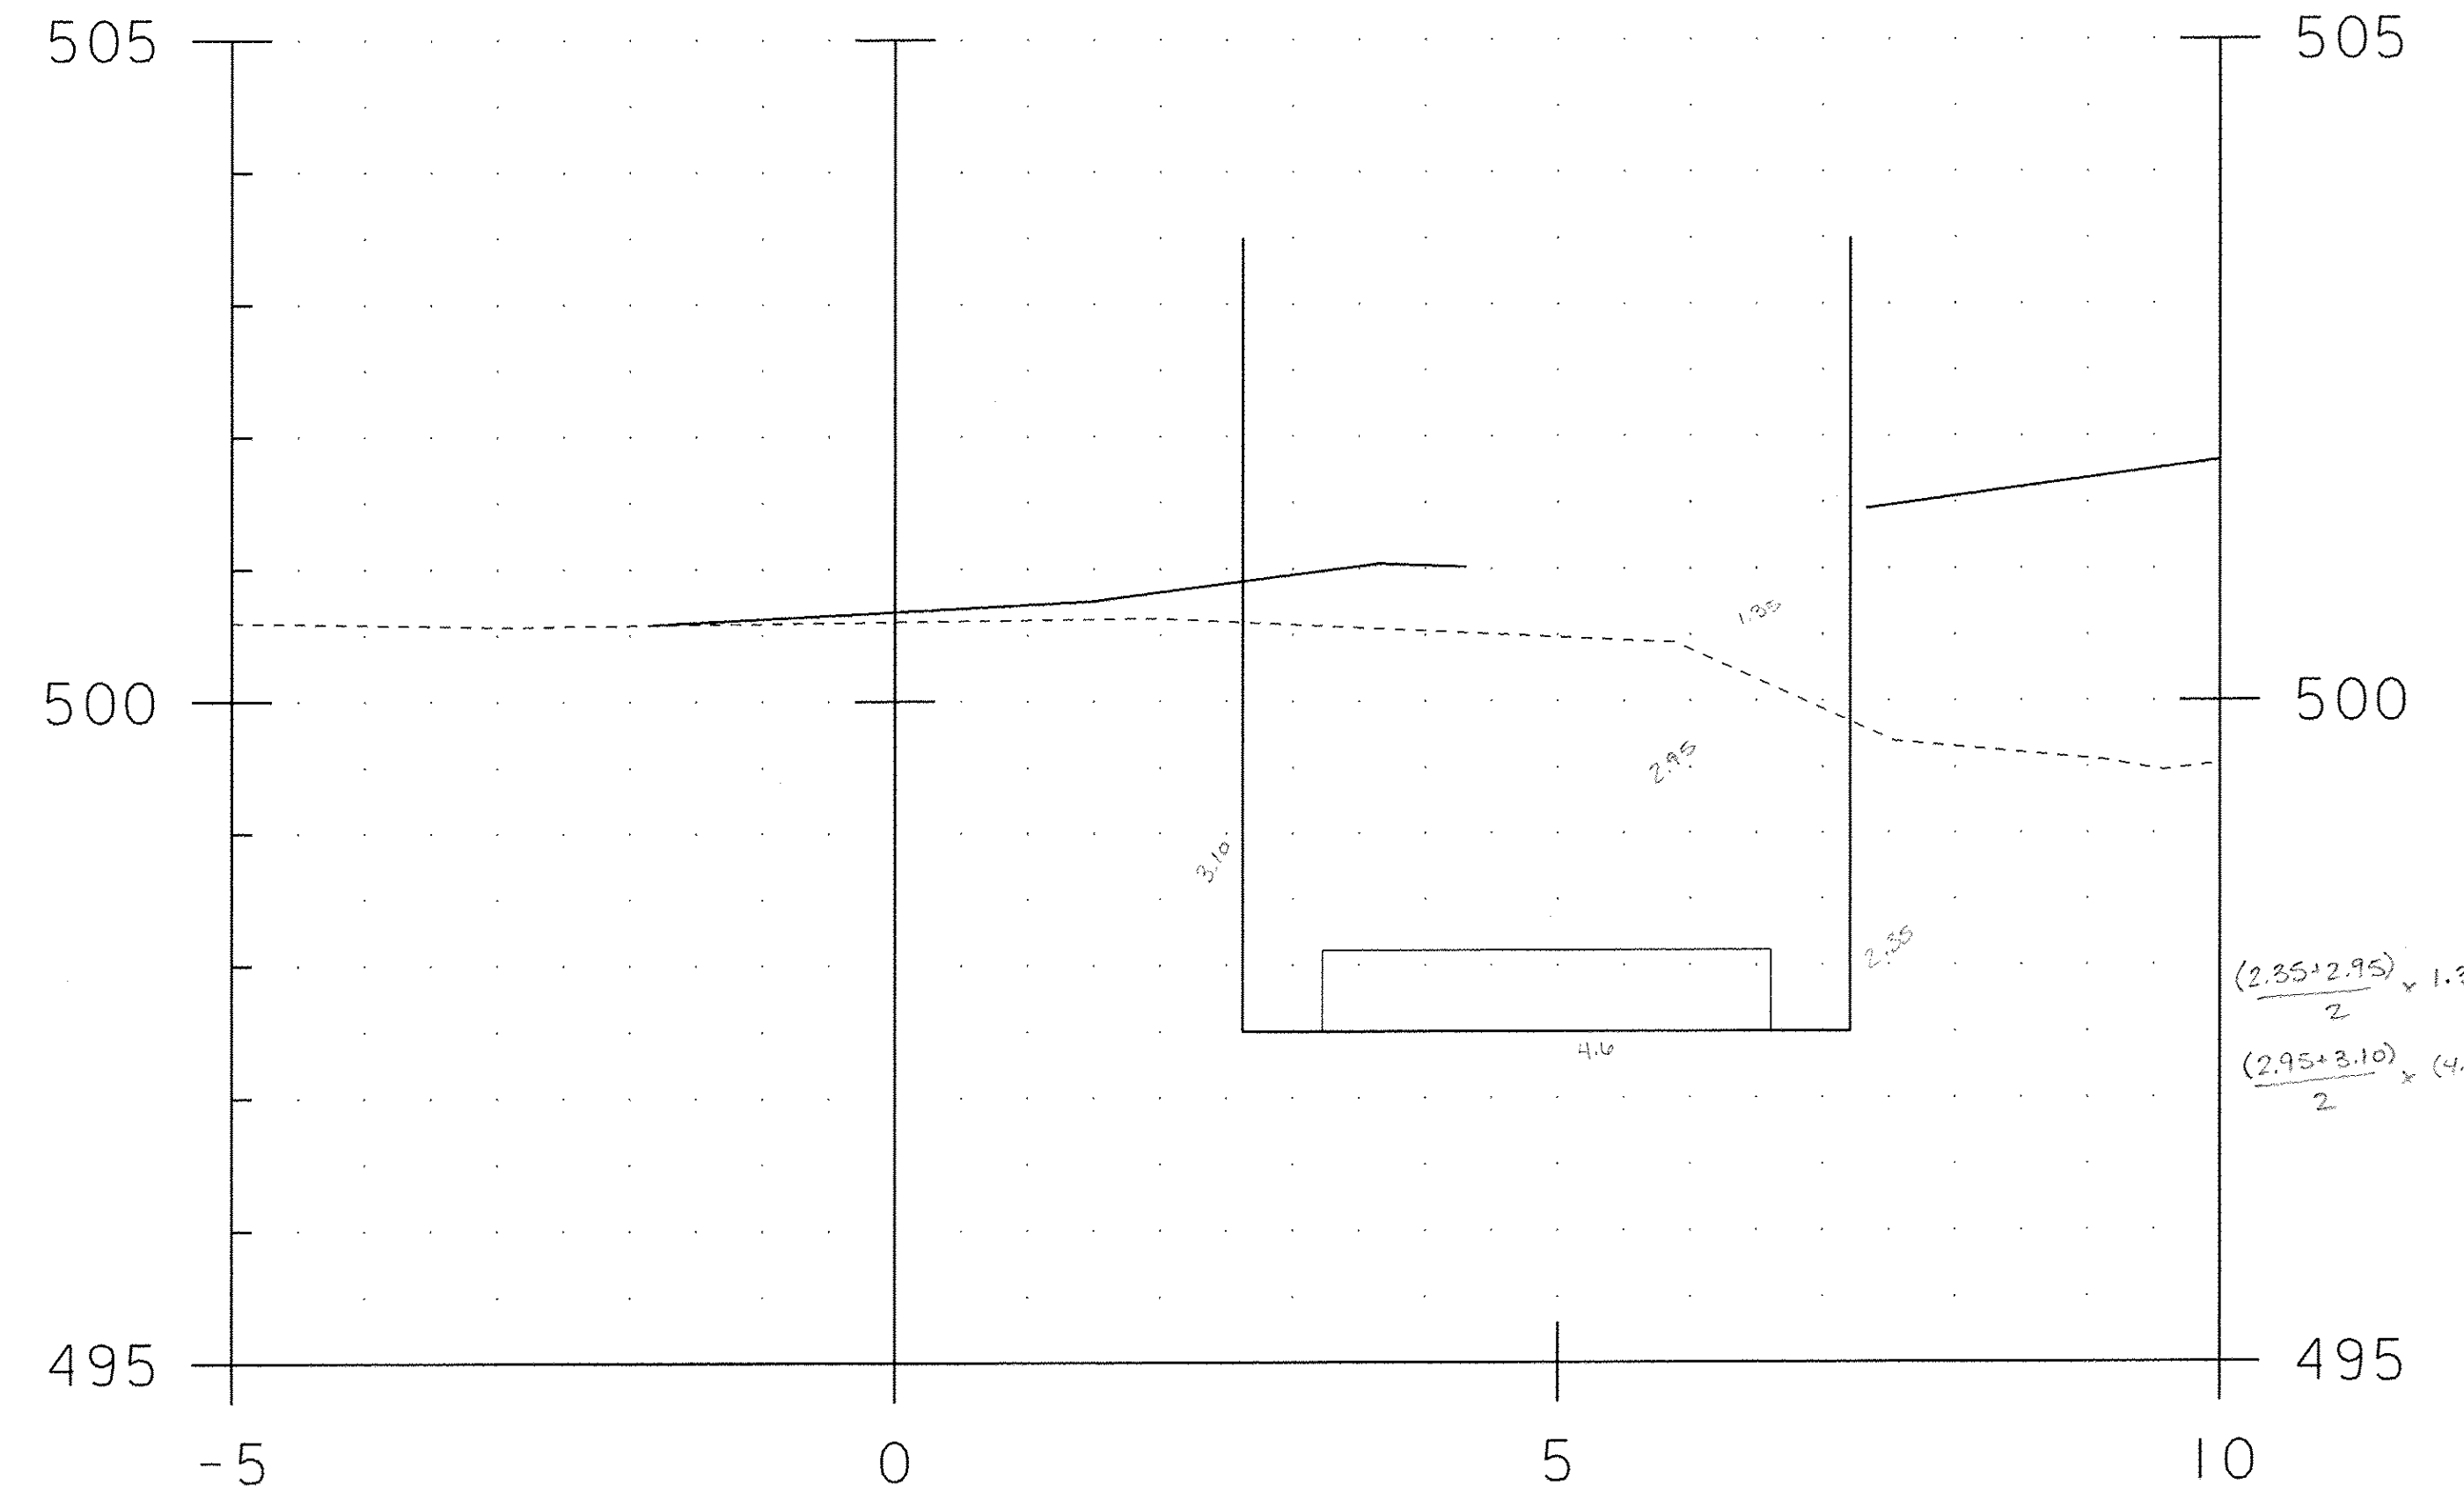

9+011.69 COFFER EX - 13.3408 m²

BRIDGE 20 ABUTMENT I
COFFERDAM SECTIONS I

PROJECT NAME:	CHITTENDEN
PROJECT NUMBER:	STP 1443(45)
FILE NAME:	96j236/str/sj236_Coffxs.dgn
PROJECT LEADER:	C. CARLSON
DESIGNED BY:	C. CARLSON
BR 20 ABUT I COFFERDAM XS I	
PLOT DATE:	26-MAY-2010
DRAWN BY:	C. MOONEY
CHECKED BY:	C. CARLSON
SHEET	II OF 18

STA. 9+009 TO STA. 9+012