


9+012.34 COFFER EX - 15.4372 M²

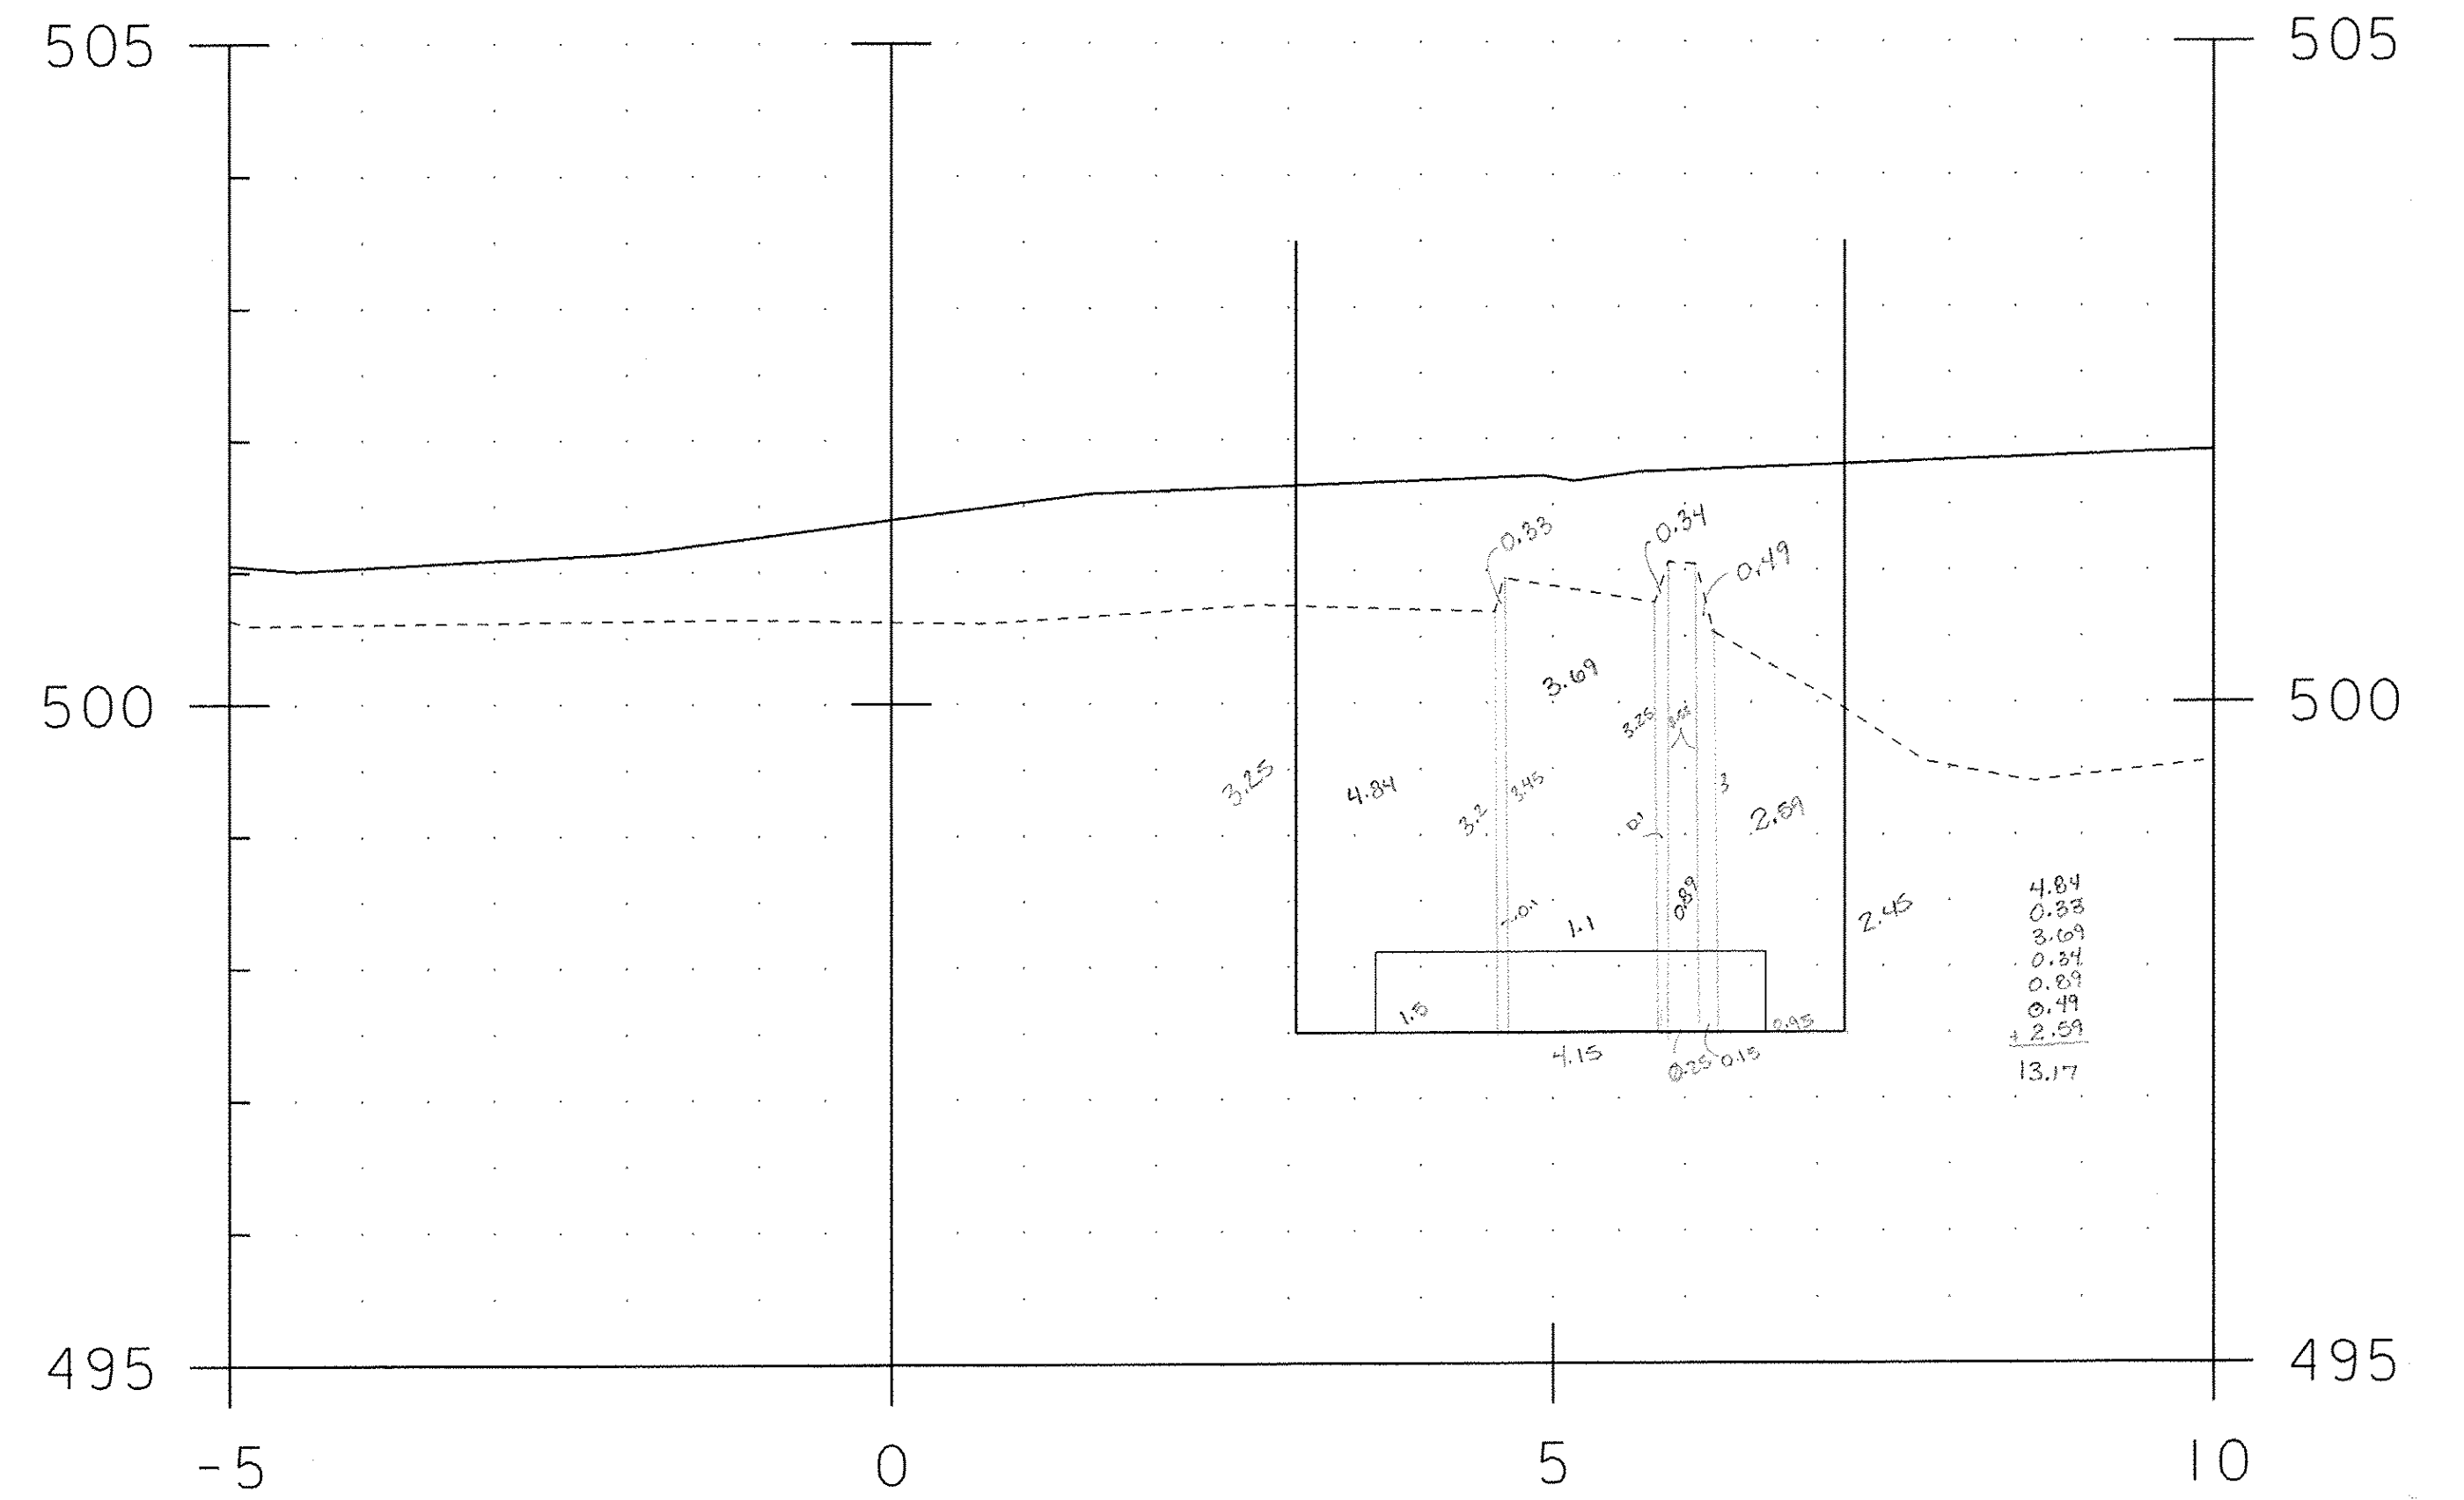

9+013.42 COFFER EX - 13.1257 M²

BRIDGE 20 ABUTMENT 1
COFFERDAM SECTIONS 2

PROJECT NAME:	CHITTENDEN	PLOT DATE:	26-MAY-2010
PROJECT NUMBER:	STP 1443(45)	DRAWN BY:	C. MOONEY
FILE NAME:	96J236/str/sj236_CoffXs.dgn	CHECKED BY:	C. CARLSON
PROJECT LEADER:	C. CARLSON	SHEET	12 OF 18
DESIGNED BY:	C. CARLSON		

STA. 9+012 TO STA. 9+013