


9+005.16

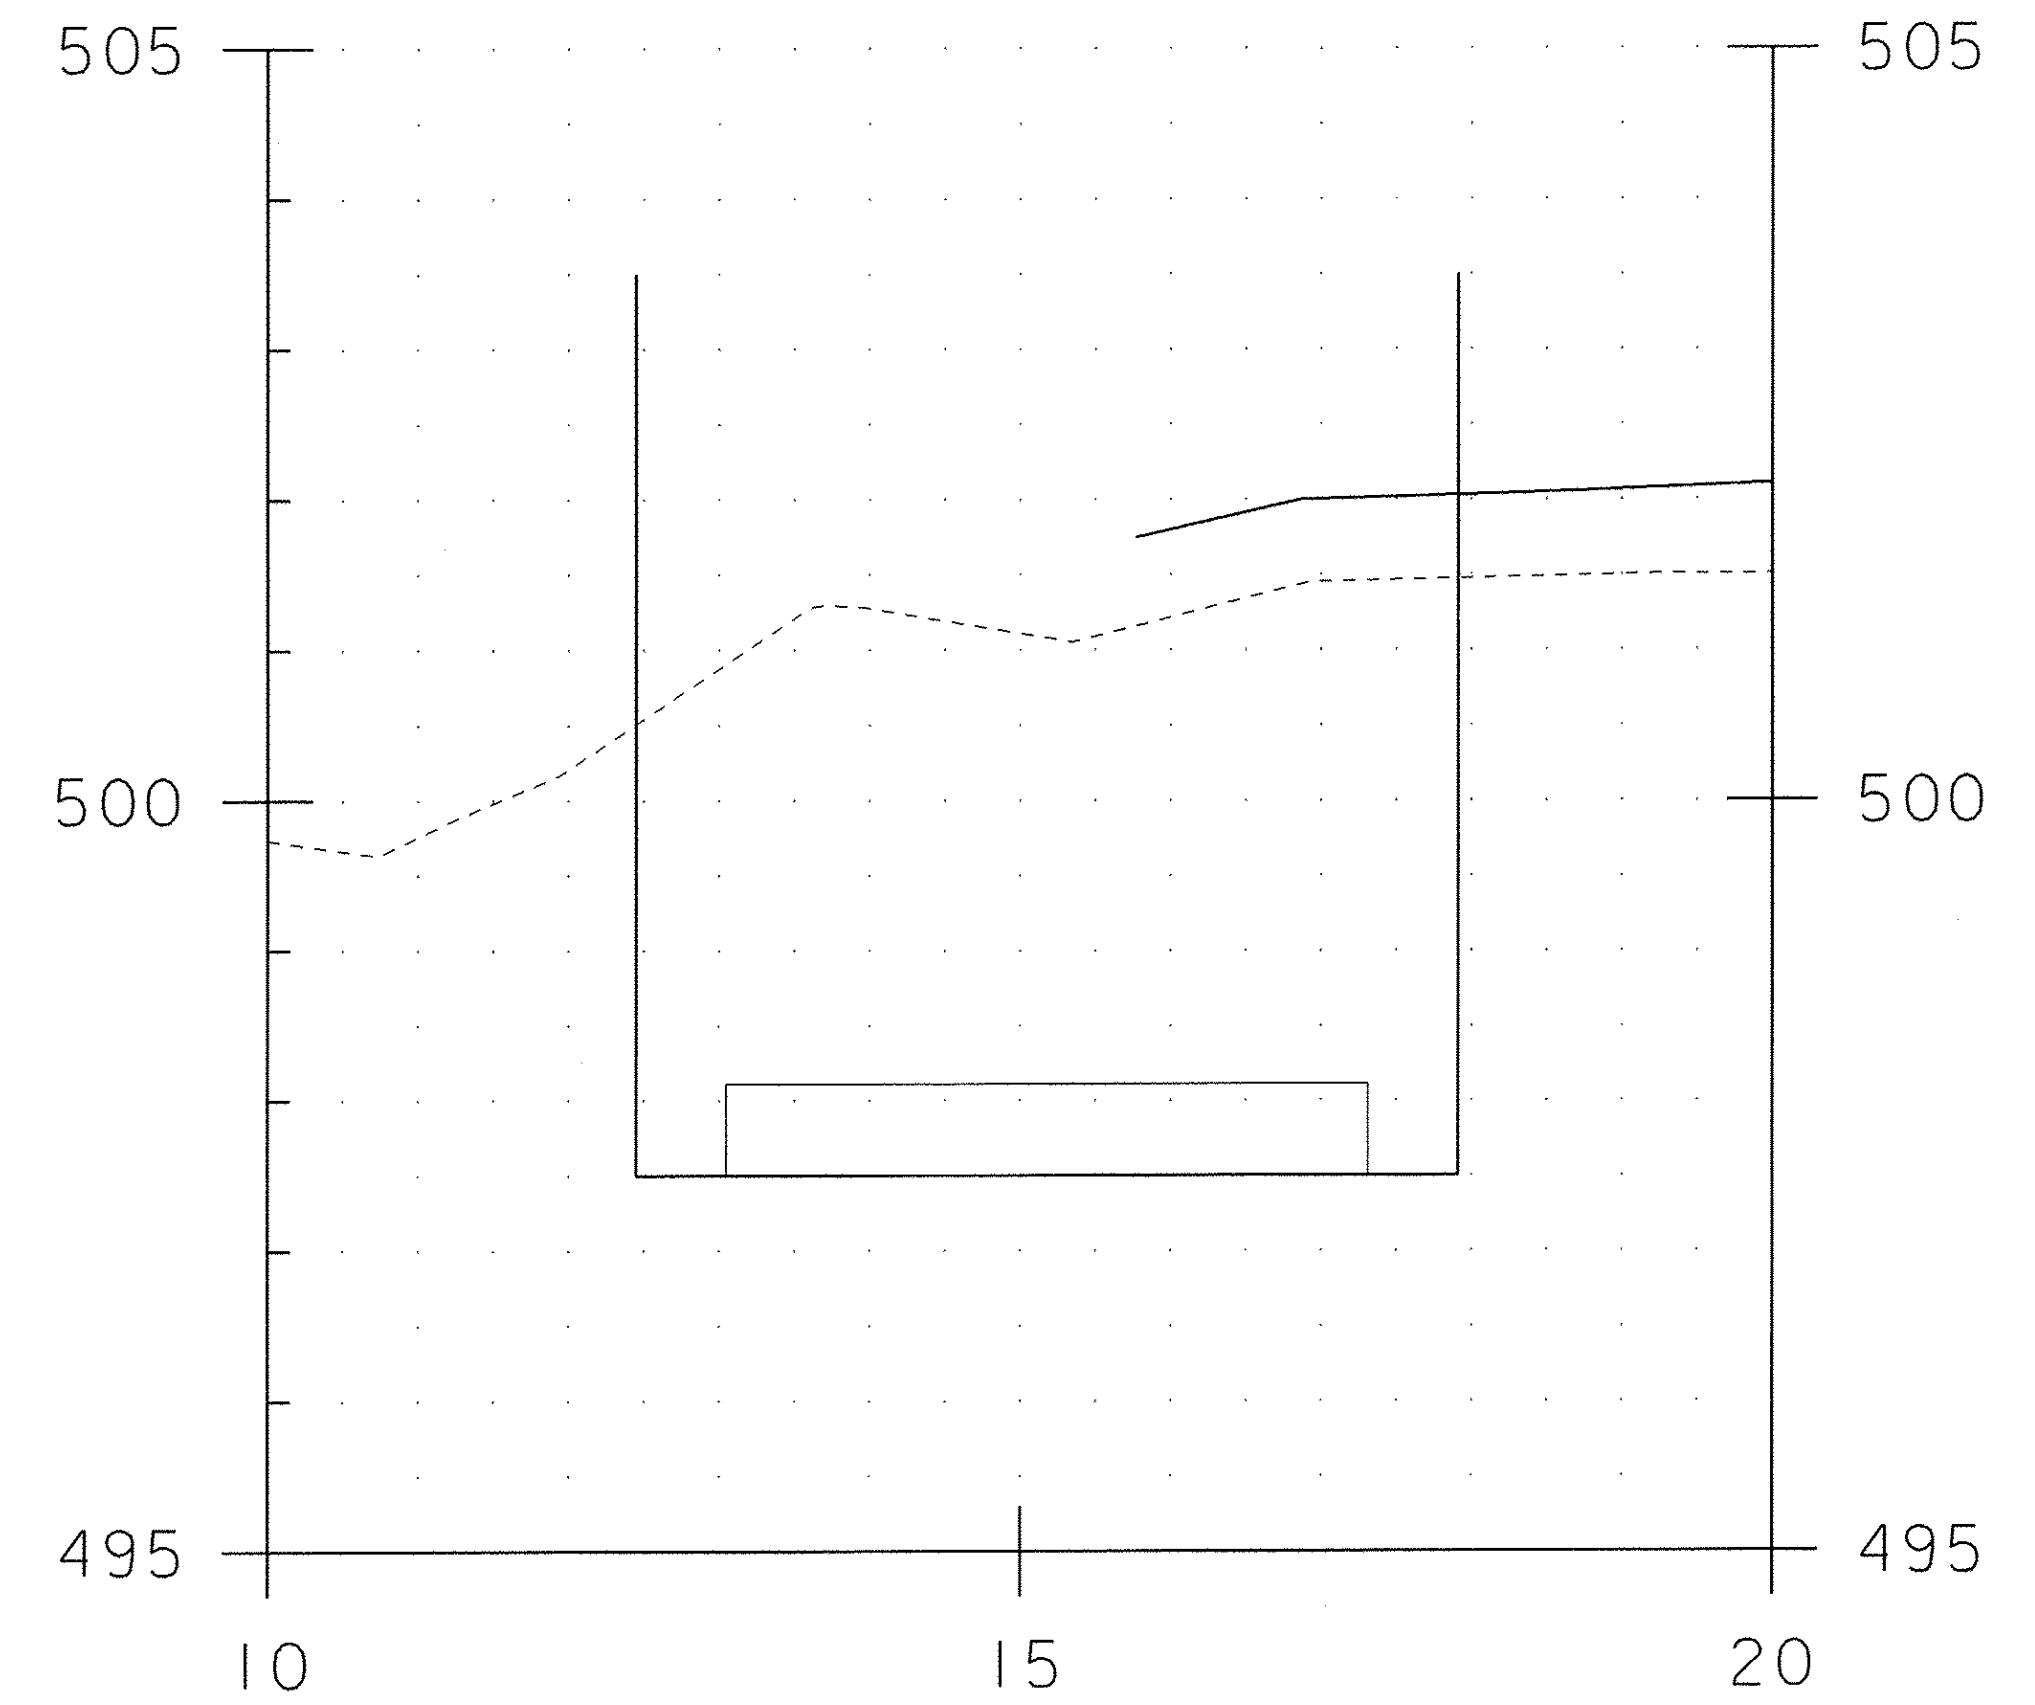

9+007.89 COFFER EX - 20.1756 m<sup>2</sup>

PC 6-2-11

BRIDGE 20 ABUTMENT 2  
COFFERDAM SECTIONS 1

PROJECT NAME:	CHITTENDEN	FILE NAME:	96j236/str/sj236_Coffxs.dgn	PLOT DATE:	26-MAY-2010
PROJECT NUMBER:	STP 1443(45)	PROJECT LEADER:	C. CARLSON	DRAWN BY:	C. MOONEY
		DESIGNED BY:	C. CARLSON	CHECKED BY:	C. CARLSON
		BR 20 ABUT 2 COFFERDAM XS 1		SHEET	15 OF 18

STA. 9+005 TO STA. 9+008