


9+008.10 COFFER EX - 21,080.7 M²
DC 6-2-11

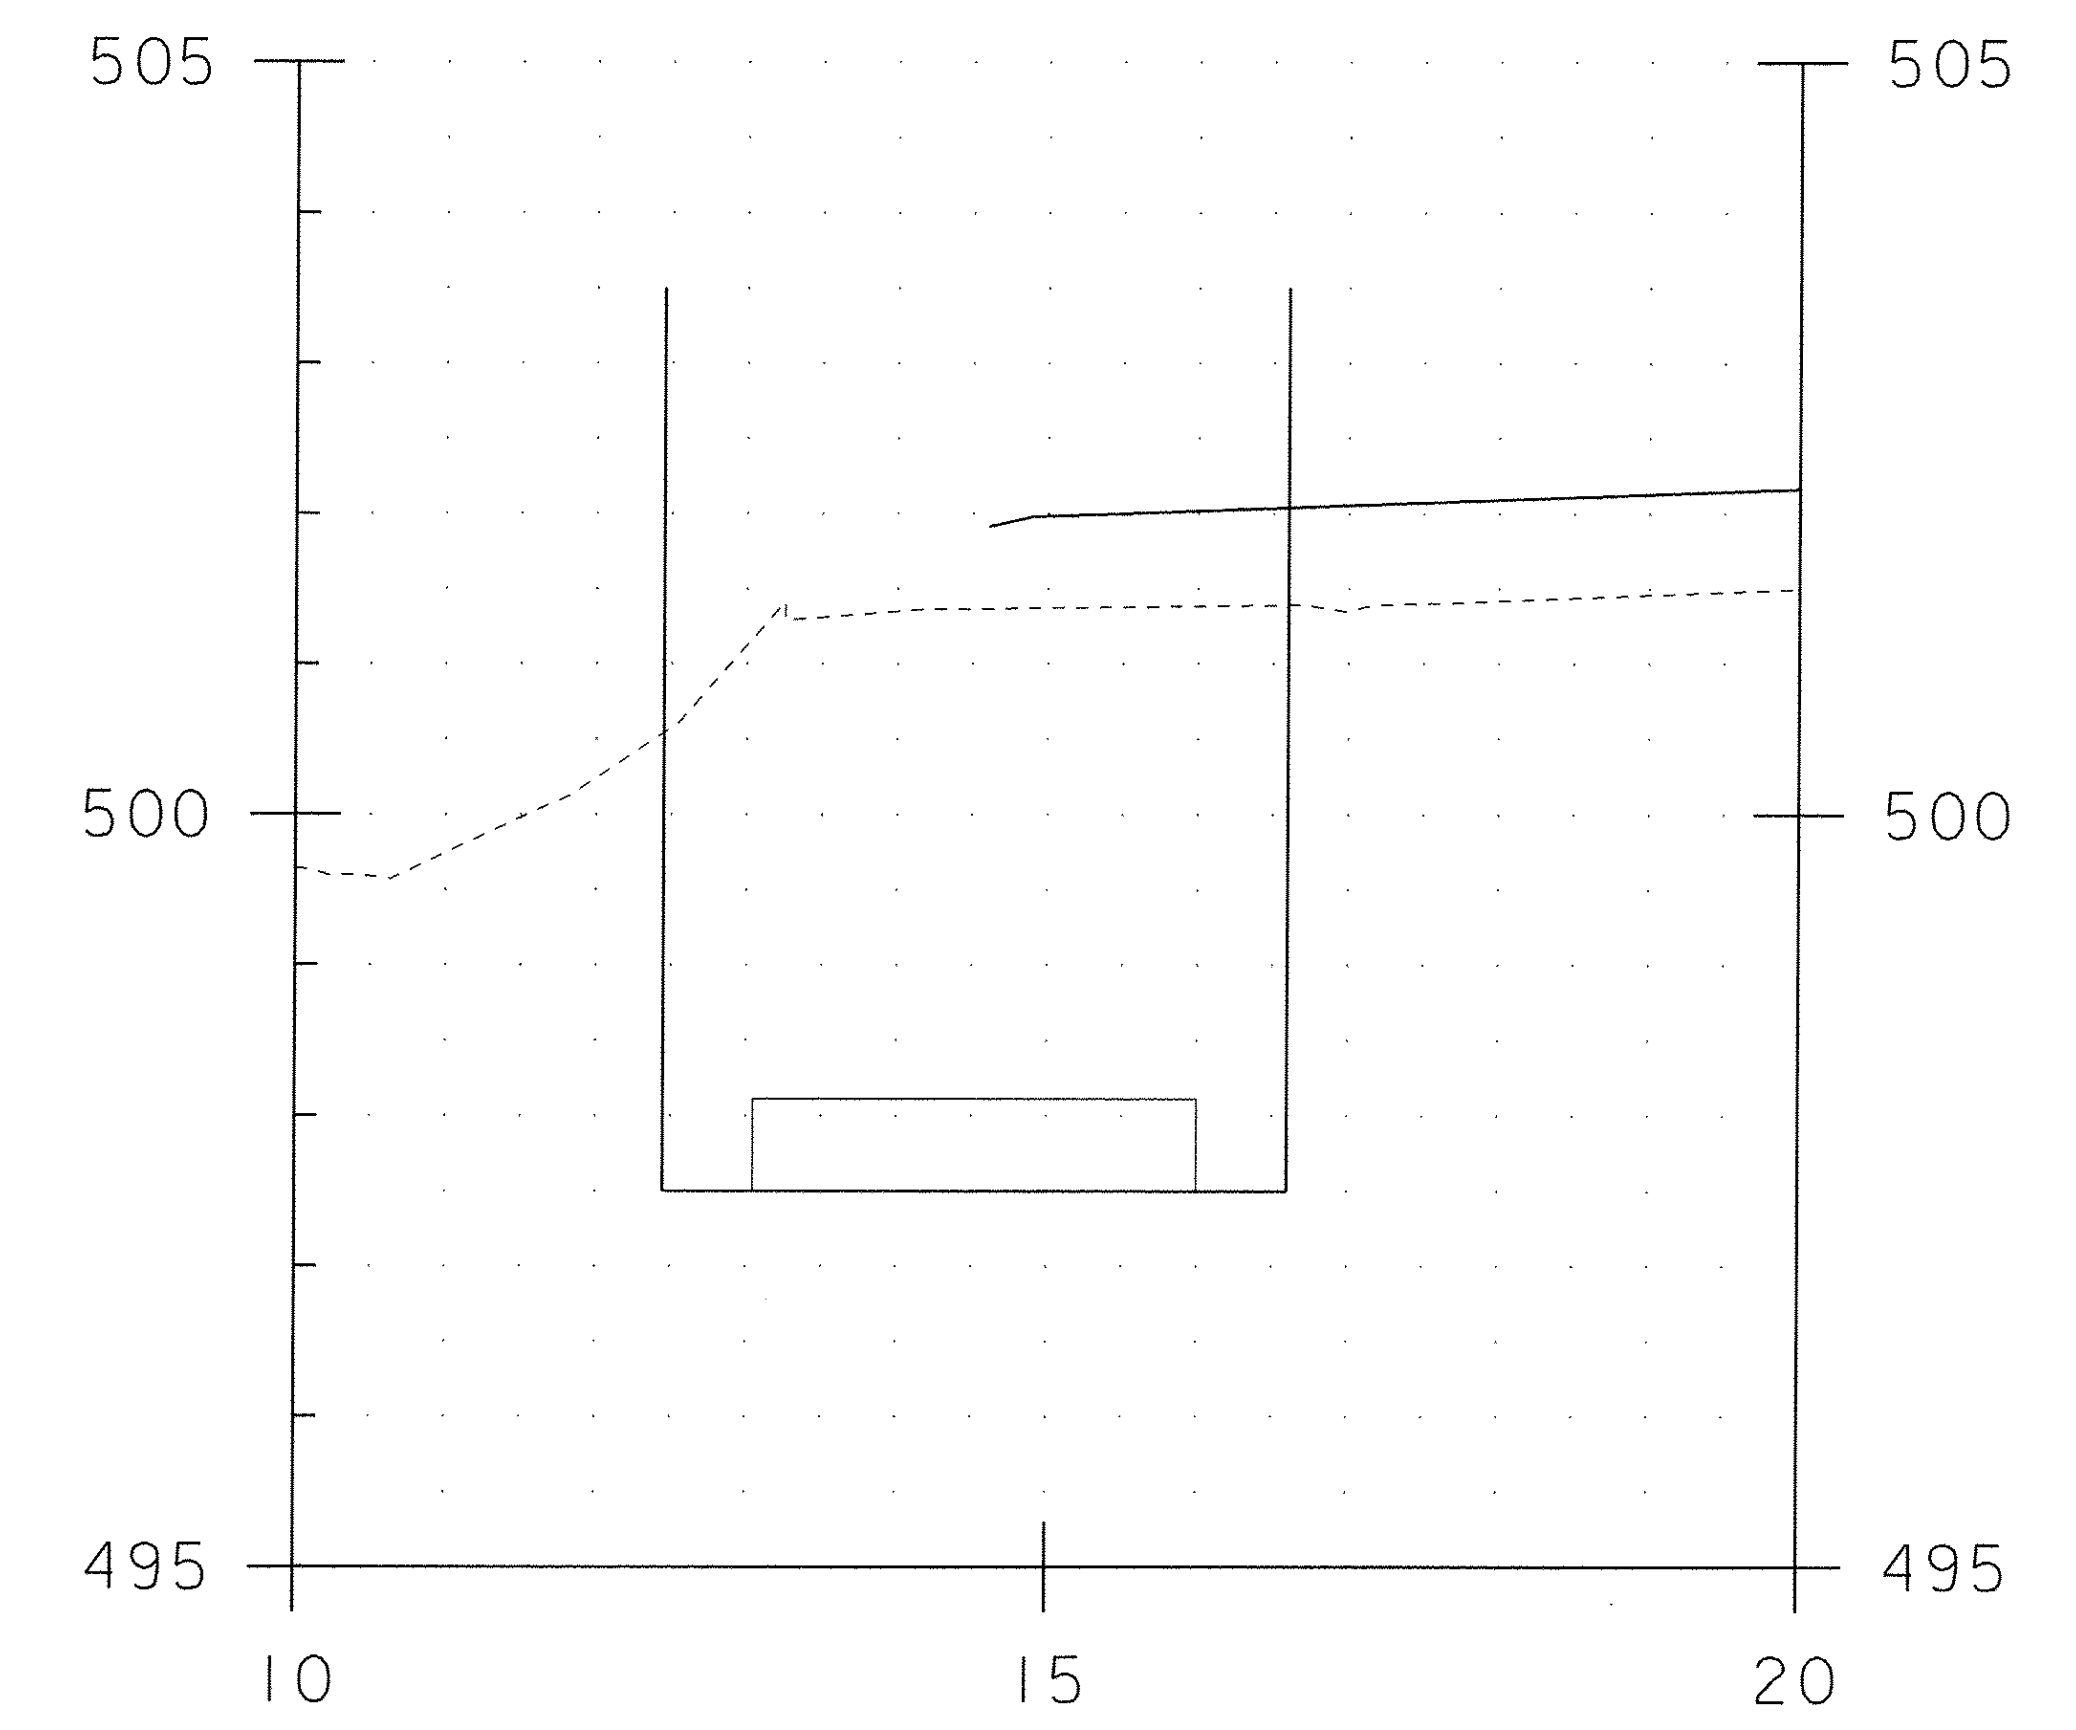

9+009.6 COFFER EX - 15,700.7 M²
6-2-11

BRIDGE 20 ABUTMENT 2
COFFERDAM SECTIONS 2

PROJECT NAME: CHITTENDEN	PLOT DATE: 26-MAY-2010
PROJECT NUMBER: STP 1443(45)	DRAWN BY: C. MOONEY
FILE NAME: 96j236/str/sj236_CoffXs.dgn	DESIGNED BY: C. CARLSON
PROJECT LEADER: C. CARLSON	CHECKED BY: C. CARLSON
BR 20 ABUT 2 COFFERDAM XS 2	SHEET 16 OF 18

STA. 9+008 TO STA. 9+010