


9+016.70 COFFER EX - 15.3648 m²
DC 6-2-11

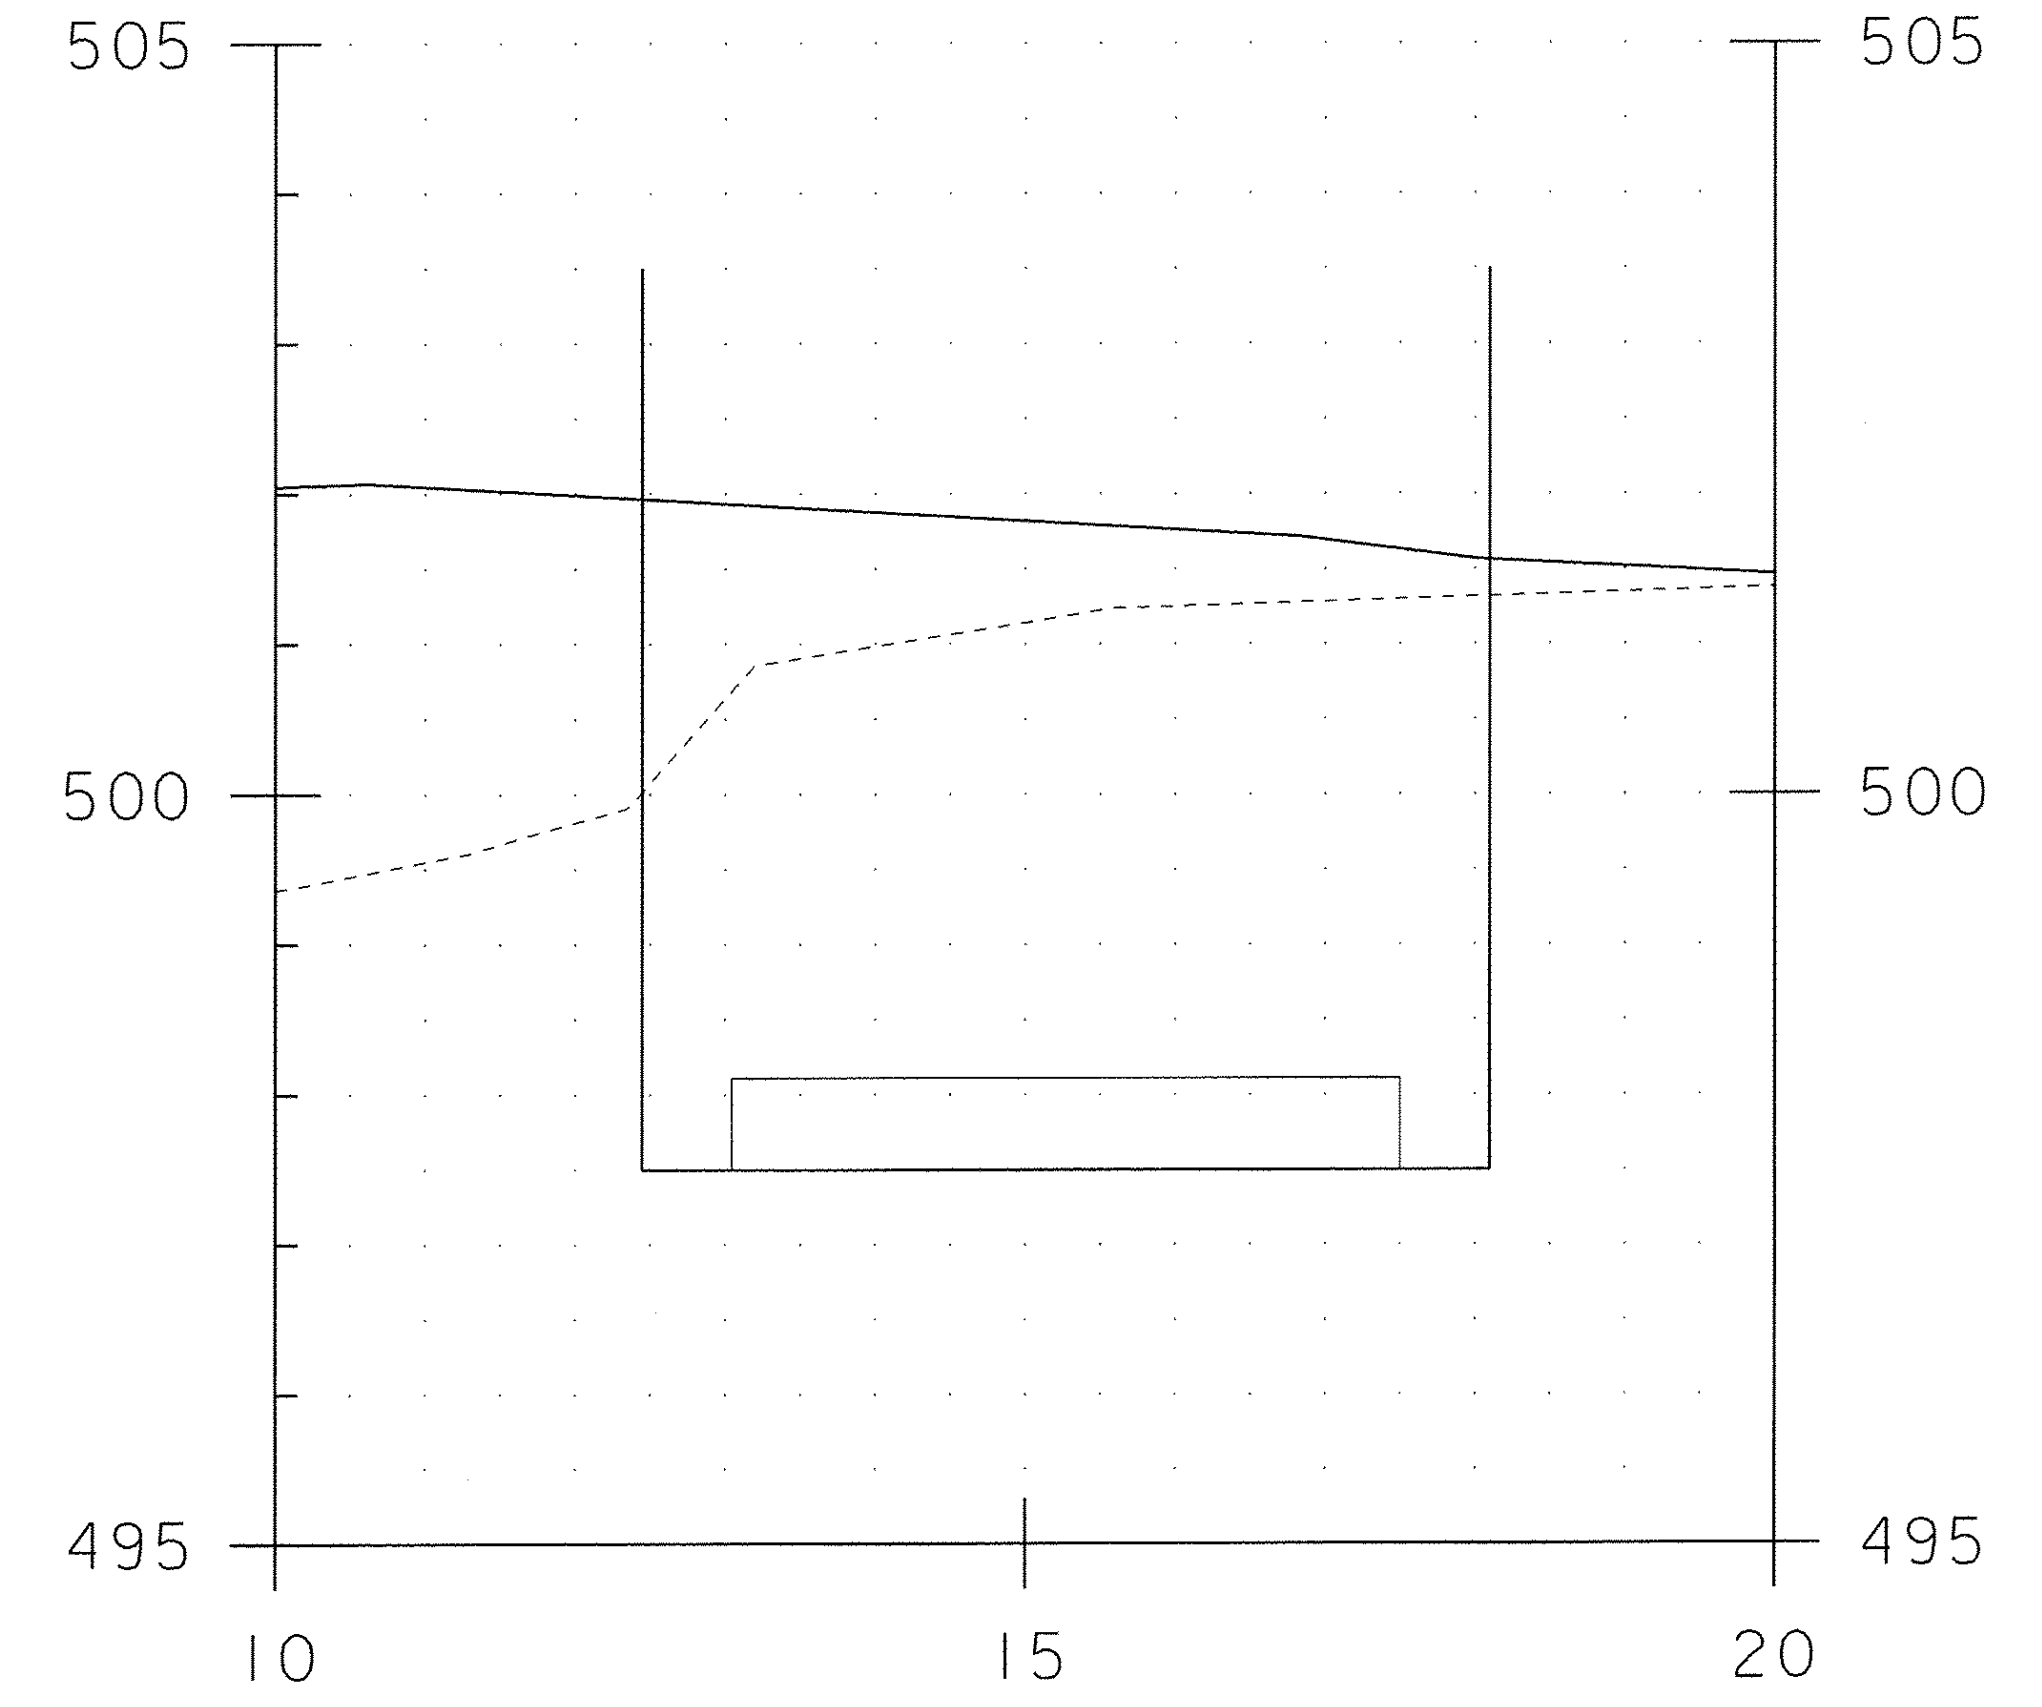

9+018.20 COFFER EX - 20.1847 m²
6-2-11

BRIDGE 20 ABUTMENT 2
 COFFERDAM SECTIONS 3

PROJECT NAME:	CHITTENDEN	PLOT DATE:	26-MAY-2010
PROJECT NUMBER:	STP 1443(45)	DRAWN BY:	C. MOONEY
FILE NAME:	96J236/str/sj236_CoffXs.dgn	CHECKED BY:	C. CARLSON
PROJECT LEADER:	C. CARLSON	SHEET	17 OF 18
DESIGNED BY:	C. CARLSON		
BR 20 ABUT 2 COFFERDAM XS 3			

STA. 9+017 TO STA. 9+018