

**TYPICAL CHANNEL SECTION\*\***  
 (NOT TO SCALE)

\* GRUBBING MATERIAL SHALL NOT BE PLACED ON THE STONE FILL IN THE AREA UNDER THE BRIDGE. WHENEVER CHANNEL SLOPE INTERSECTS ROADWAY SUBBASE, GRUBBING MATERIAL SHALL BEGIN AT THE BOTTOM OF SUBBASE.  
 \*\* THIS DETAIL TO BE USED AT THE WINGWALLS SEE SHEET II FOR INSTALLATION AT FRONT FACE OF ABUTMENT

**OFFSETS FOR GUARDRAIL**

BEGIN FLARE		CONCRETE ANCHOR	
STATION	OFFSET	STATION	OFFSET
STA. 9+50	8.60' LEFT	STA. 9+31	10.57' LEFT
STA. 9+50	10.10' RIGHT	STA. 9+31	12.90' RIGHT
STA. 10+36.5	10.83' LEFT	STA. 10+52	17.31' LEFT
STA. 10+28.5	8.25' RIGHT		
STA. 10+39	11.89' RIGHT	STA. 10+60	15.18' RIGHT

3 EMULSIFIED ASPHALT TO BE APPLIED BETWEEN PAVEMENT LIFTS

**SEEDING FORMULA RURAL AREAS**

% WT.	LBS./A.	NAME	PUR %	GERM %
37.5	22.5	CREEPING RED FESCUE	98	85
37.5	22.5	TALL FESCUE	95	90
5.0	3.0	RED TOP	95	90
15.0	9.0	BIRDSFOOT TREFLOIL	98	85
5.0	3.0	ANNUAL RYEGRASS	95	85
100.0	60.0			

**GENERAL NOTES**

SEED MIXTURE: SHALL NOT HAVE A WEED CONTENT EXCEEDING 0.40% BY WEIGHT AND SHALL BE FREE OF ALL NOXIOUS SEED.  
 SEED: TO BE APPLIED PER SEEDING FORMULAS OR AS DIRECTED BY THE ENGINEER.  
 FERTILIZER: FORMULA 10-20-10, TO BE USED WITH SEED, APPLIED AT THE RATE OF 500 LBS./ACRE. (HYDRO SEEDERS MAY USE 19-19-19 FORMULA).  
 AGRICULTURAL LIMESTONE: TO BE APPLIED AT THE RATE OF 2 TONS/ACRE, OR AS DIRECTED BY THE ENGINEER.  
 HAY MULCH: TO BE PLACED ON EARTH SLOPES AT THE RATE OF 2 TONS/ACRE, OR AS DIRECTED BY THE ENGINEER.  
 TOPSOIL: TO BE USED WITH SEED AS INDICATED ON THE PLANS, OR AS DIRECTED BY THE ENGINEER.

**STRUCTURE**

STRUCTURE TYPE: COVERED BRIDGE, TOWN LATTICE TRUSS  
 CLEAR SPAN (NORMAL TO STREAM): 30' +/- ABUT TO ABUT  
 VERTICAL CLEARANCE ABOVE STREAMBED: 15 FEET +/-  
 WATER SURFACE ELEV. Q100= 368.0 (FROM FLOOD INSURANCE STUDY)  
 IS THE ROADWAY OVERTOPPED BELOW THE Q100? YES  
 AVERAGE LOW ELEVATION OF SUPERSTRUCTURE: 364.0  
 SCOUR: NOT AVAILABLE  
 REQUIRED CHANNEL PROTECTION: STONE FILL, TYPE II  
 NO ADDITIONAL HYDRAULIC STUDIES WERE DONE  
 THE WATERWAY OPENING AND VERTICAL CLEARANCE REMAIN UNCHANGED



**DESIGN CRITERIA:**

- DESIGN LIVE LOAD AASHTO H20
- DESIGN SPAN 50' +/-
- ALLOWABLE LOAD FOR SPREAD FOOTINGS ON SOIL NA ON LEDGE NA
- ALLOWABLE LOAD FOR PILING NA TYPE NA ESTIMATED LENGTH NA
- STRUCTURAL STEEL AASHTO GRADE M270
- REINFORCING STEEL GRADE 60
- CONCRETE CLASS A  $f_c$ : 4000 PSI  
 CONCRETE CLASS B  $f_c$ : 3500 PSI  
 SILICA-FUME CONCRETE  $f_c$ : 5000 PSI

**TRAFFIC MAINTENANCE:**

- IS TRAFFIC TO BE MAINTAINED? NO IF YES, ON EXISTING STRUCTURE NA OR ON TEMPORARY BRIDGE NA
- TEMPORARY BRIDGE REQUIREMENTS: ONE OR TWO WAY NA TRAFFIC CONTROL SIGNALS REQUIRED NA

ARE SIDEWALKS REQUIRED? NO IF SO, ON WHAT SIDE? NA

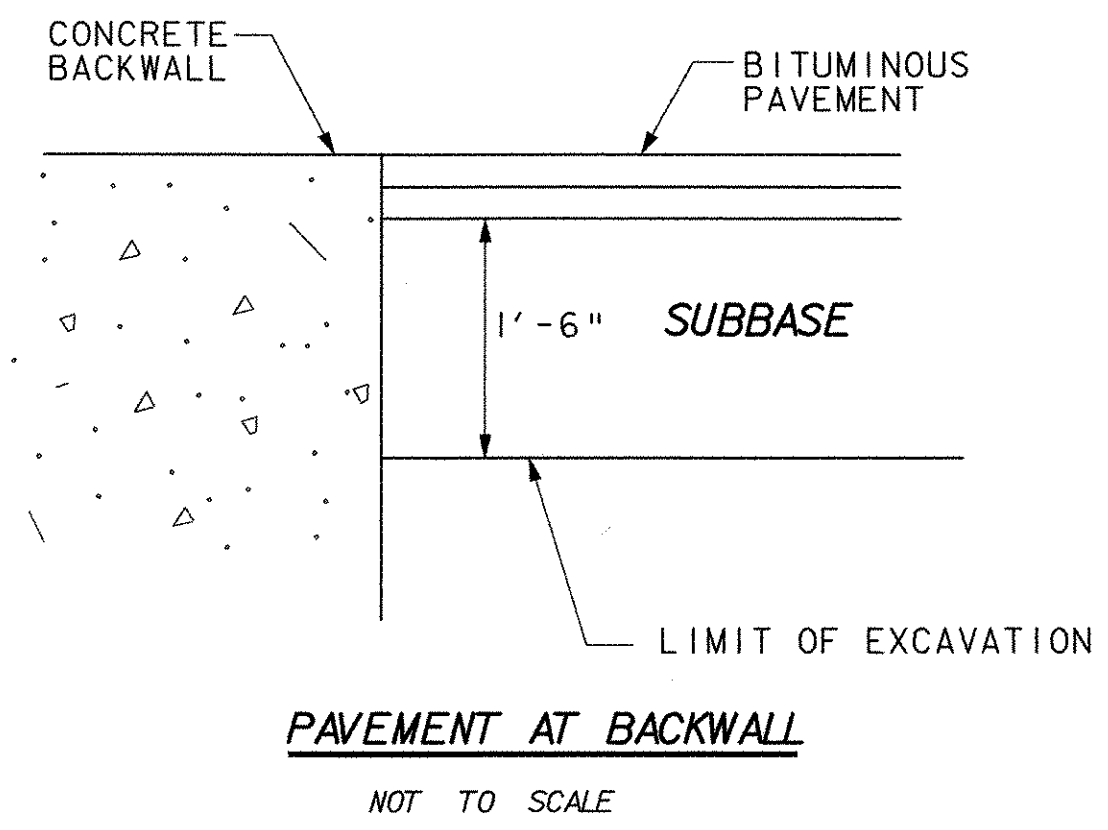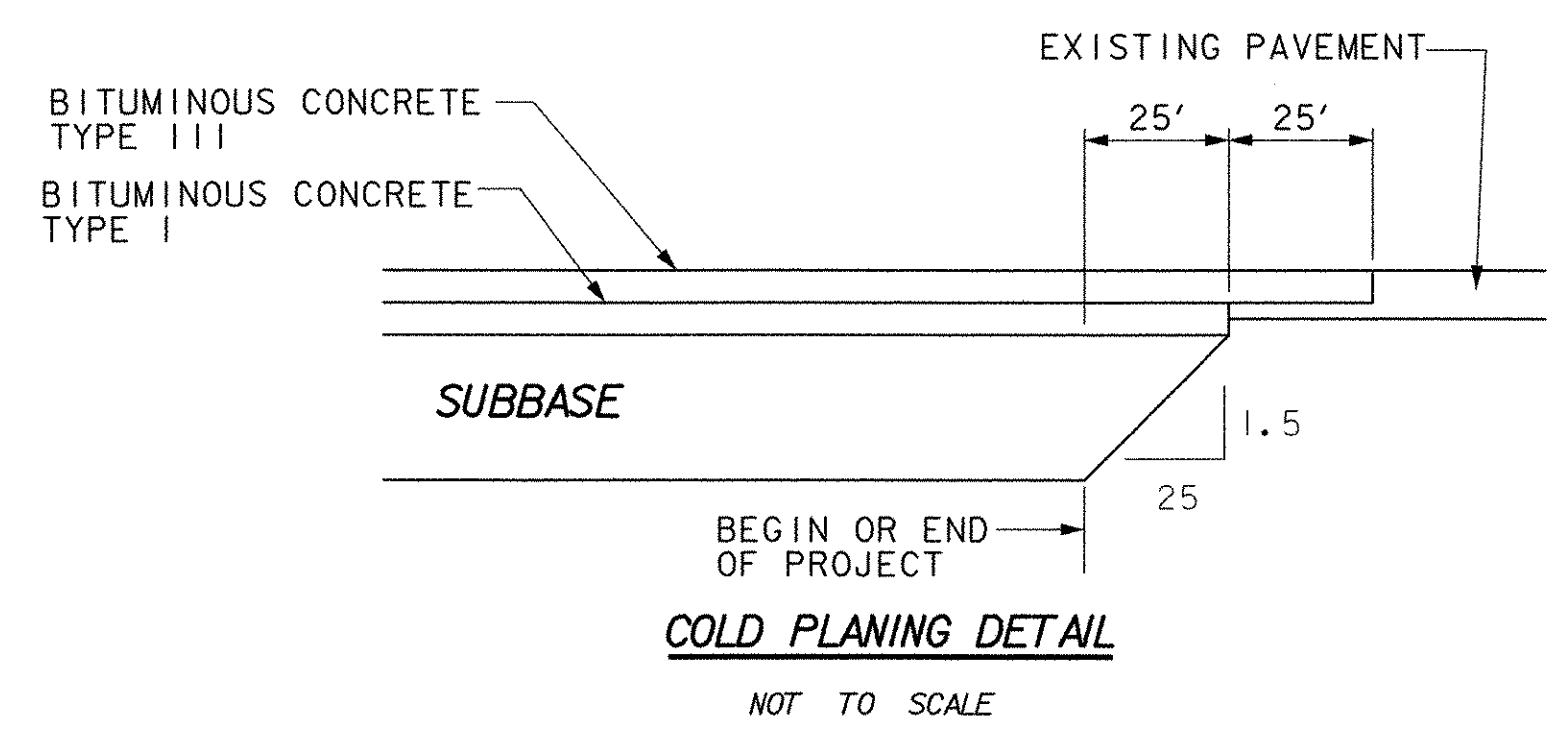

**WORKING STRESS LOAD RATING (TONS)**

STRESS LEVELS	TRUCK					
	H	HS	3S2	6 AXLE	3A. STR.	4A. STR. 5A. SEMI
INVENTORY*	20					
POSTED (I. 17 X INVENTORY ALLOWABLES)	29					
OPERATING (I. 33 X INVENTORY ALLOWABLES)						

\*RATING CONTROLLED BY NEW LATTICE MEMBERS AND NEW SECTION OF BOTTOM CHORD  
 NEW MATERIAL IS SOUTHERN PINE NO. 1 DENSE (NDS)  
 Fb=1350 psi Fv=90 psi Fc1=1700 psi (COMP. PARALLEL TO GRAIN)



**STATE OF VERMONT AGENCY OF TRANSPORTATION**

Town Of PITTSFORD, VT Bridge No. 31  
 Highway No. ELM STREET (TH 13) Log Sta.          Surv. Sta.           
 COOLEY COVERED BRIDGE REHABILITATION  
 PRELIMINARY INFORMATION SHEET  
 Designed By J. MESSIER Drawn By J. MESSIER  
 Checked By E. ALLEN RANDALL Date 01/03/03 Bridge Design Supervisor          Date           
 PROJECT PITTSFORD PROJECT NO. BHO 1443 (36)  
 I.G.C. Info.           
 Bridge Sheet No.          Sheet 2 of 15

03 JAN 2003 10:20:14/cooley\_brdge.coold.dgn/cecp15.dgn