


LAYOUT #2

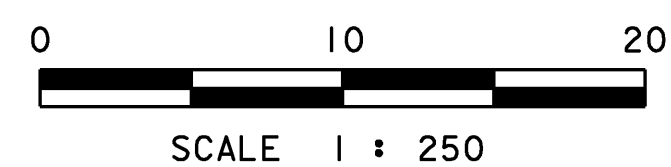

DATUM	
VERTICAL	NAVD 88
HORIZONTAL	NAD 83 (92)

PROJECT: CABOT	PROJECT NO. : BRO 1446 (27)
DESIGN FILE NAME: 96J270/structures/sj270bdr.dgn	PLOT DATE: 07-DEC-2007
IPARM FILE NAME: sj270a2.1	SURVEY DATE: 5/98
SURVEYED BY: R. GILMAN	DRAWN BY: D. G. BASSETT
SQUAD LEADER: C. P. WILLIAMS	SHEET: 8 OF 42
LAYOUT SHEET #2	