



SEE NOTE 2, SHEET 20 OF 42.

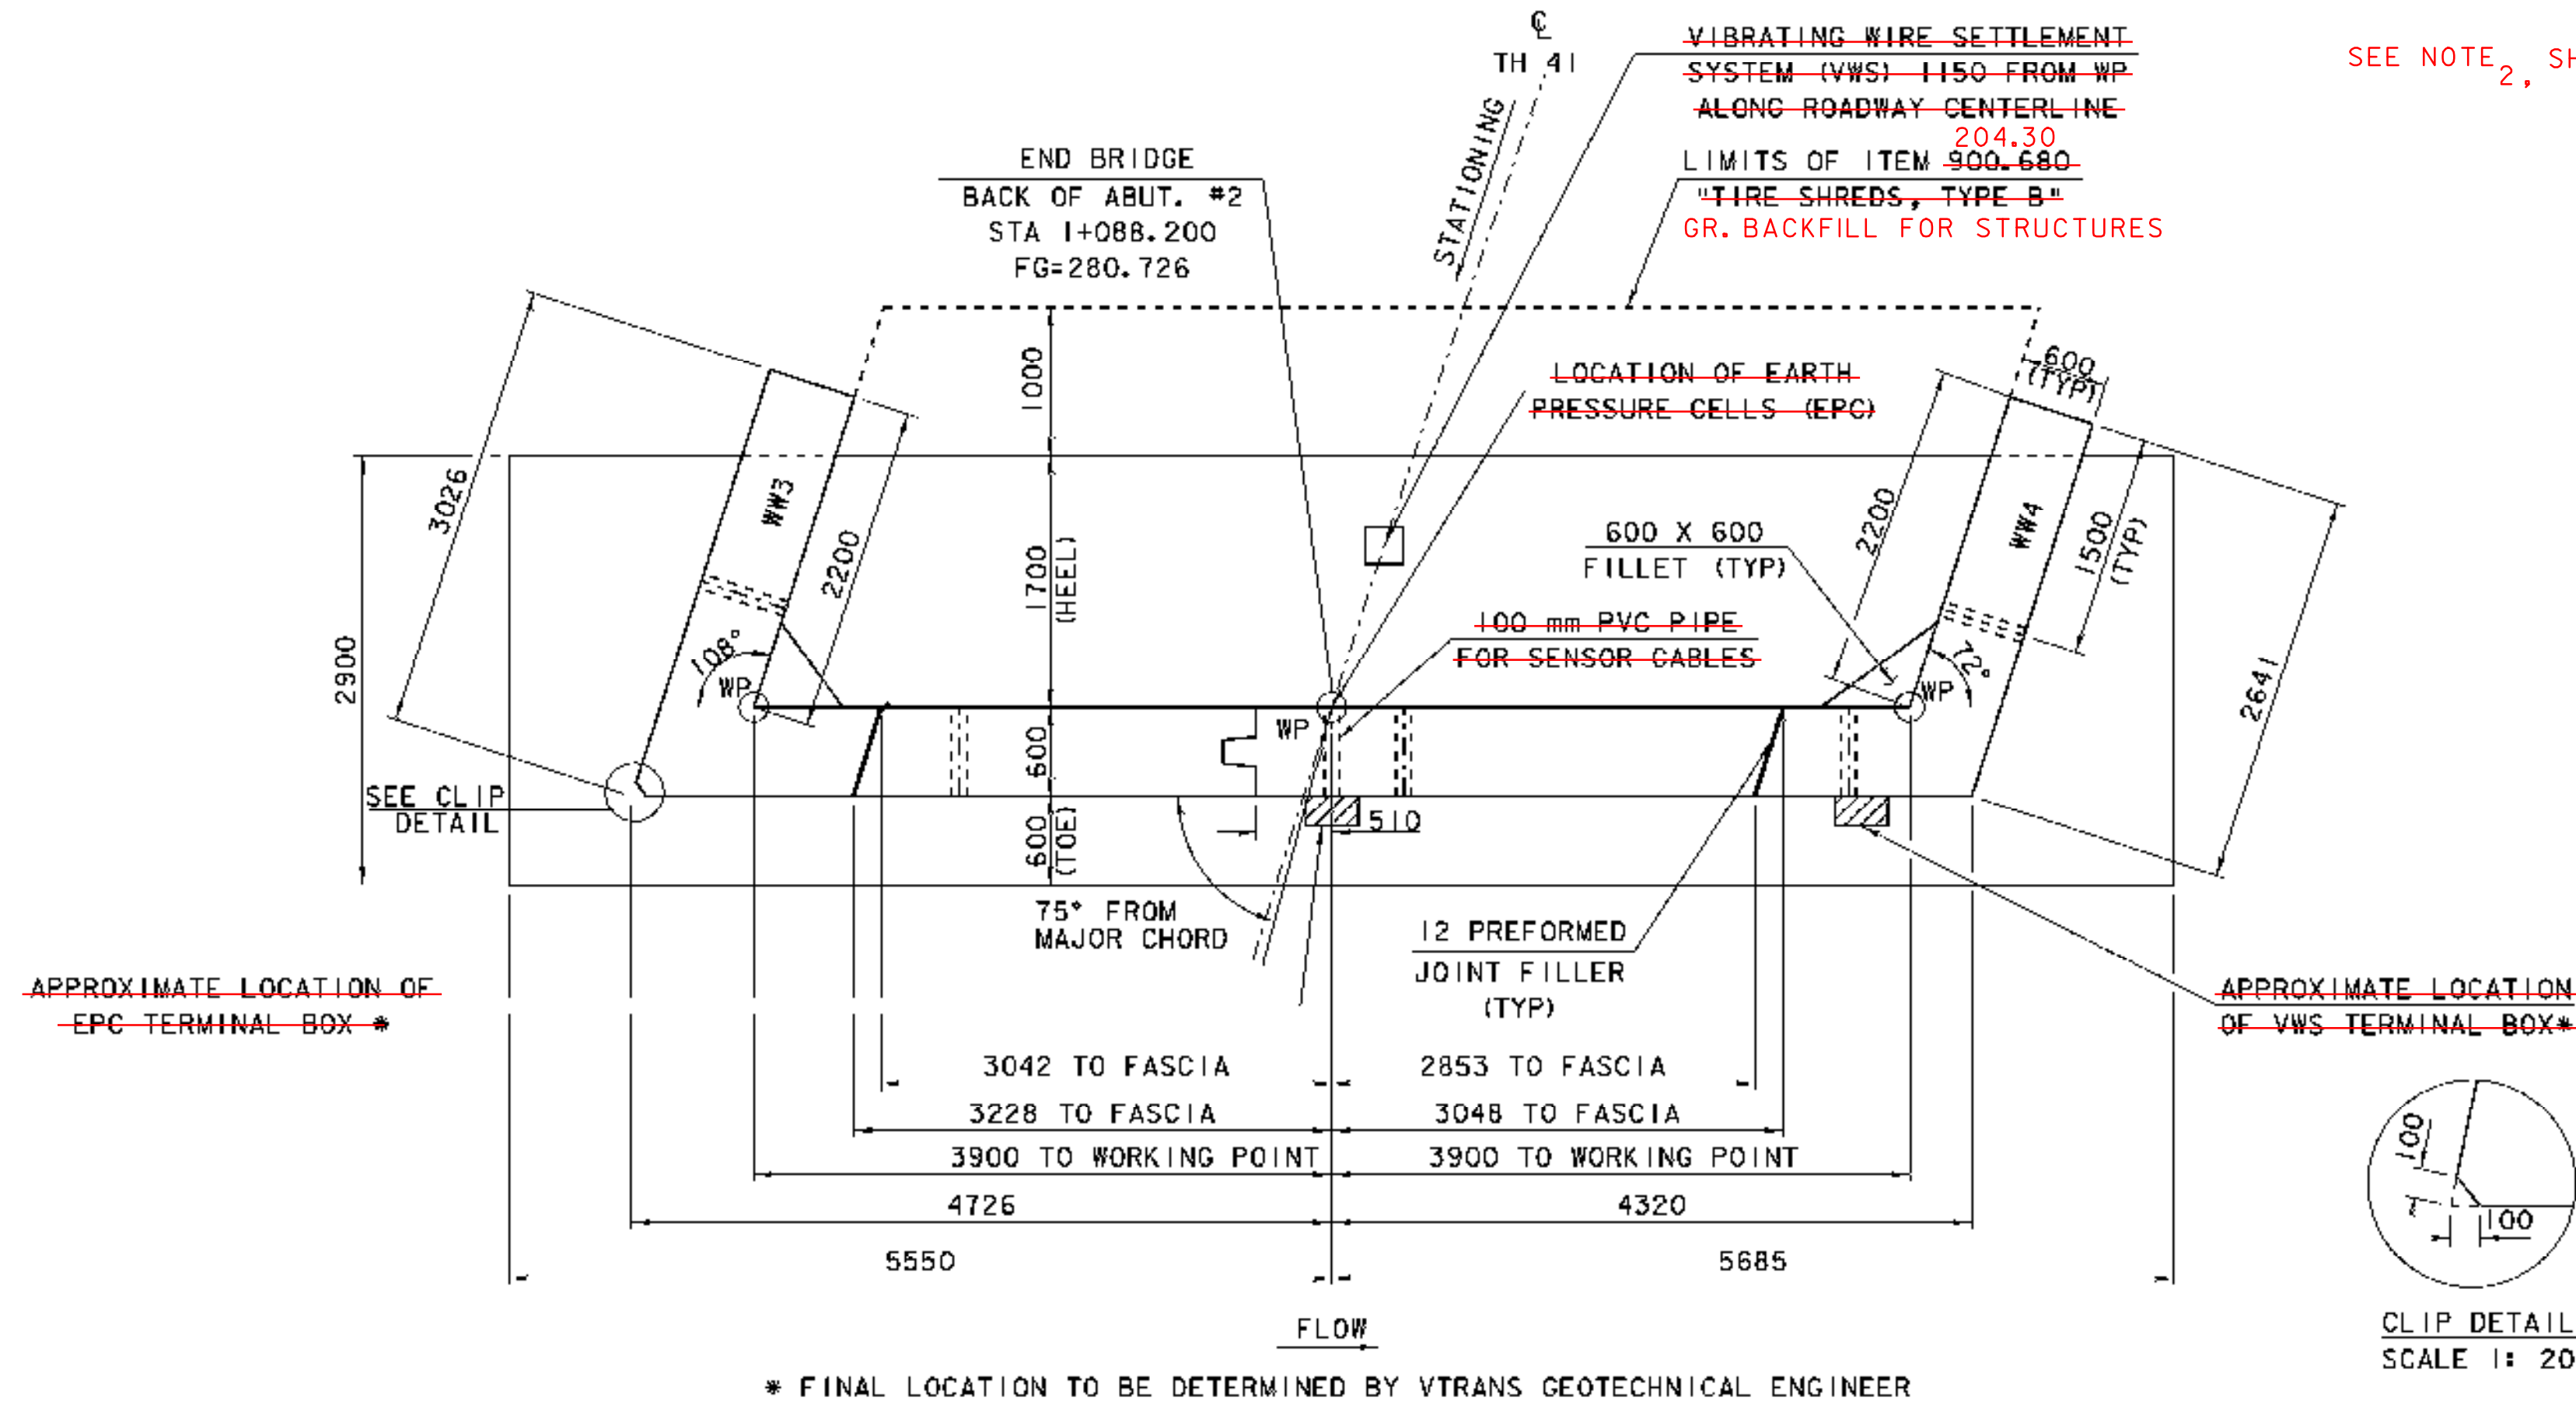

ABUTMENT NO. 2 PLAN

SCALE 1:40

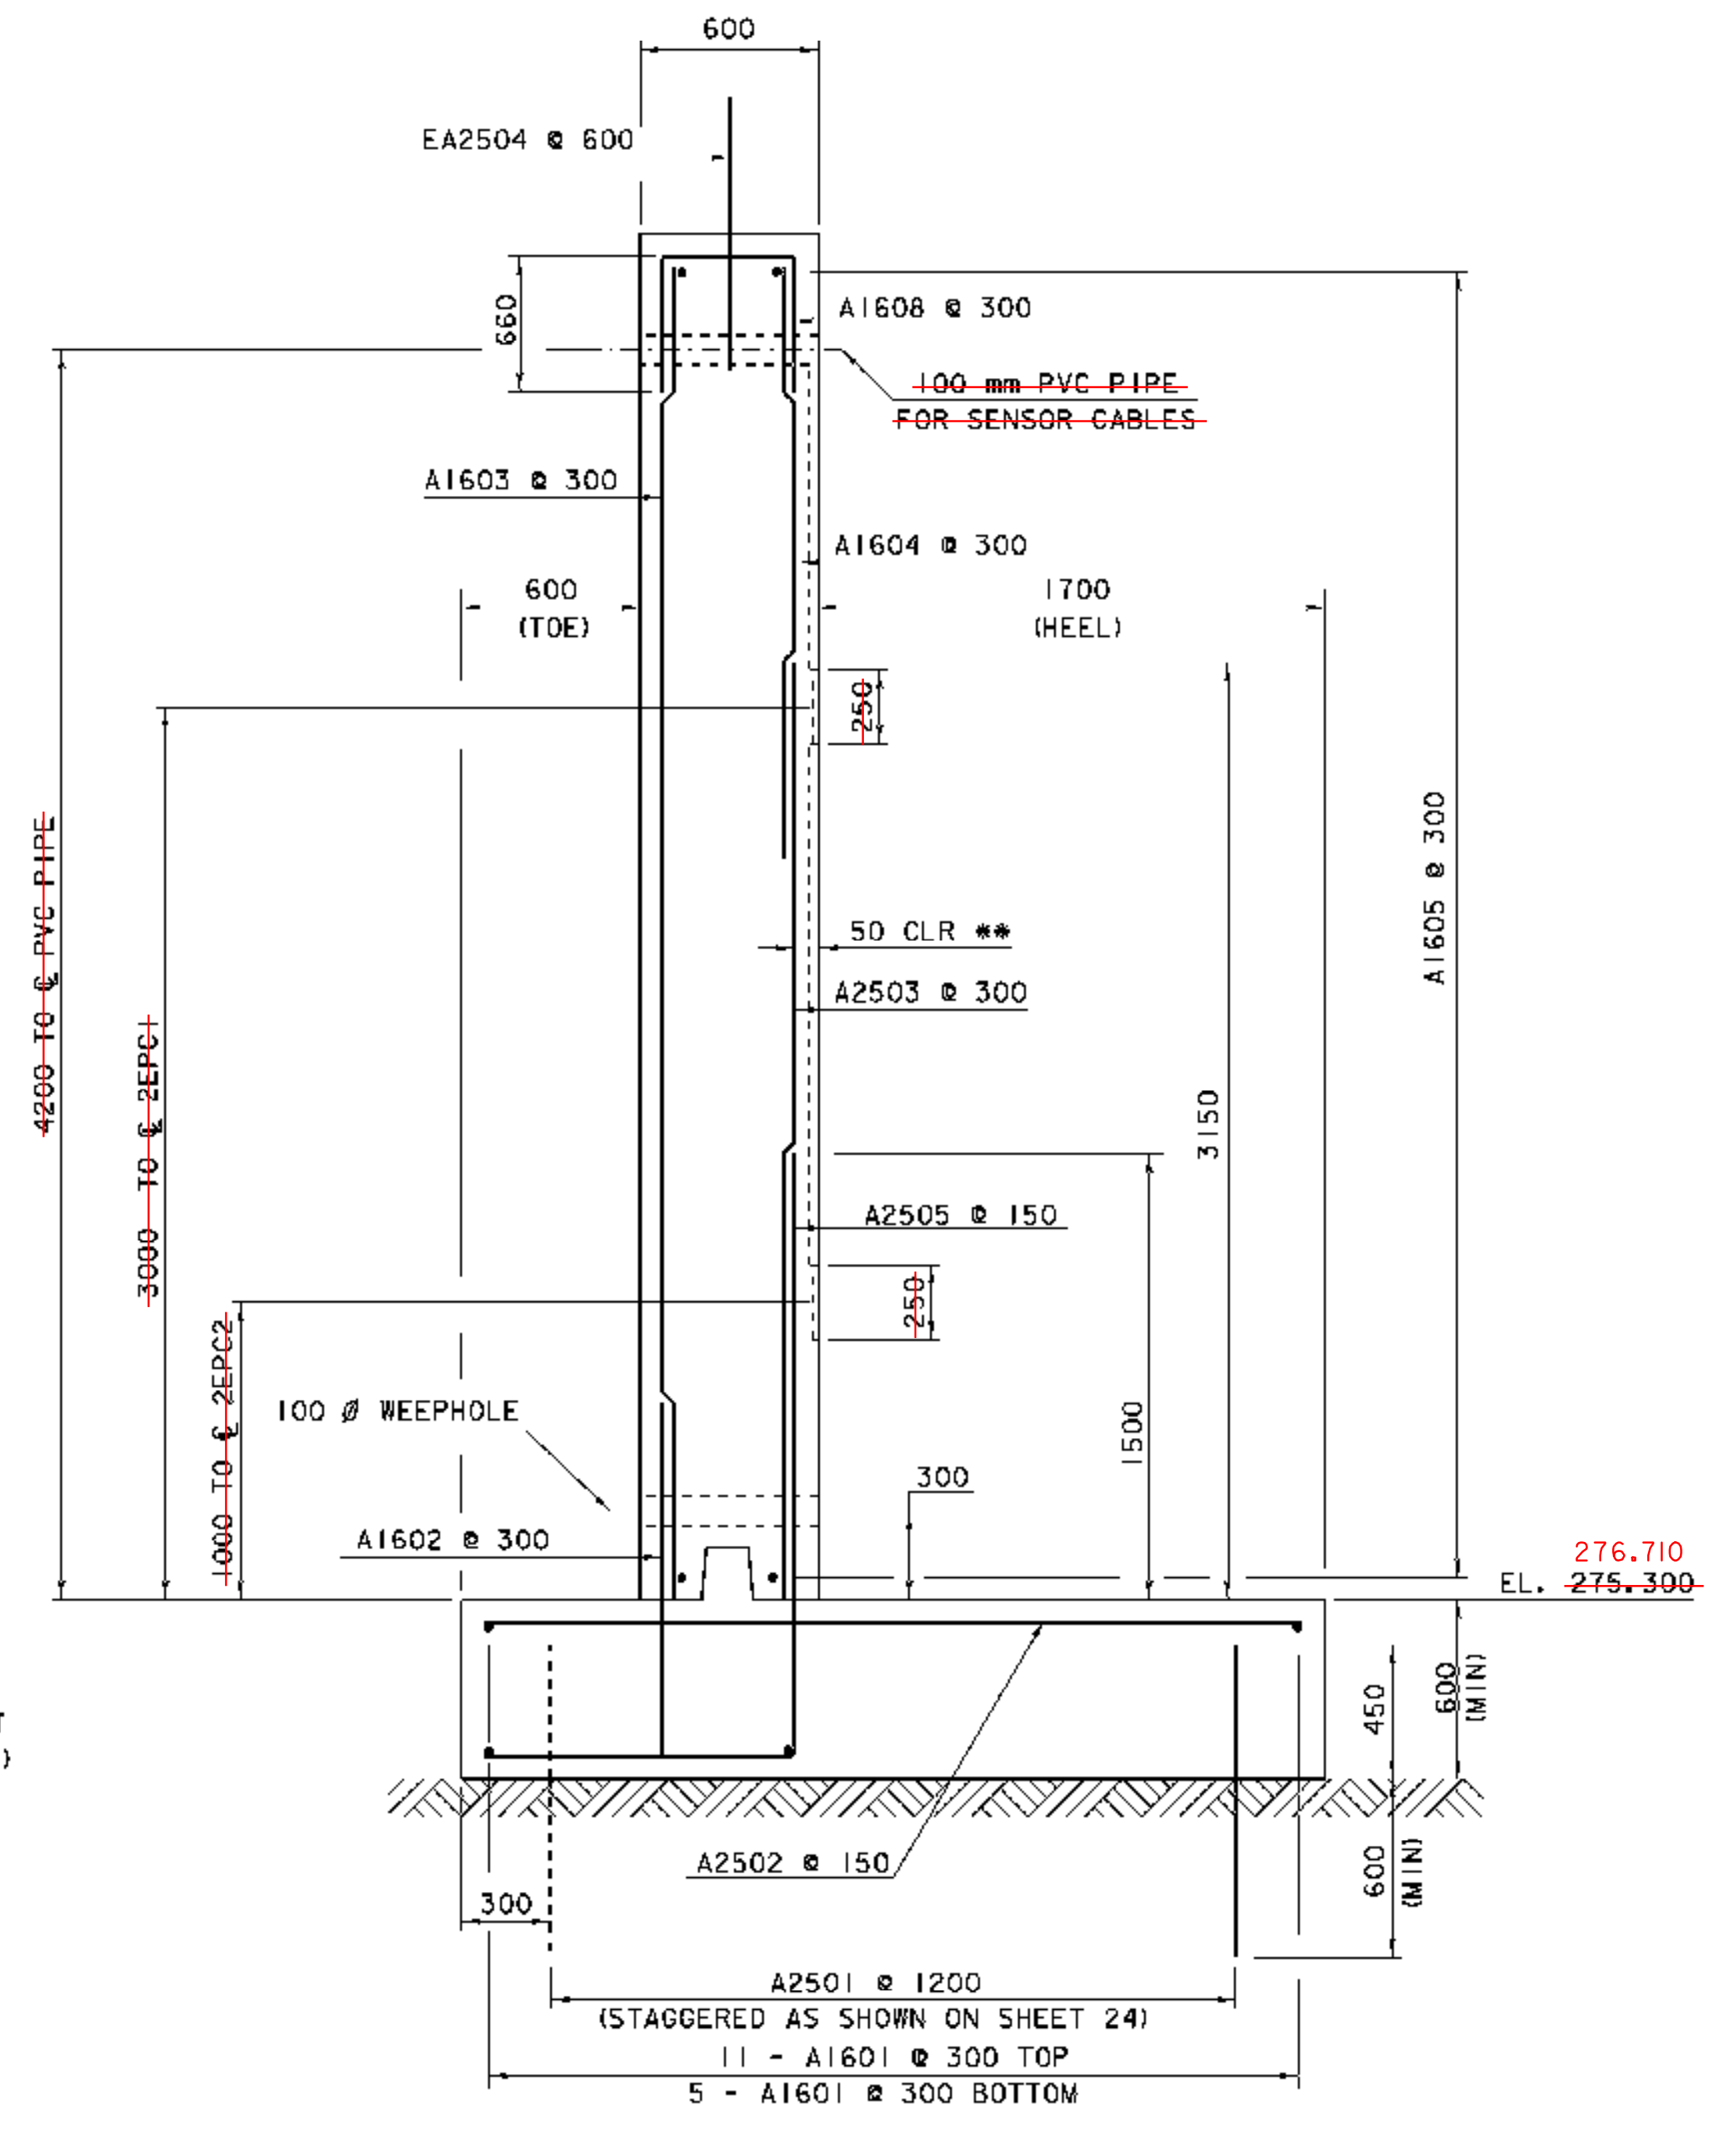


ABUTMENT NO. 2 TYPICAL SECTION

SCALE 1:20

NOTES:



- NF = NEAR FACE
- FF = FAR FACE
- EF = EACH FACE
- ▲ = CUT TO FIT IN FIELD
- 80mm CLEAR UNLESS OTHERWISE SPECIFIED ON THE PLANS.
- ALL LAP SPLICES NOT DETAILED SHALL BE 660mm
- ** MOVE REINFORCING STEEL TO MAINTAIN 50 mm CLEAR AT RECESS

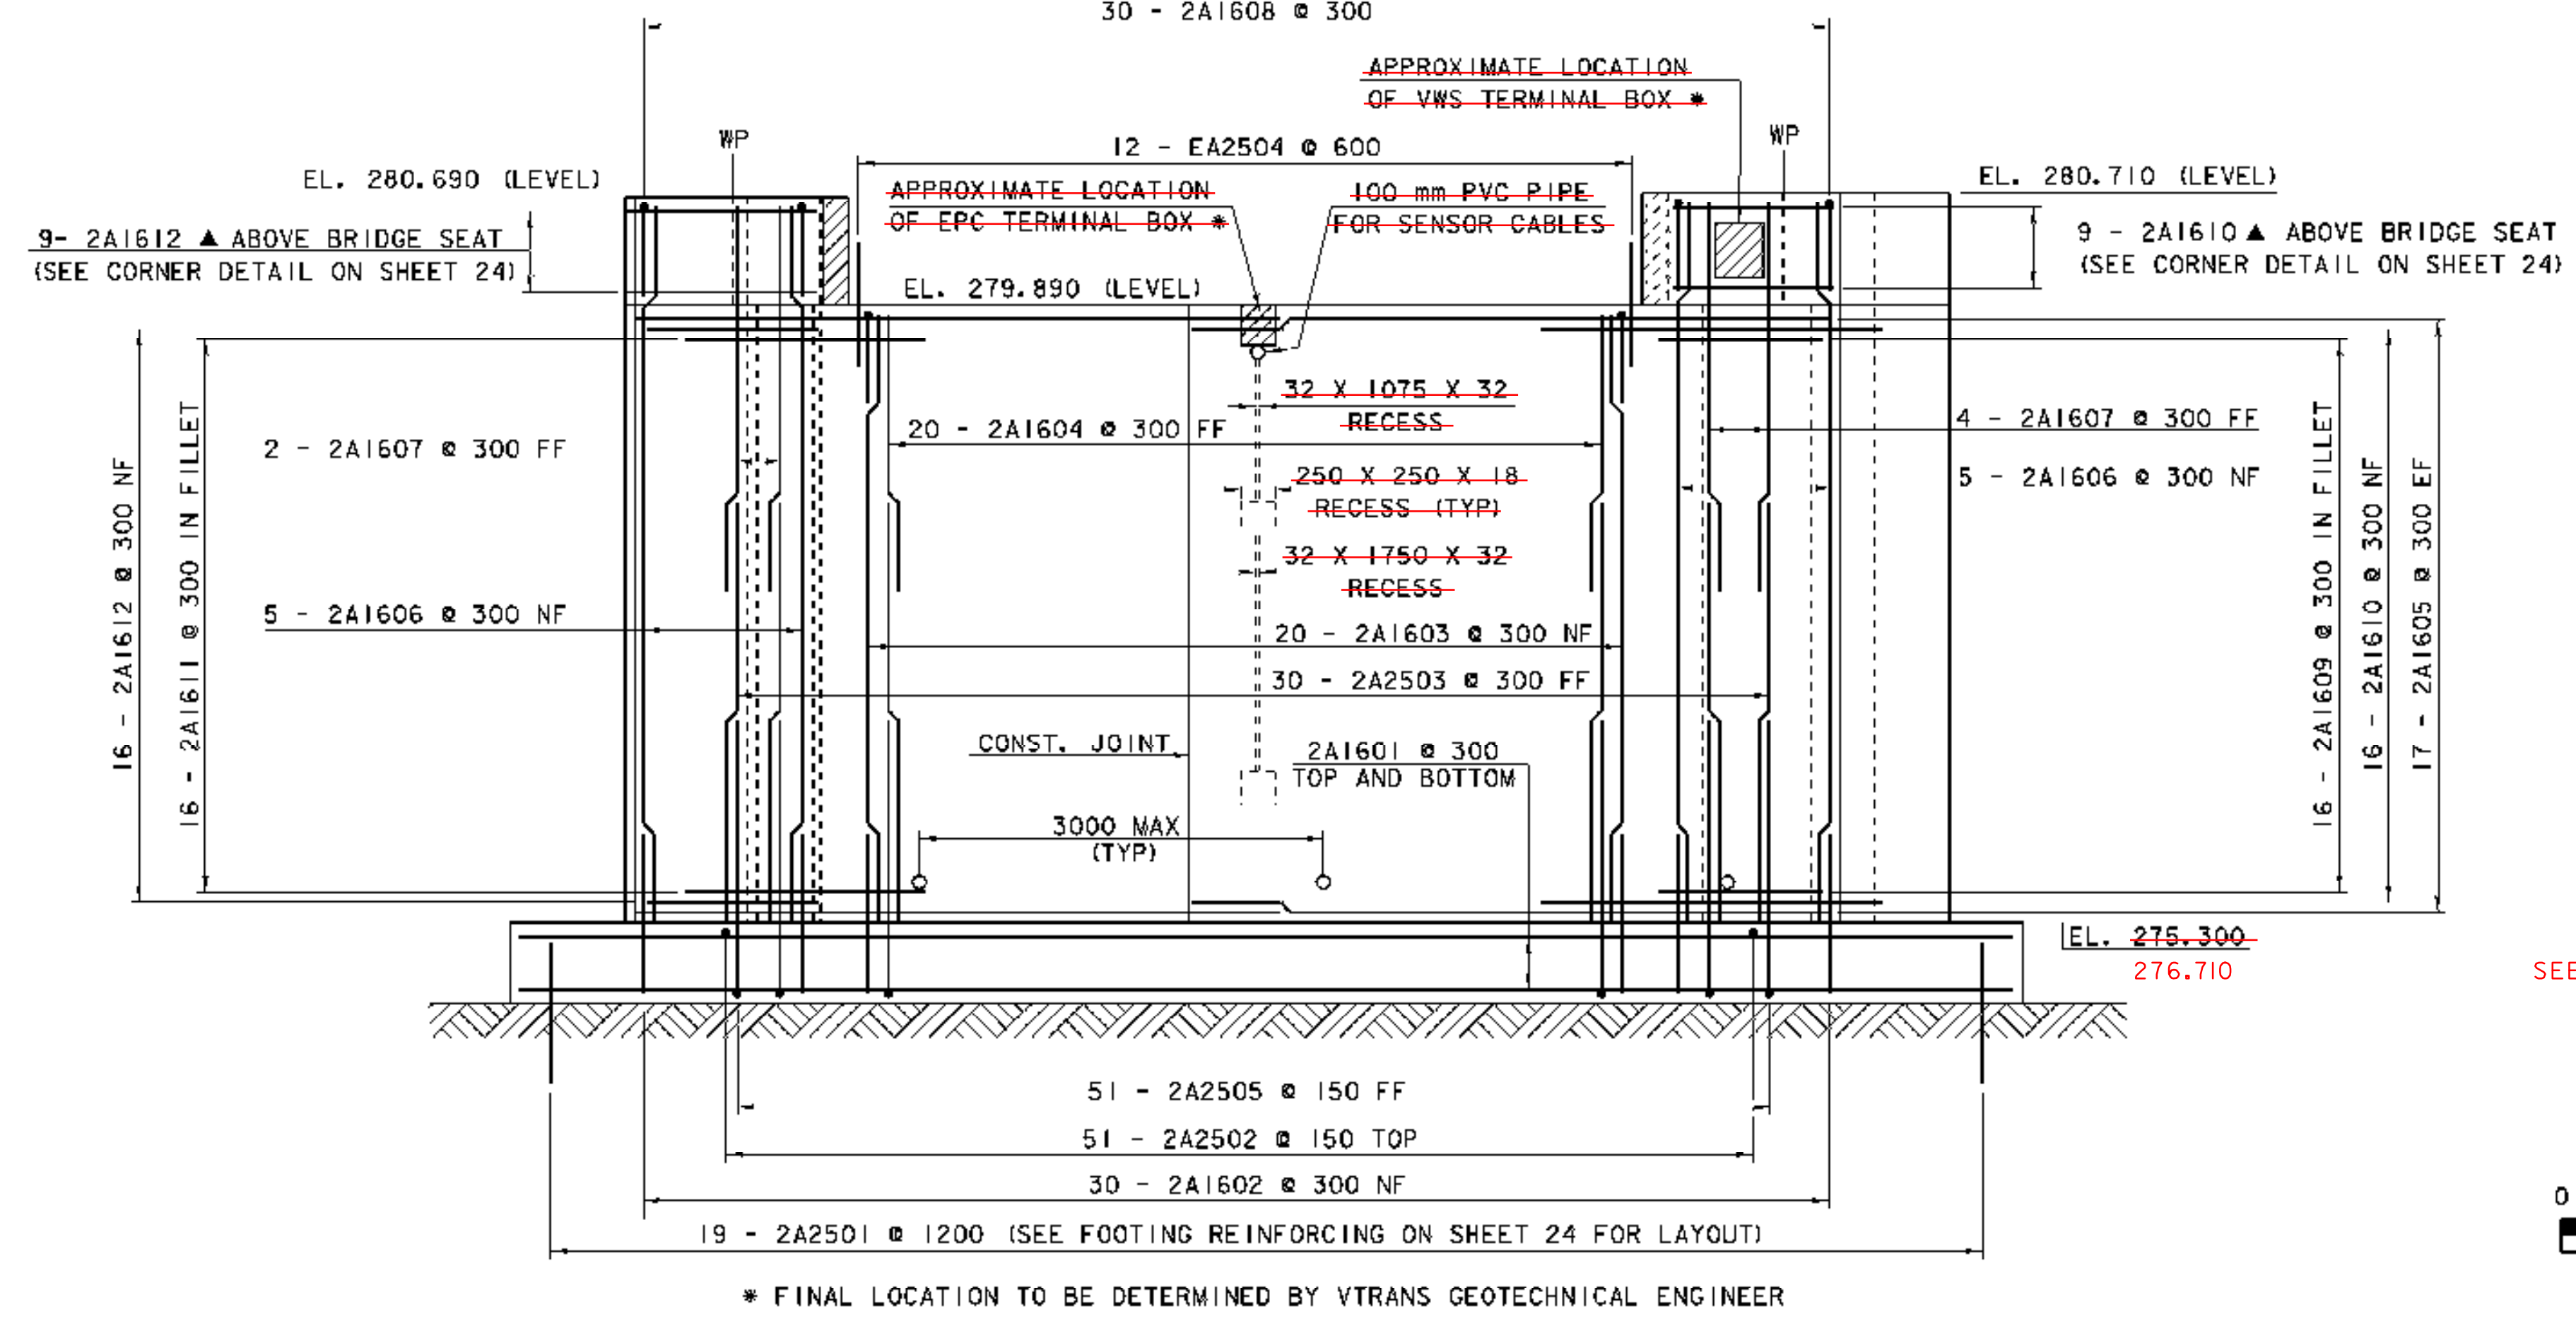

ABUTMENT NO. 2 ELEVATION

SCALE 1:40

SEE NOTE 1, SHEET 20 OF 42

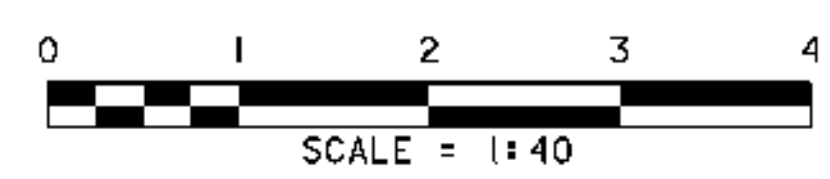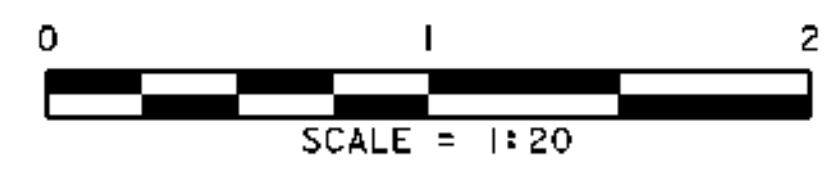

PROJECT: CABOT	PROJECT NO.: BRO 1446 (27)
DESIGN FILE NAME: /96/270/structures/s/270sub.dgn	PLOT DATE: 07-DEC-2007
IPARM FILE NAME: s/270ab2.1	DRAWN BY: L. C. ASHWORTH
DESIGNED BY: J. B. HUSSEY	CHECKED BY: K. M. HIGGINS
SQUAD LEADER: C. P. WILLIAMS	SHEET: 21 OF 42
ABUTMENT#2 DETAIL SHEET	