



STA 2+009.000 RT (ABUT 2)
 BEGIN STONE FILL TYPE III
 BEGIN GEOTEXTILE UNDER STONE FILL
 BEGIN GRUBBING MATERIAL
 BEGIN UNCLASSIFIED CHANNEL EXCAVATION

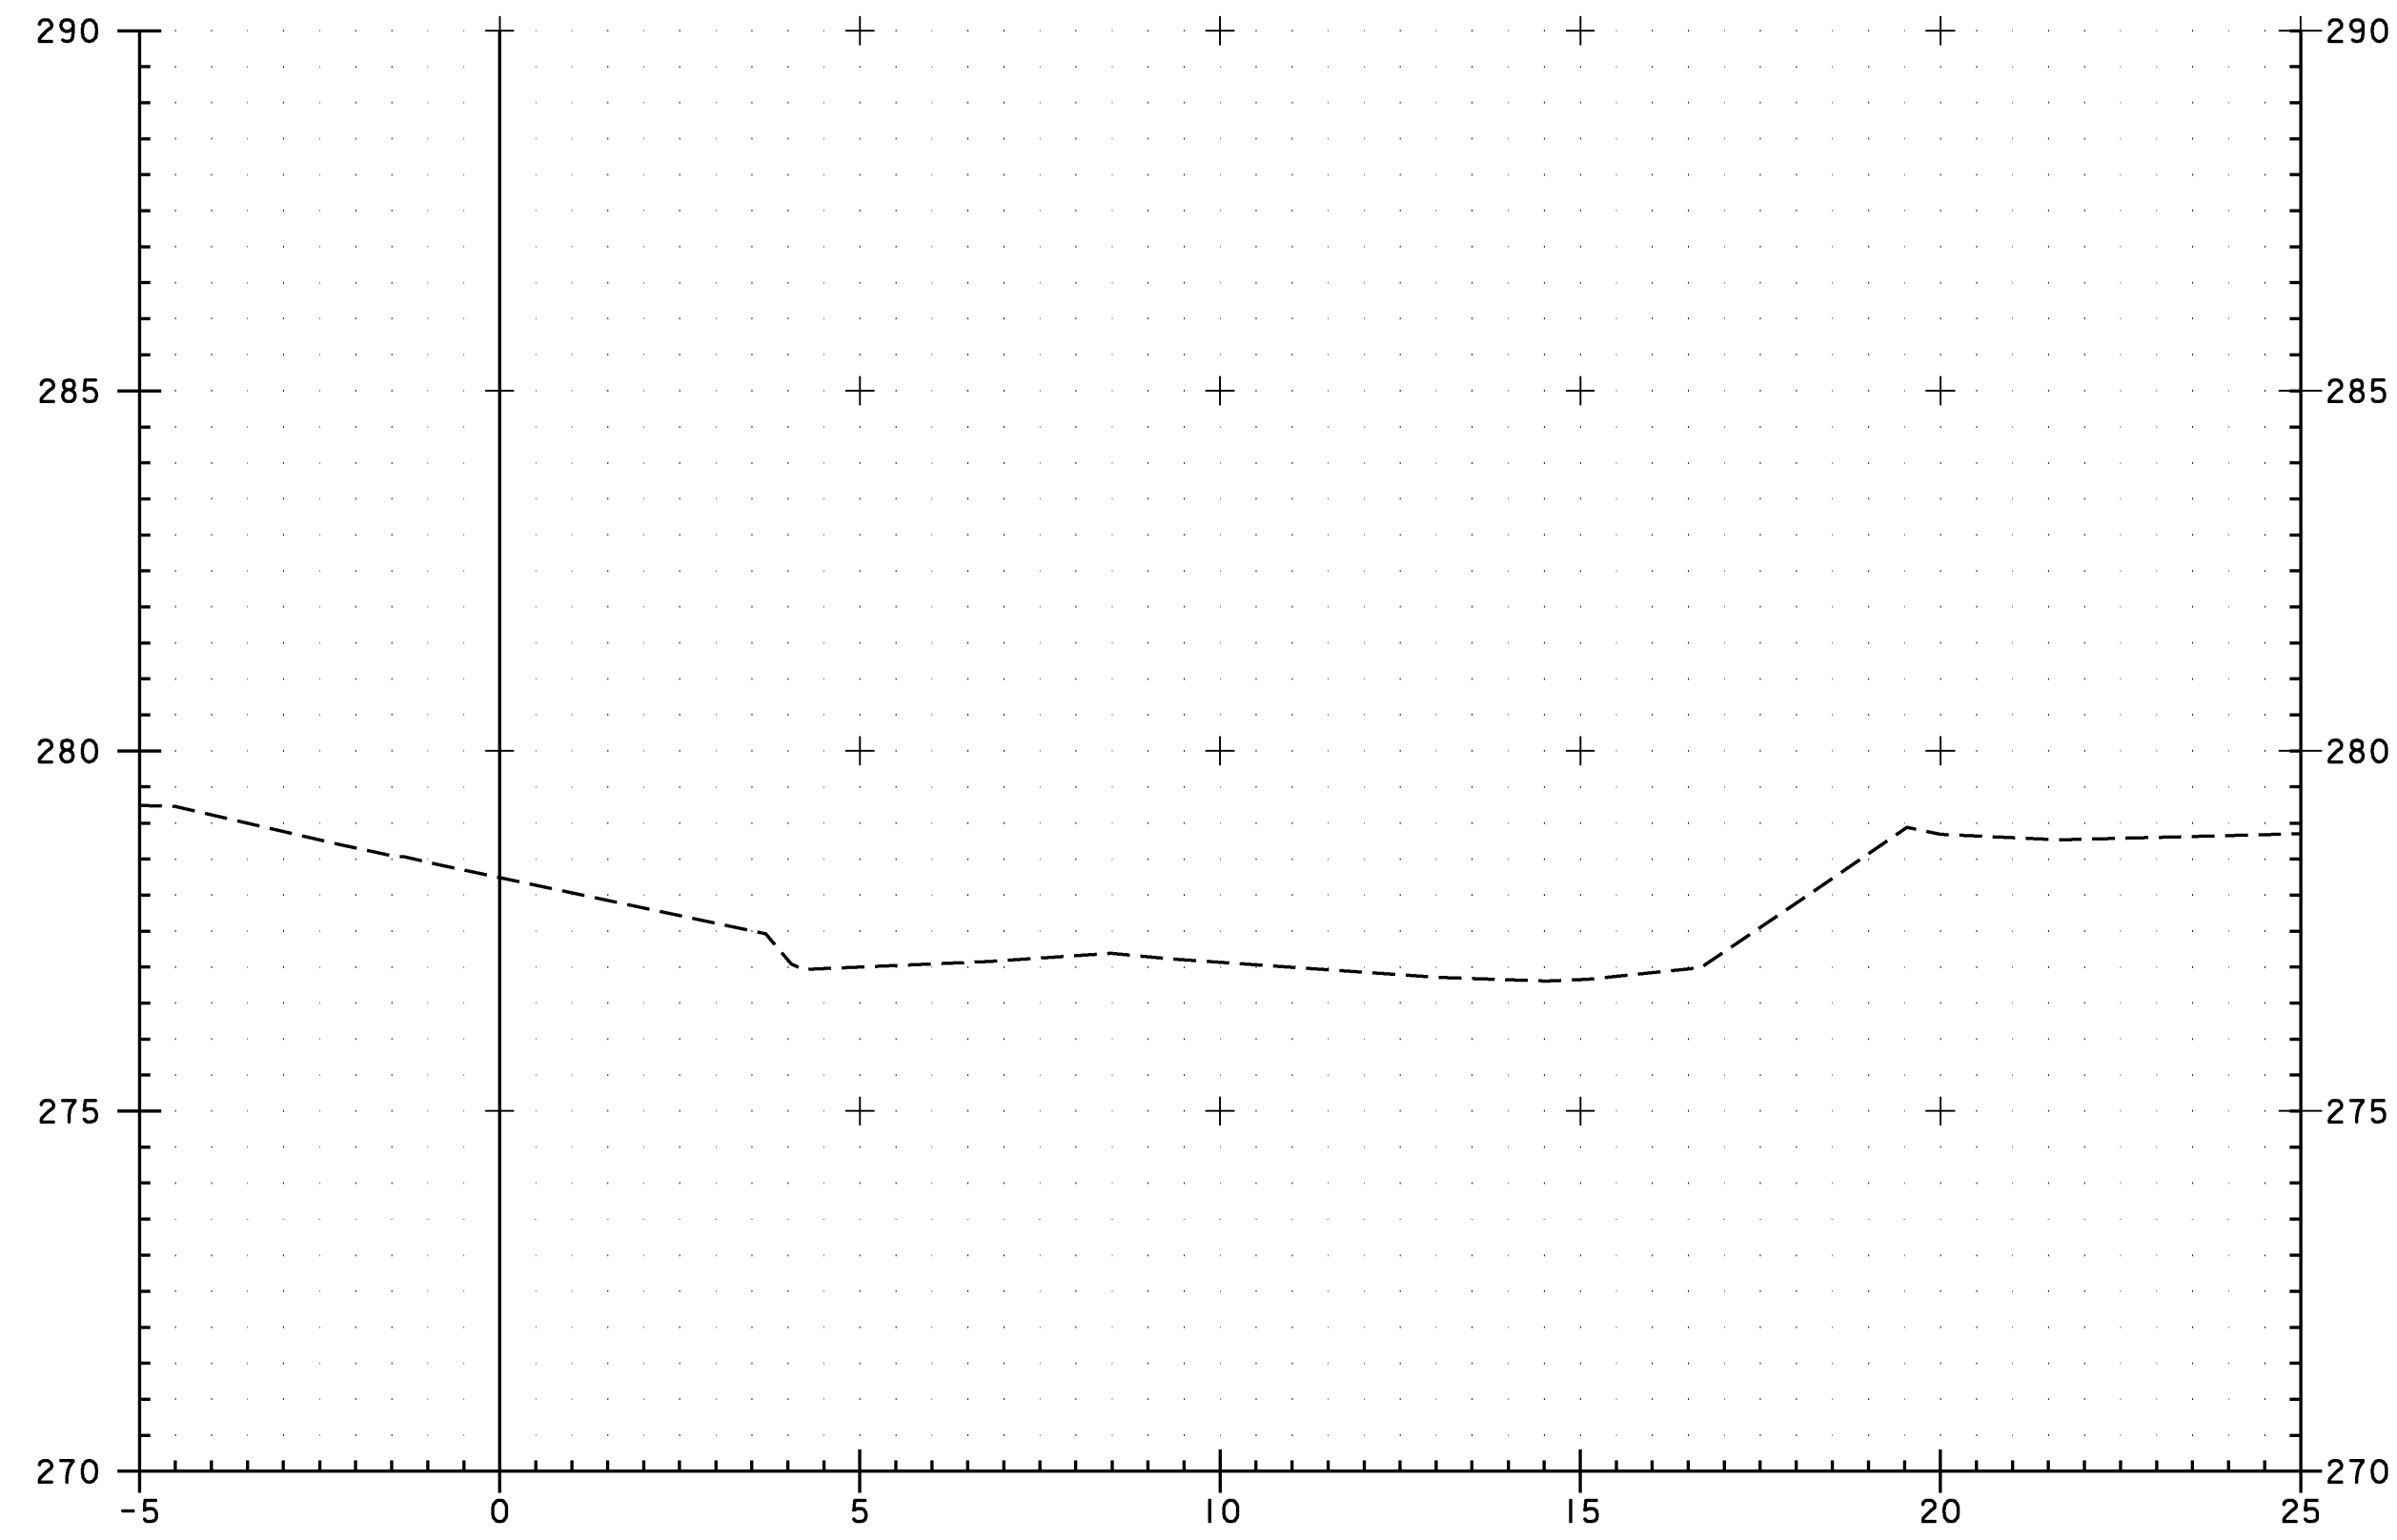


2+005

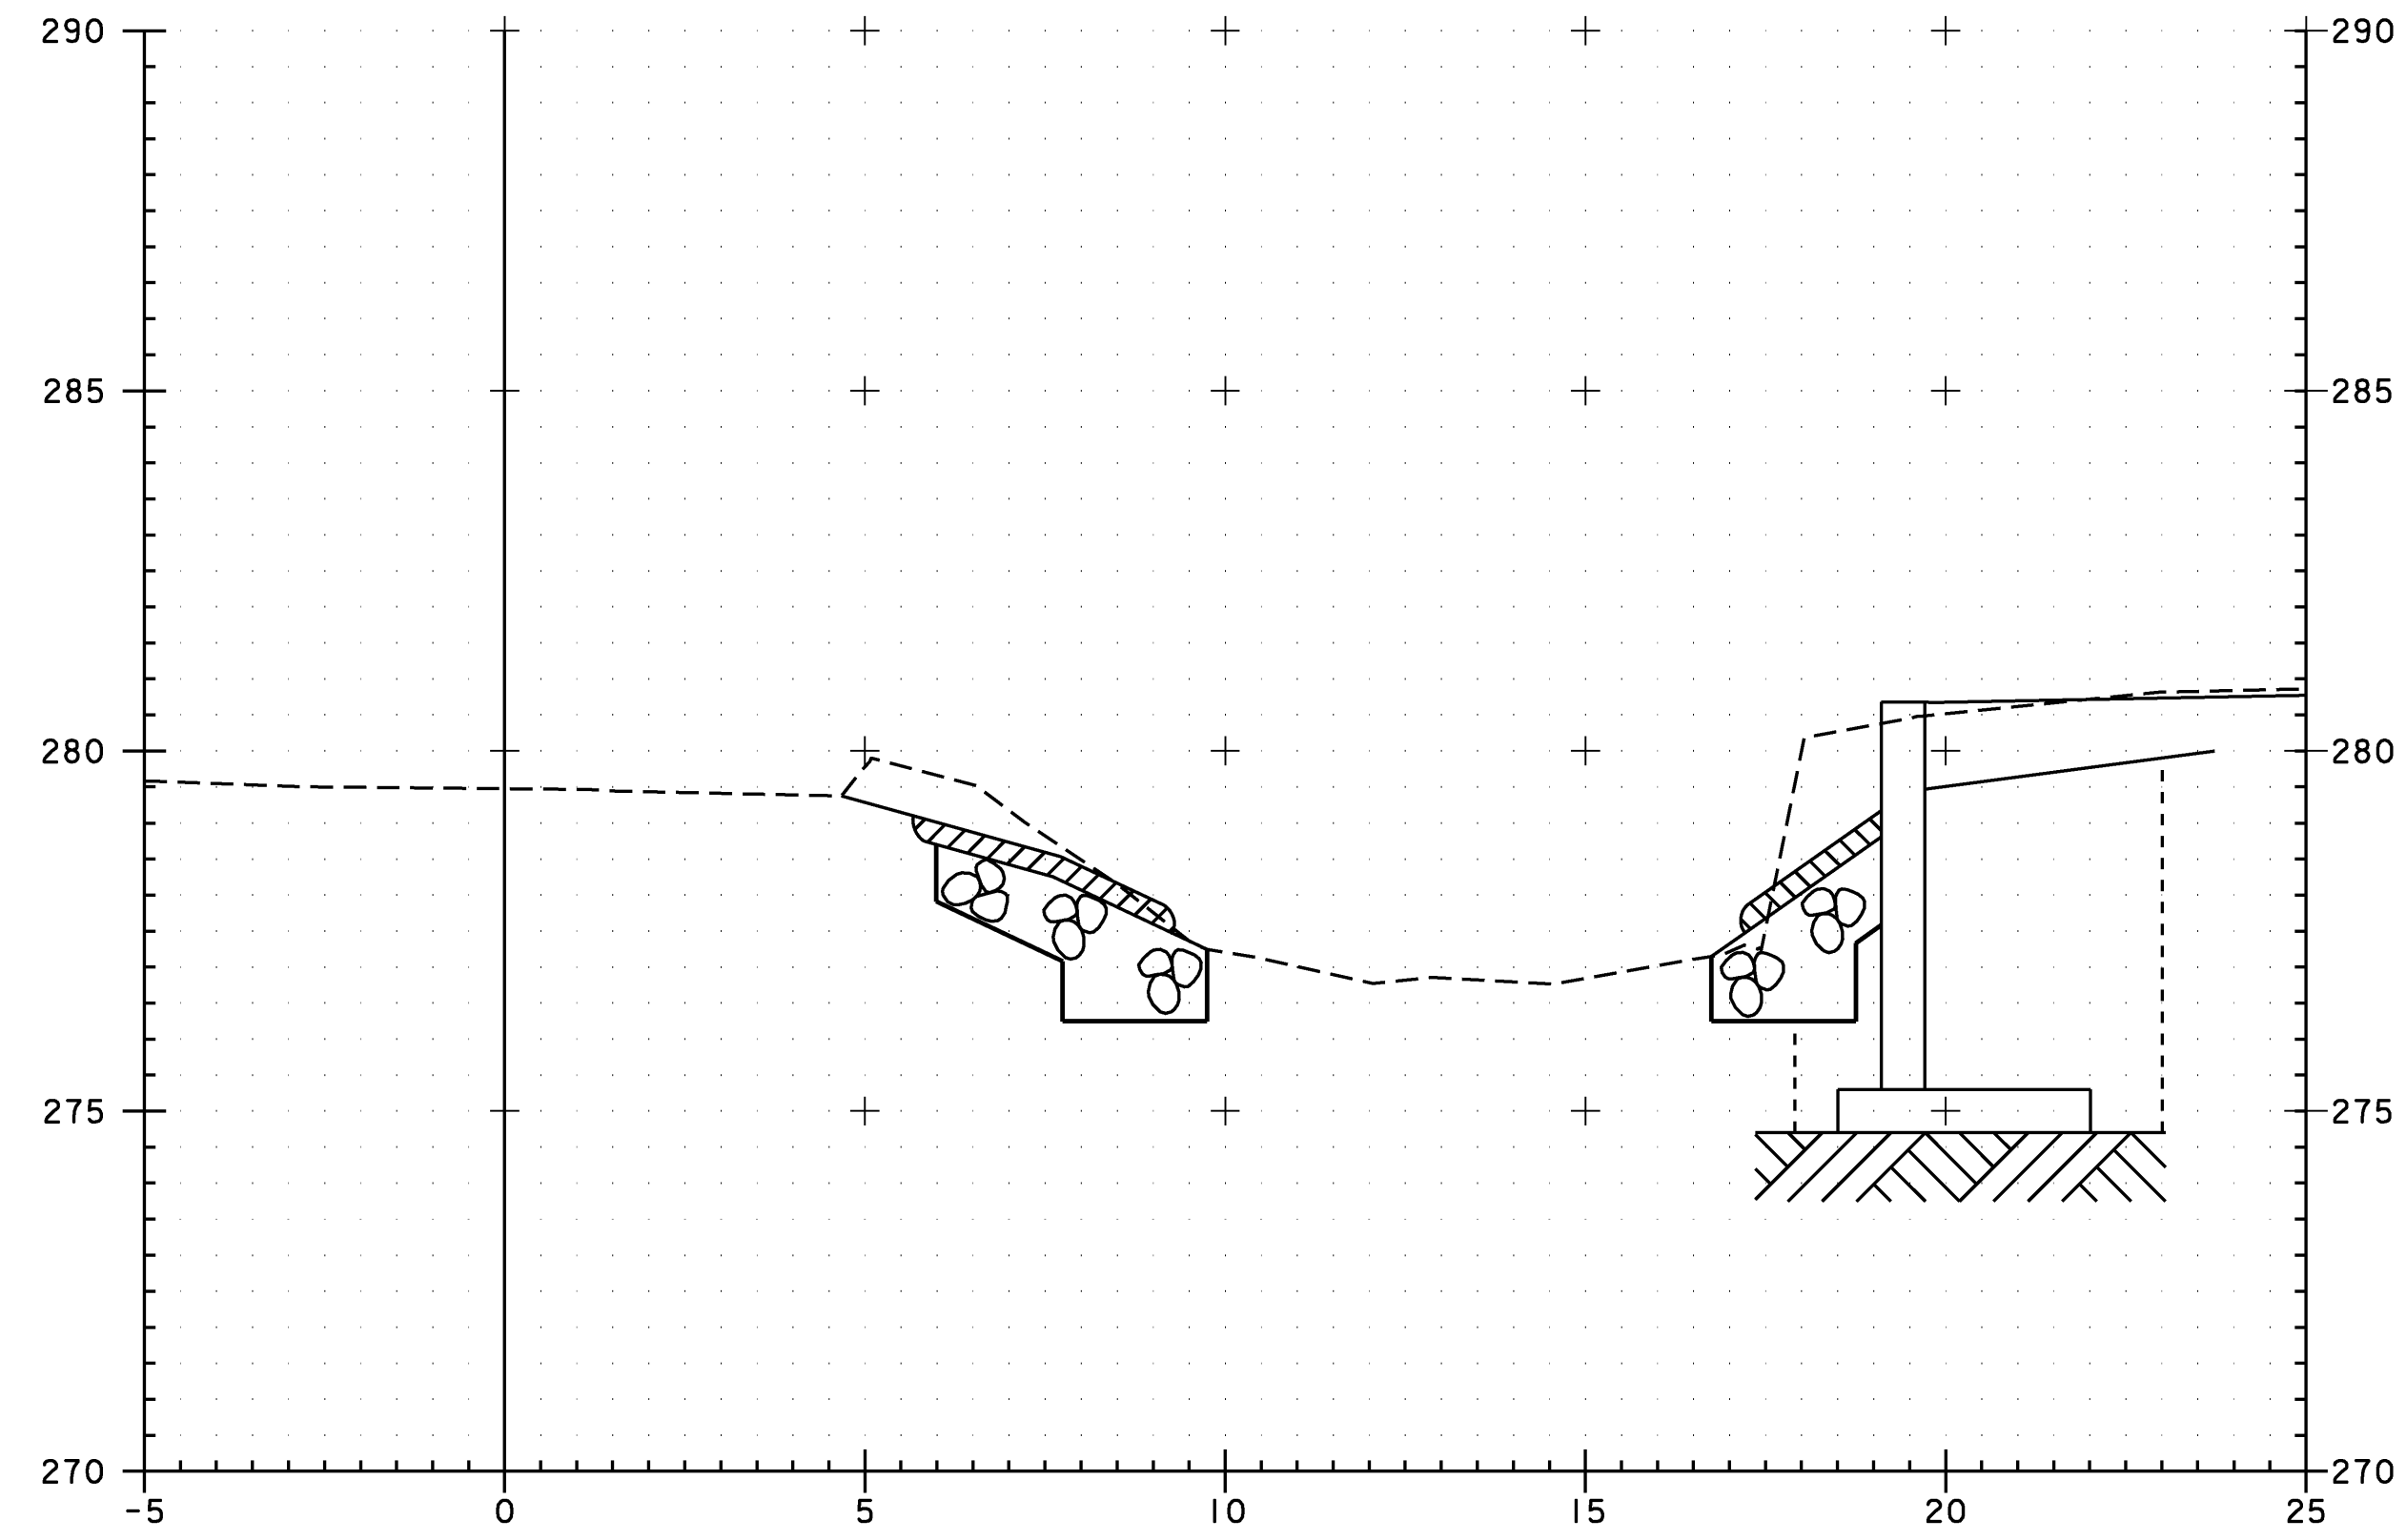


2+015


STA 2+013.500 RT (ABUT 1)
 BEGIN STONE FILL TYPE III
 BEGIN GEOTEXTILE UNDER STONE FILL
 BEGIN GRUBBING MATERIAL
 BEGIN UNCLASSIFIED CHANNEL EXCAVATION

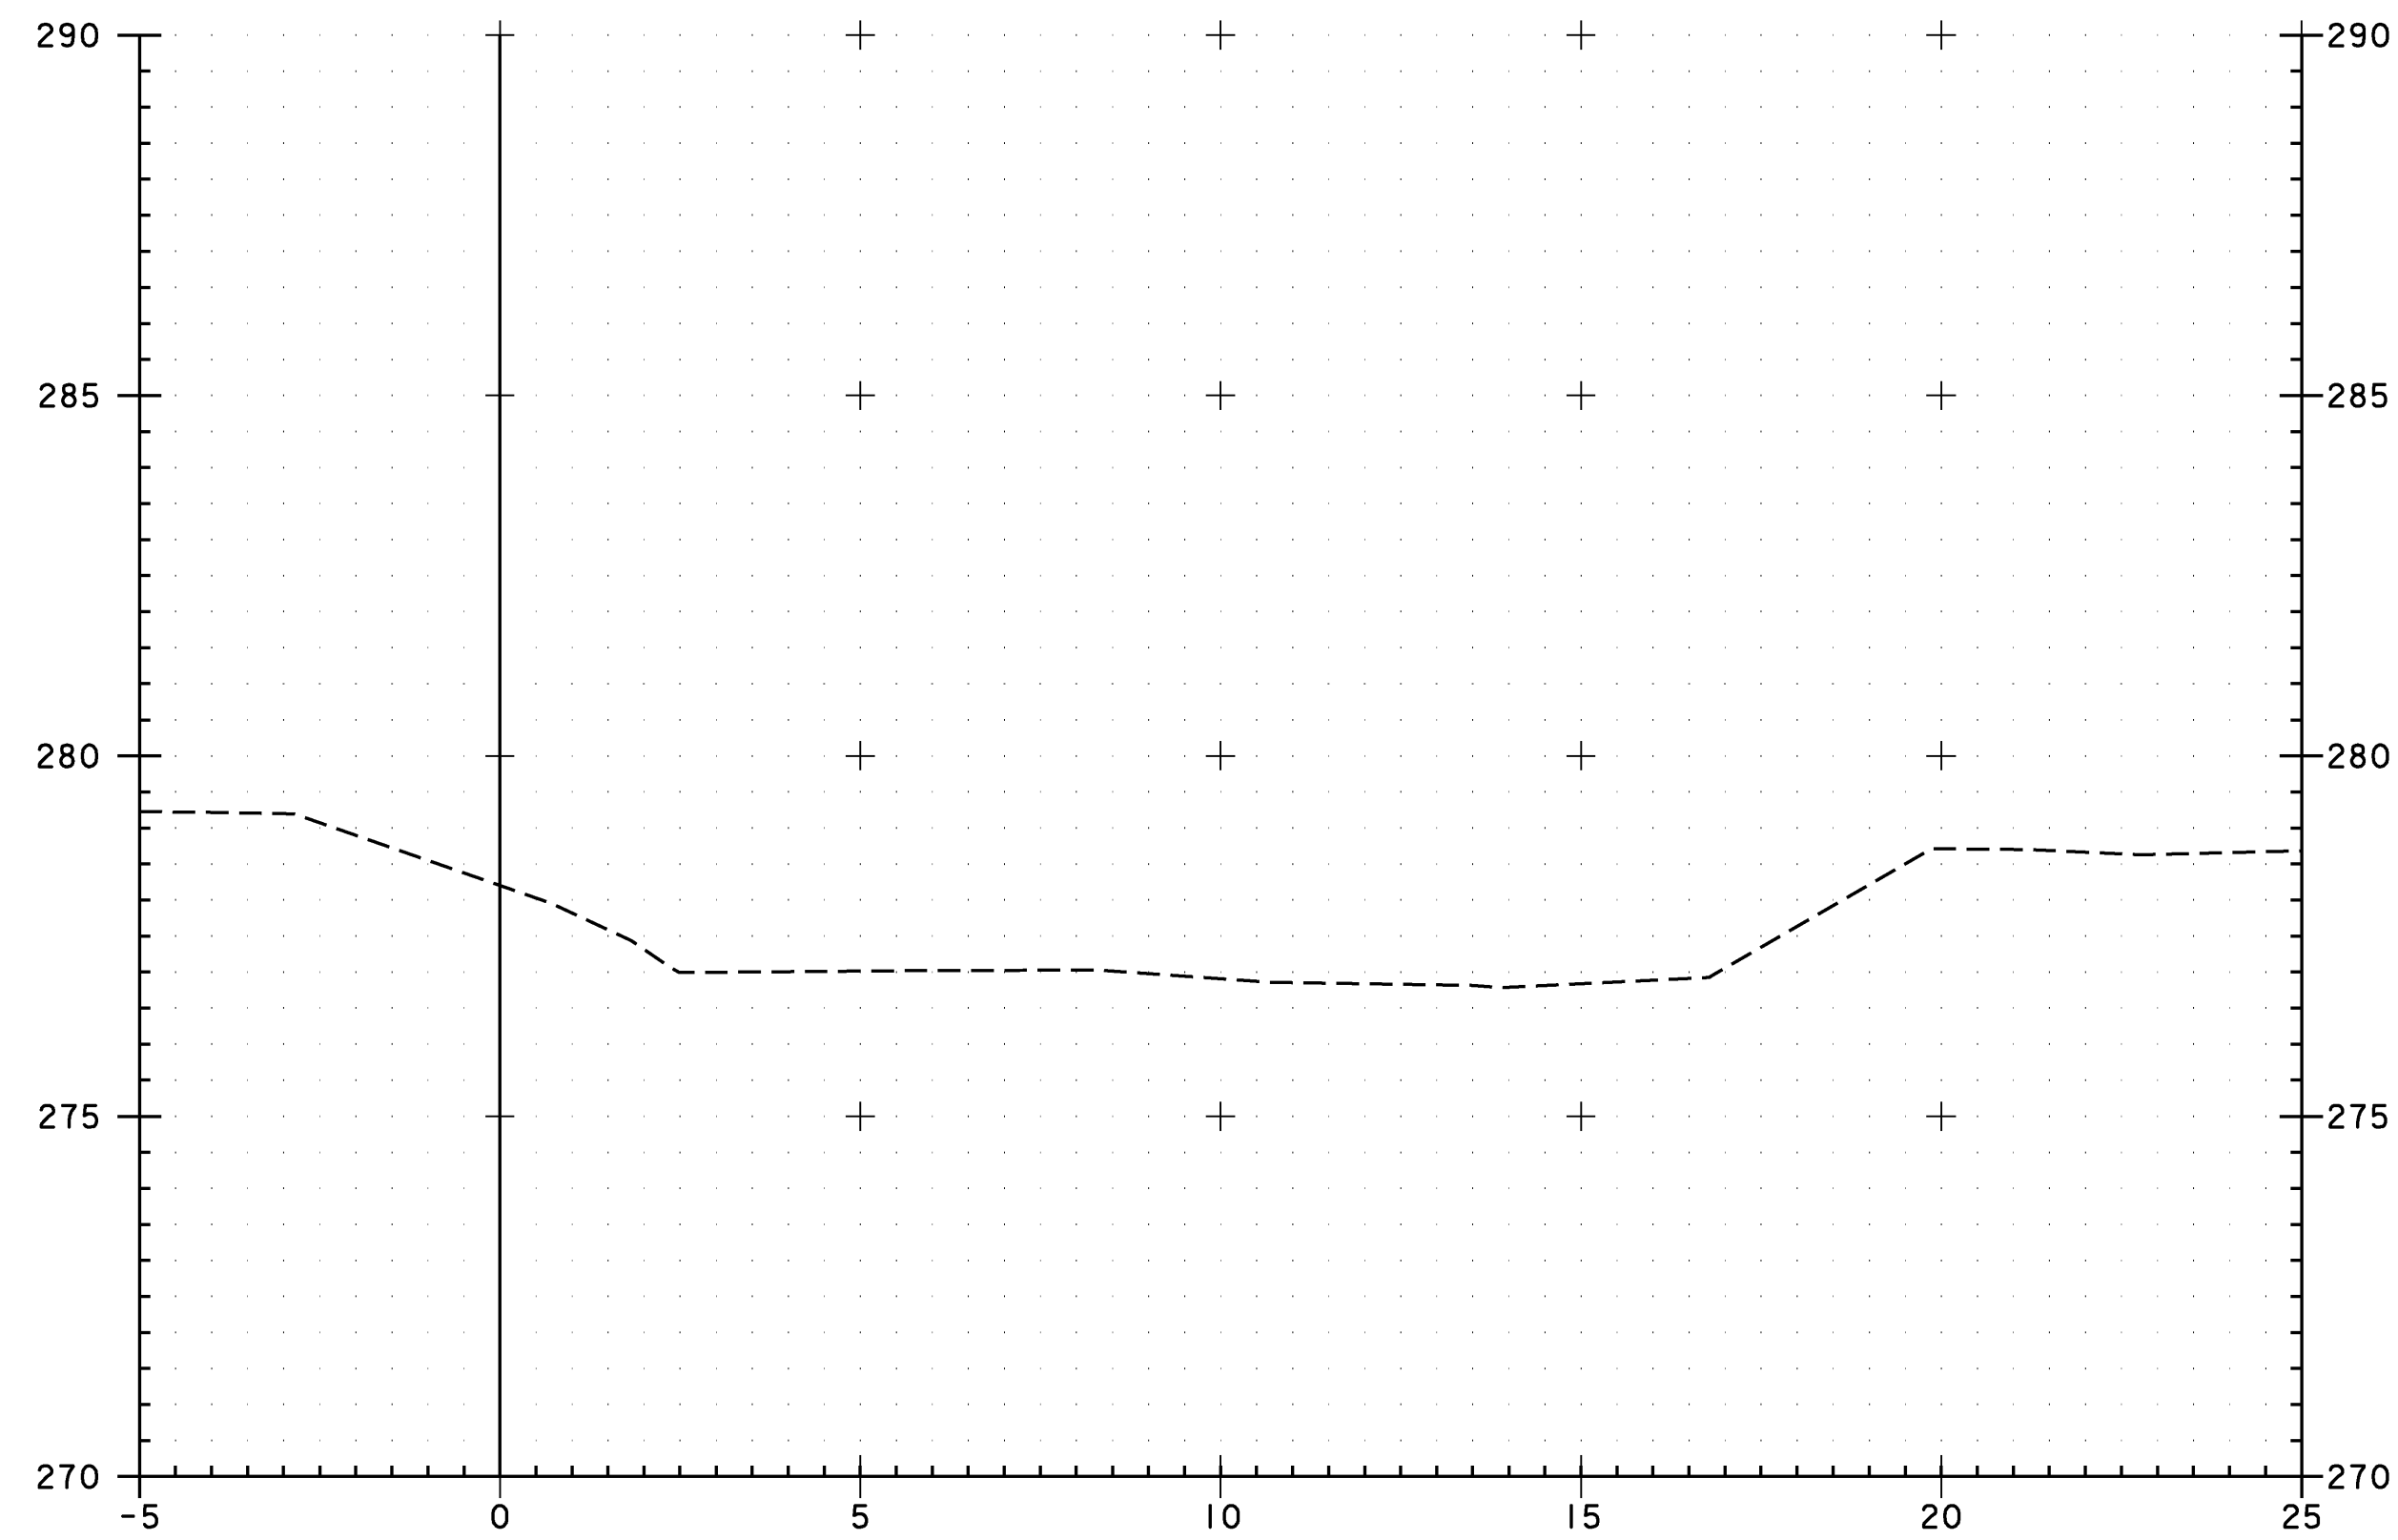

2+000

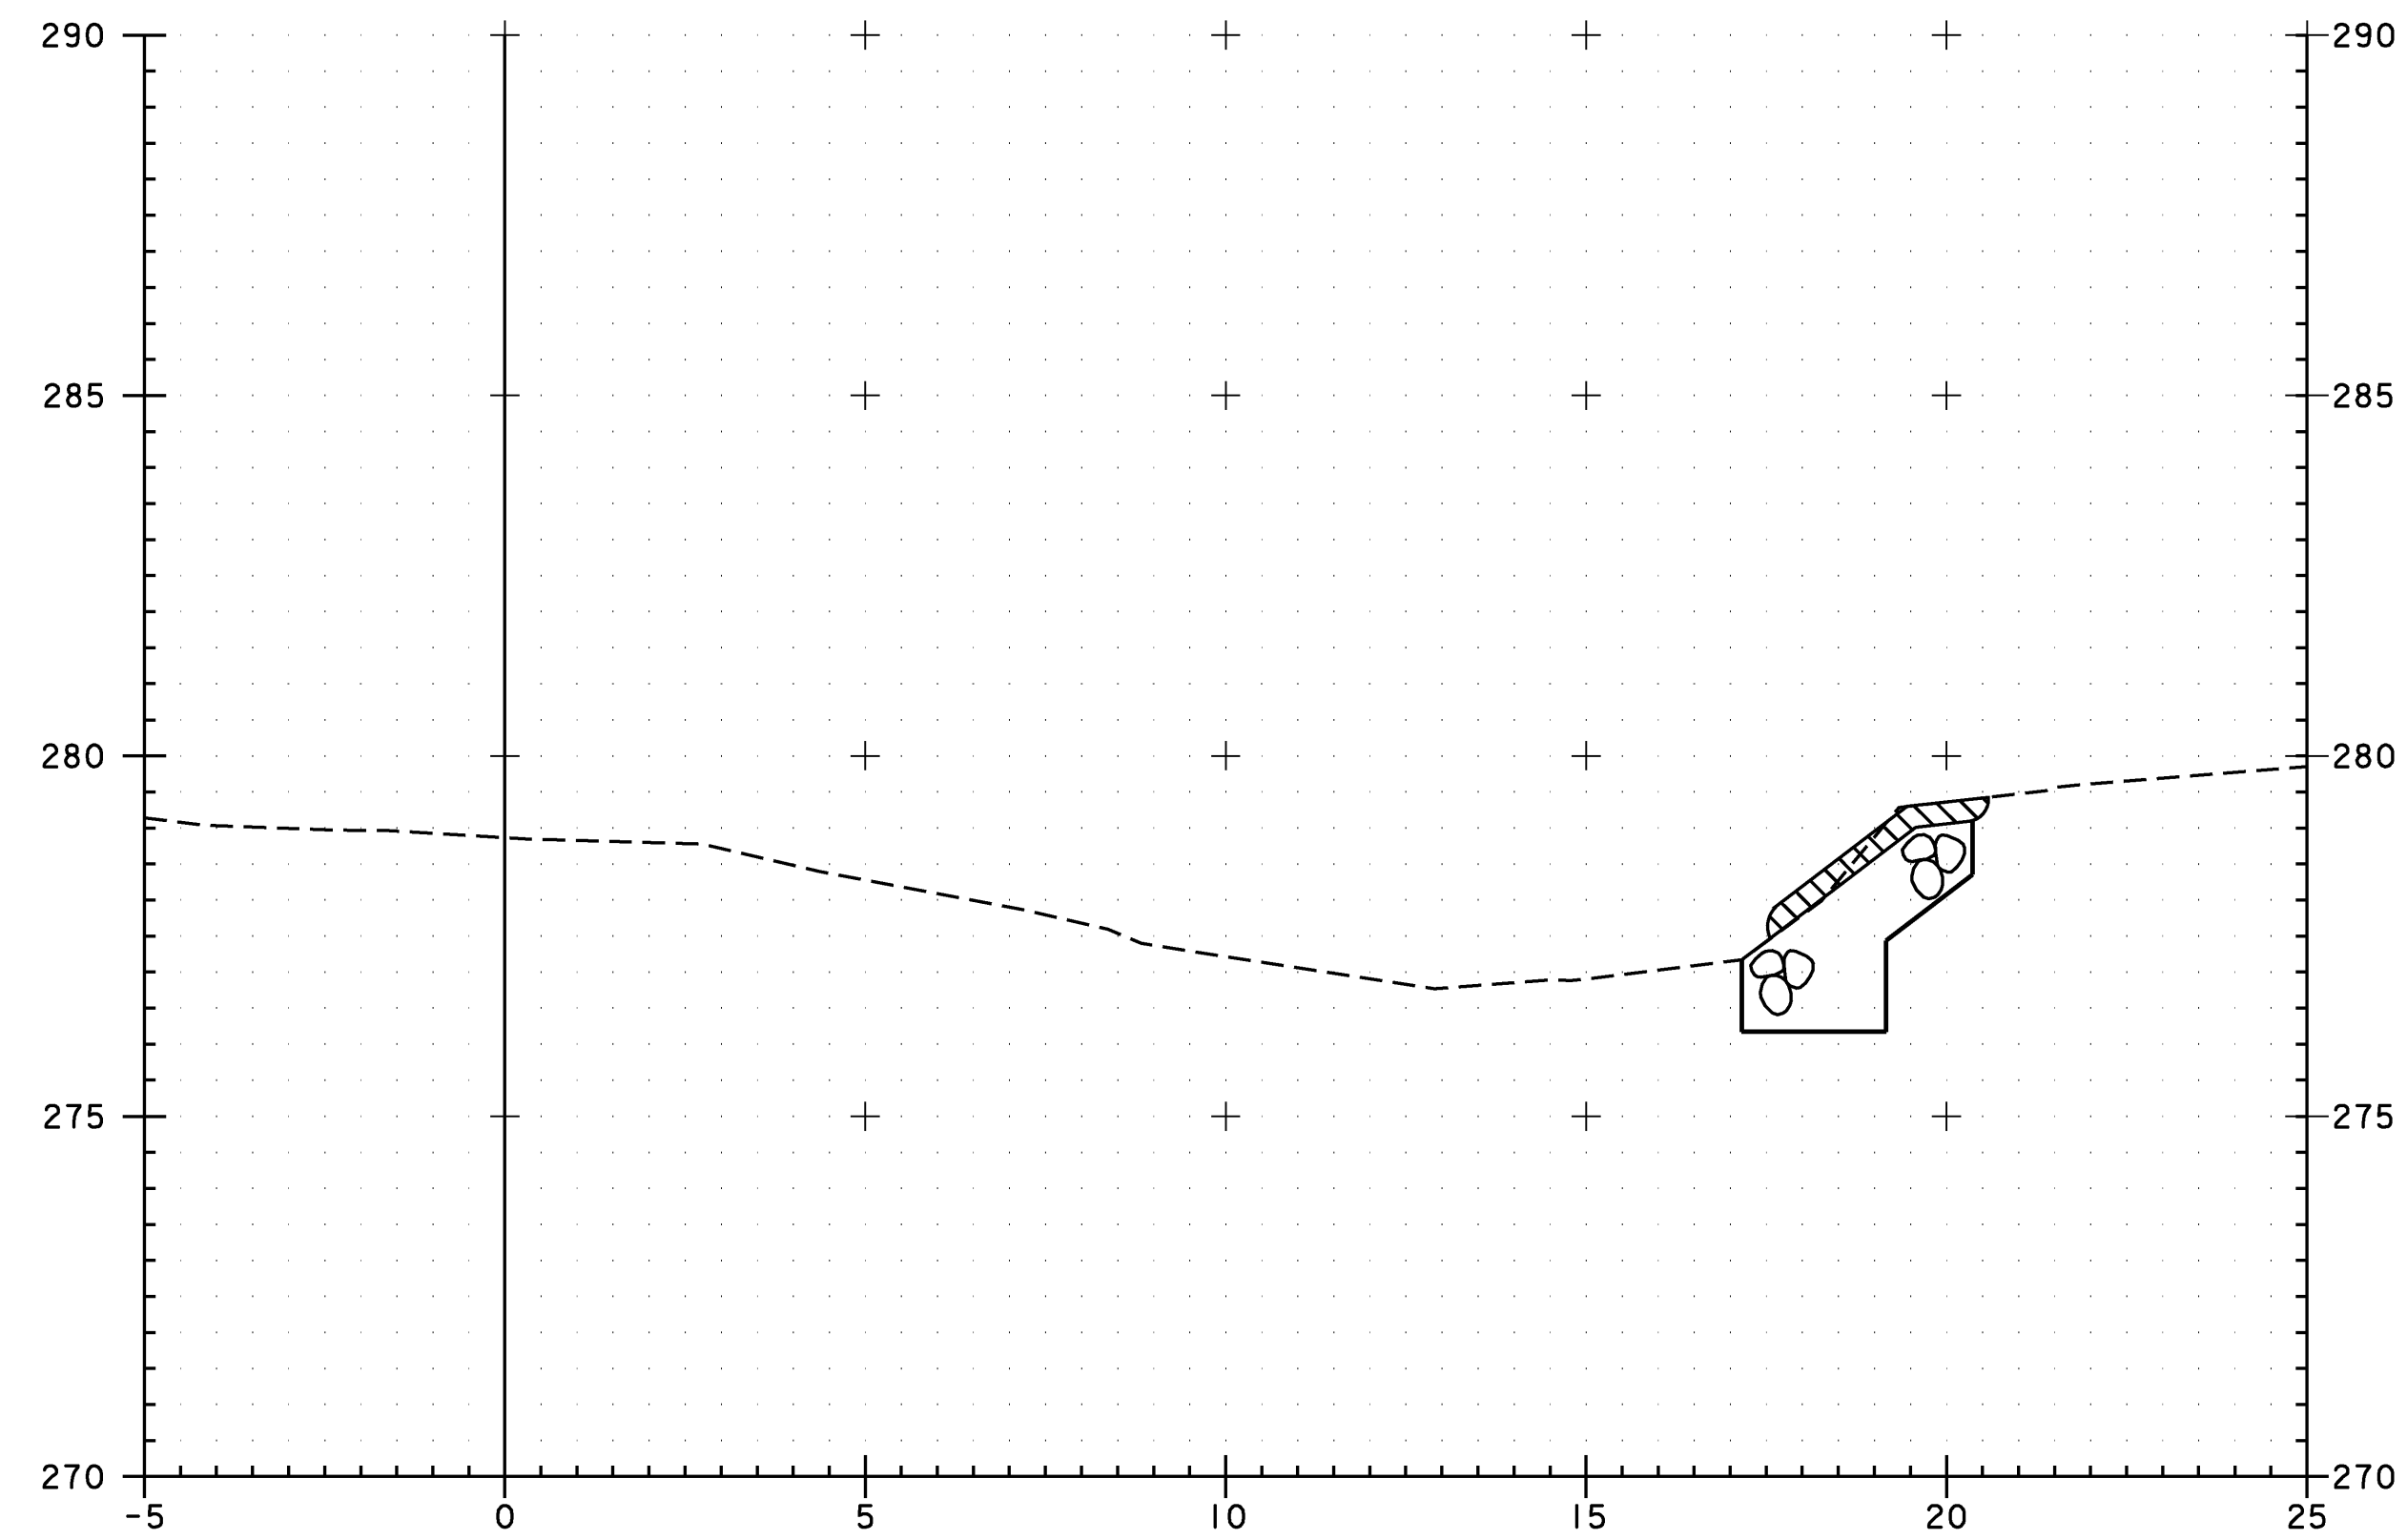

2+010

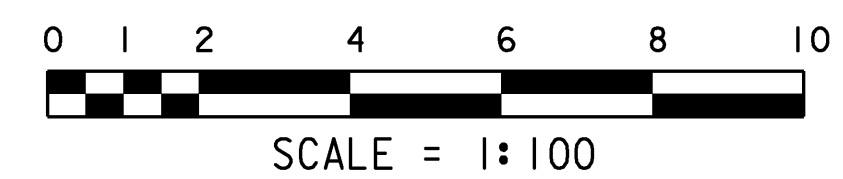

PROJECT: CABOT	PROJECT NO.: BRO 1446 (27)
DESIGN FILE NAME: 96j270/structures/sj270xsl.dgn	PLOT DATE: 07-DEC-2007
CHANNEL CROSS SECTIONS	
SECTION 2+000 THROUGH 2+015	SHEET: 40 OF 42