



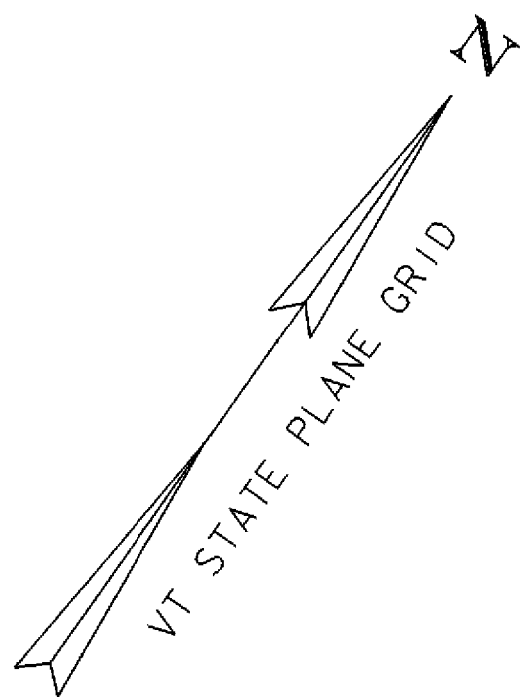


**CONSTRUCTION APPROACH SIGNING**  
NOT TO SCALE

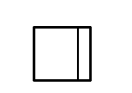

**LEGEND**

-  TYPE III BARRICADE
-  TYPE III BARRICADE (MODIFIED)
-  REFLECTORIZED BARRELS

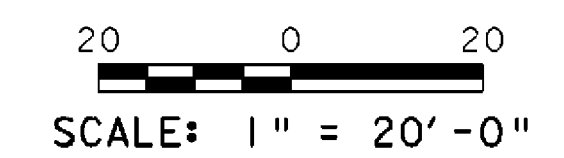

**TRAFFIC CONTROL SHEET**

PROJECT NAME: SPRINGFIELD	PLOT DATE: 27-DEC-2007
PROJECT NUMBER: BHO 1442(30)	DRAWN BY: G. ROY
FILE NAME: 96j348/str/s96j348tc.dgn	CHECKED BY: C. CARLSON
PROJECT MANAGER: R. R. WHITCOMB	SHEET 13A OF 85
DESIGNED BY: G. ROY	
s96j348tc.i	