


PLAN
 SCALE: 1" = 10'-0"

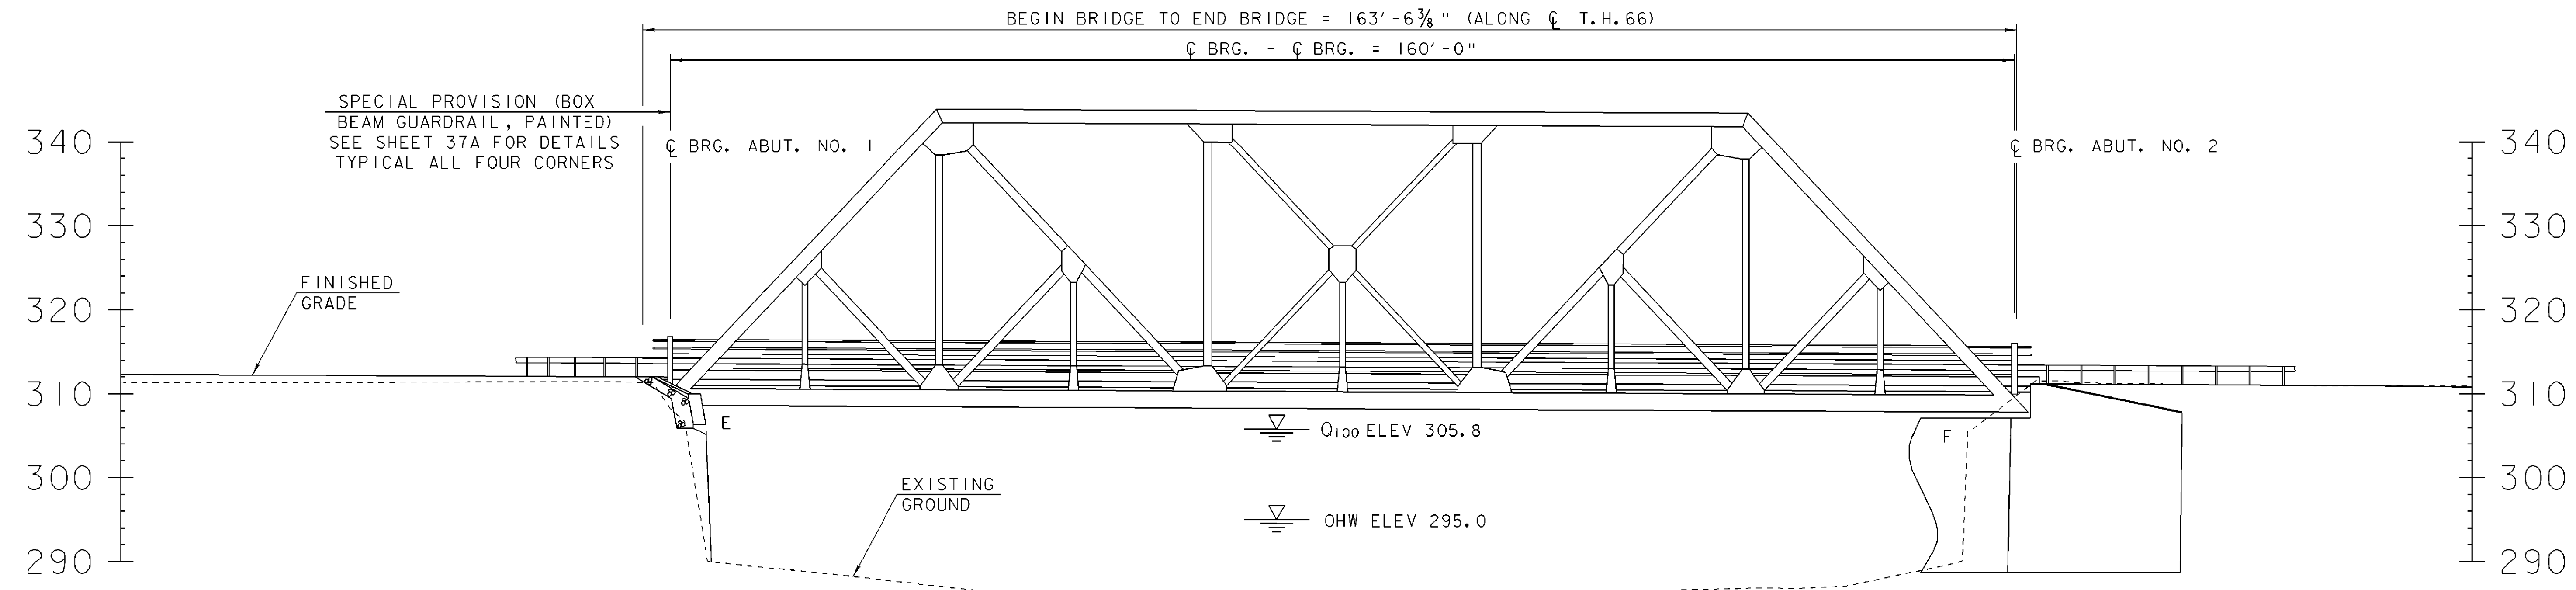

ELEVATION
 SCALE: 1" = 10'-0"

PLAN AND ELEVATION

PROJECT NAME: SPRINGFIELD	PLOT DATE: 27-DEC-2007
PROJECT NUMBER: BHO 1442(30)	DRAWN BY: G. ROY
FILE NAME: 96j348/str/s96j348pe.dgn	CHECKED BY: C. CARLSON
PROJECT MANAGER: R. R. WHITCOMB	SHEET 20 OF 85
DESIGNED BY: G. ROY	
s96j348pe.i	