



SOUTHWEST QUADRANT

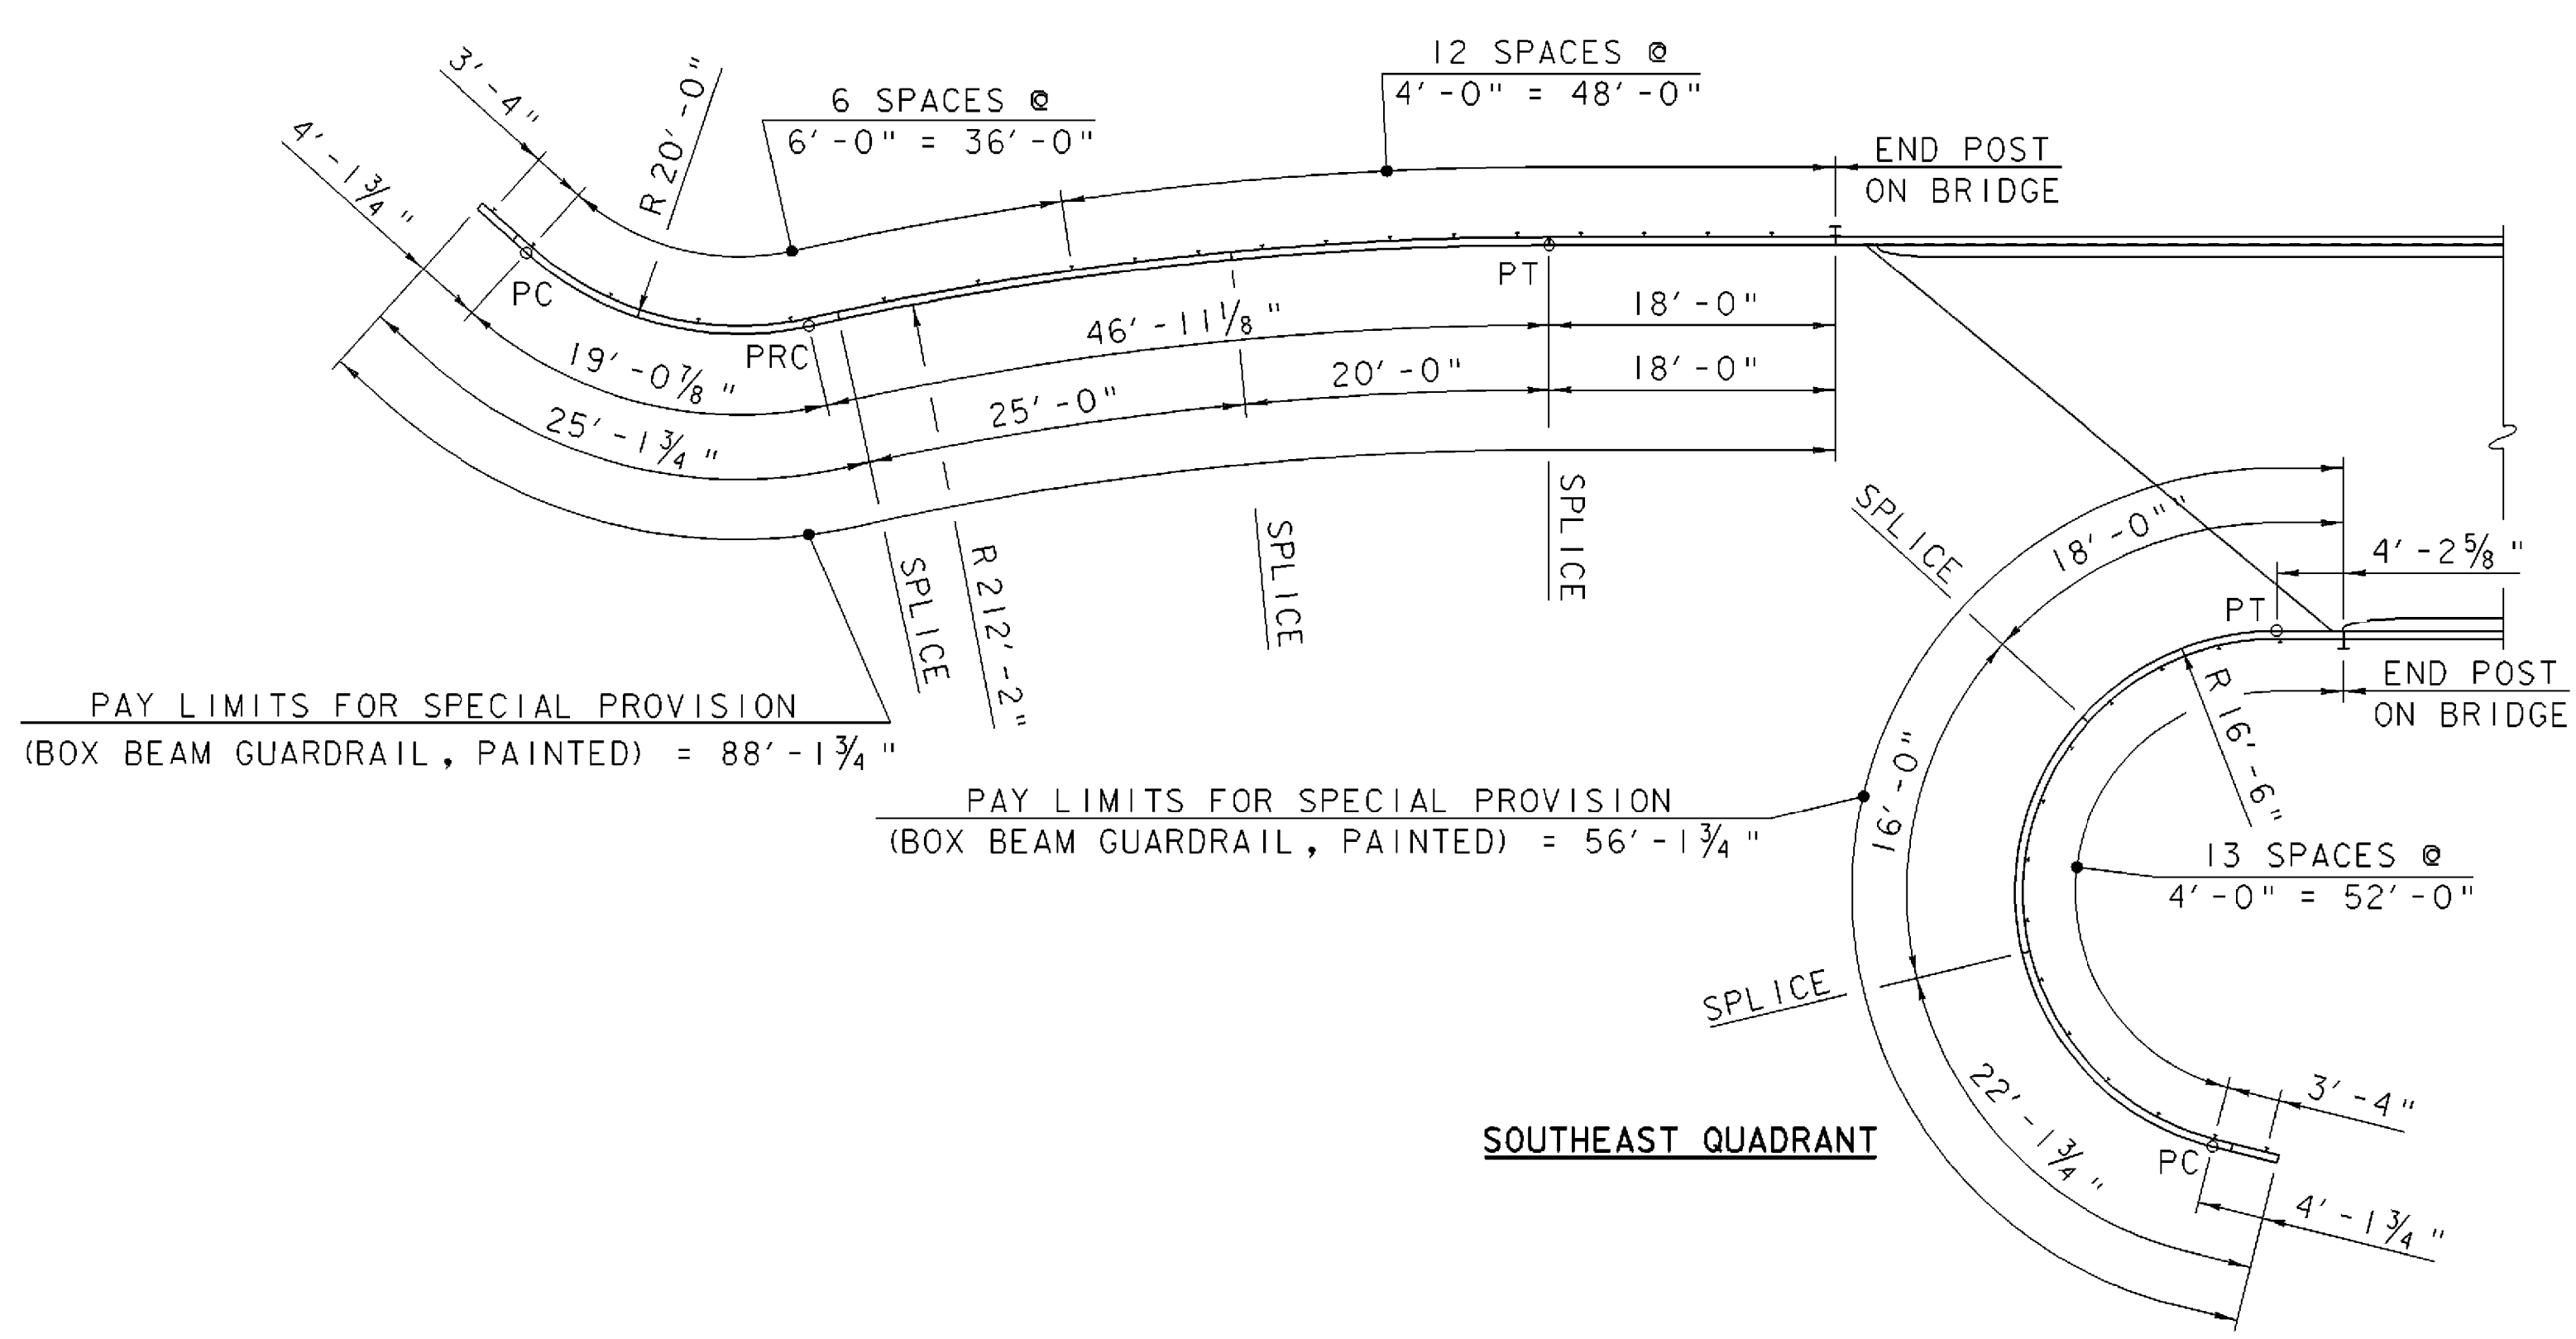


NORTHWEST QUADRANT

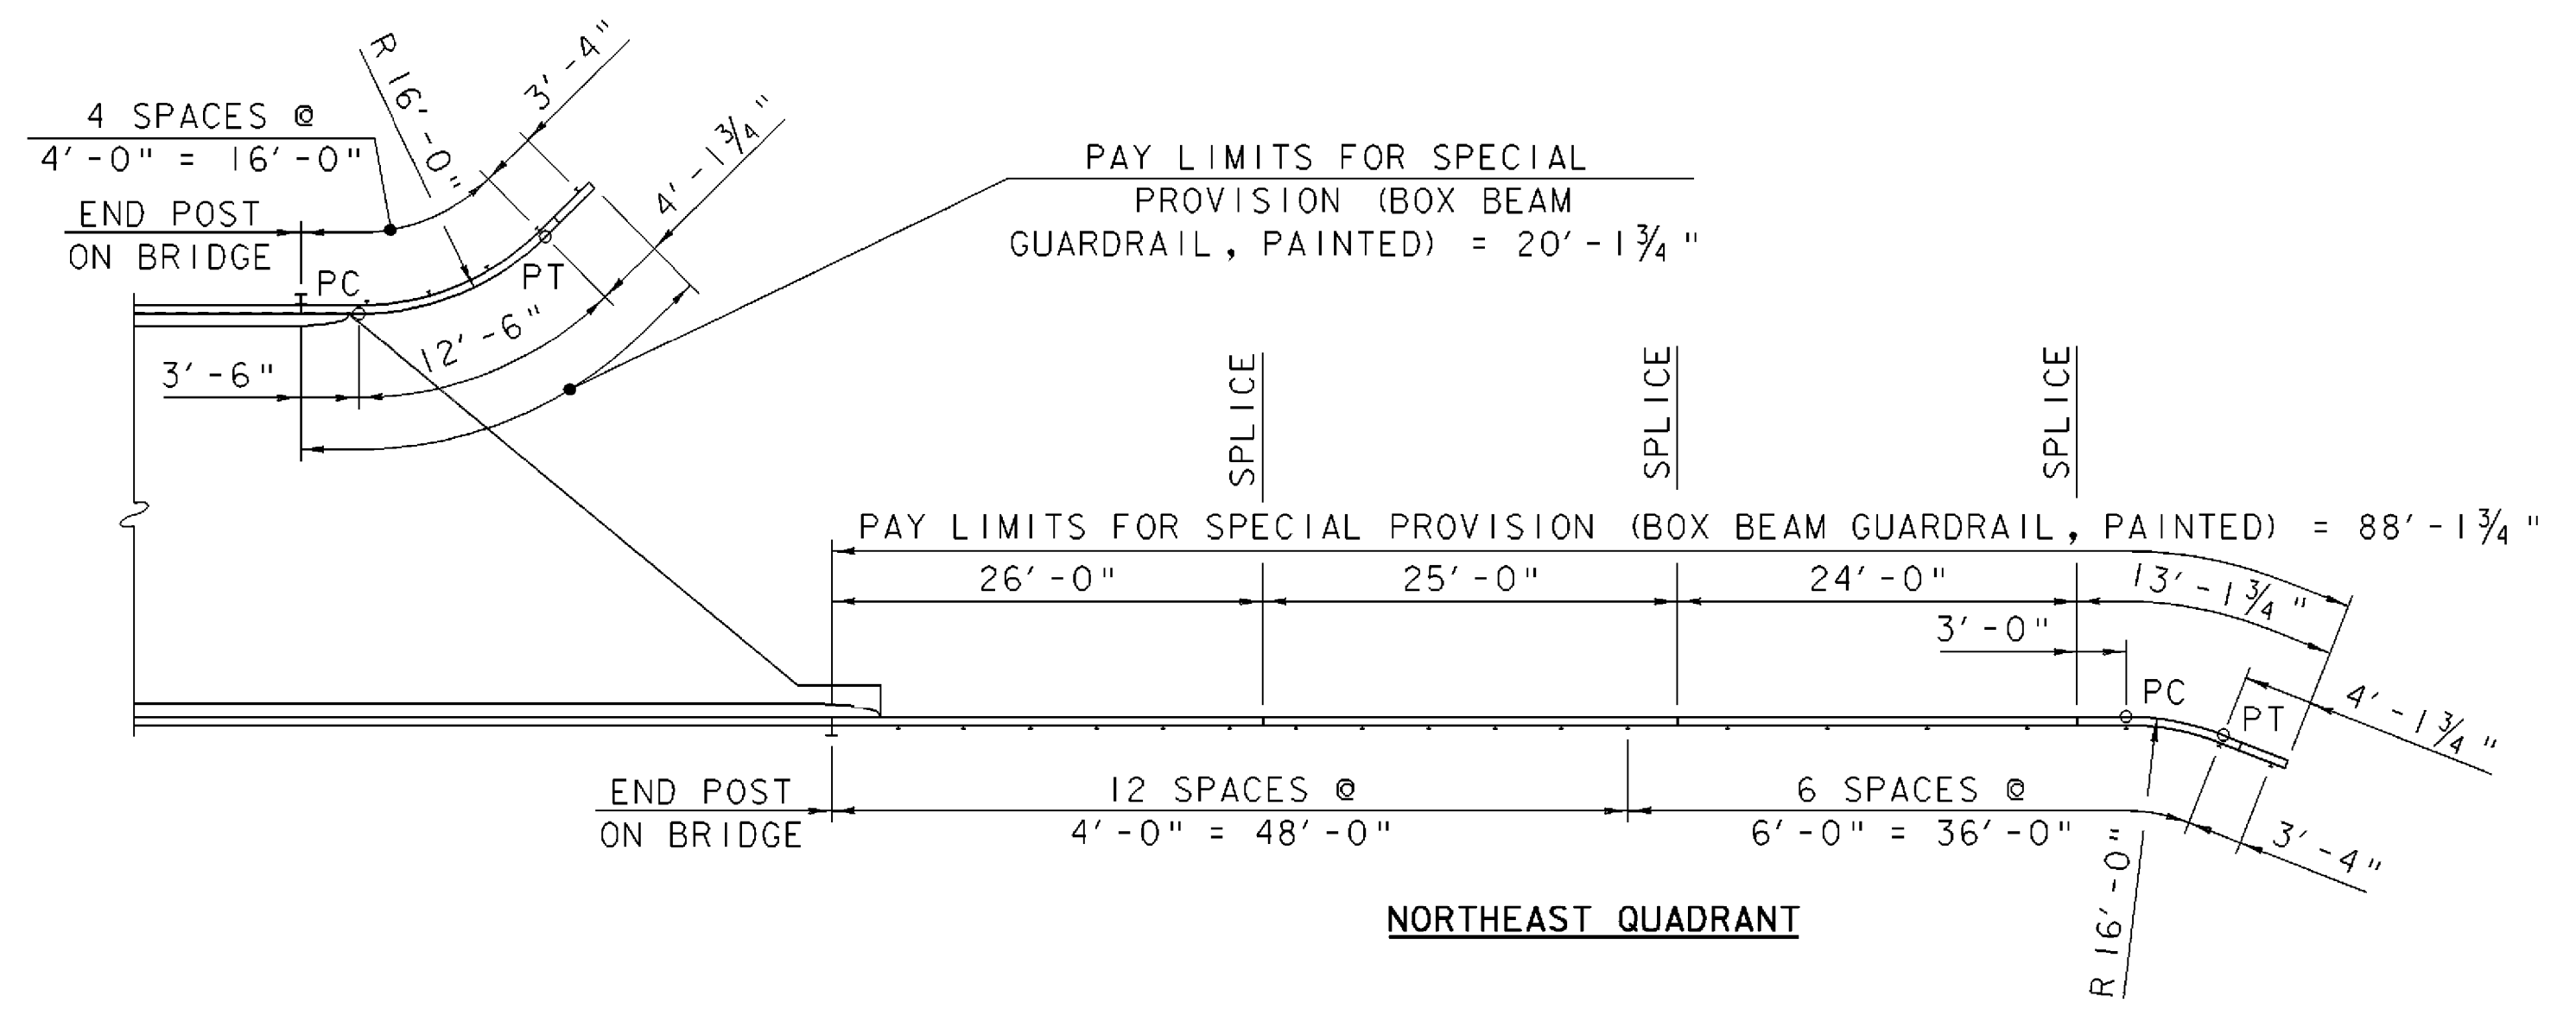

NORTHEAST QUADRANT

BOX BEAM RAIL, POSTS AND ALL APPURTENANCES SHALL BE PAINTED IN ACCORDANCE WITH SUBSECTION 513.06 (f), NEW GALVANIZED SURFACES. THE COLOR SHALL MATCH THE ~~GREEN~~ FINISH COAT USED FOR THE TRUSS. PAYMENT FOR THIS WORK SHALL BE INCLUDED IN THE PRICE BID FOR ITEM 900.640, SPECIAL PROVISION (BOX BEAM GUARD RAIL, PAINTED). **BLACK**

SPECIAL PROVISION (BOX BEAM GUARDRAIL, PAINTED) LAYOUT

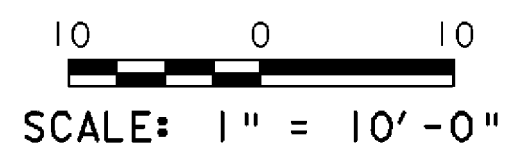

SPECIAL PROVISION (BOX BEAM GUARDRAIL, PAINTED) LAYOUT

PROJECT NAME: SPRINGFIELD	PLOT DATE: 27-DEC-2007
PROJECT NUMBER: BHO 1442(30)	DRAWN BY: G. ROY
FILE NAME: 96J348/str/s96J348rall.dgn	CHECKED BY: C. CARLSON
PROJECT LEADER: R. WHITCOMB	SHEET 37 OF 85
DESIGNED BY: C. CARLSON	