


ABUTMENT NO. 1 PLAN

1 0 1 2 3 4 5 6
SCALE: 1/4" = 1'-0"

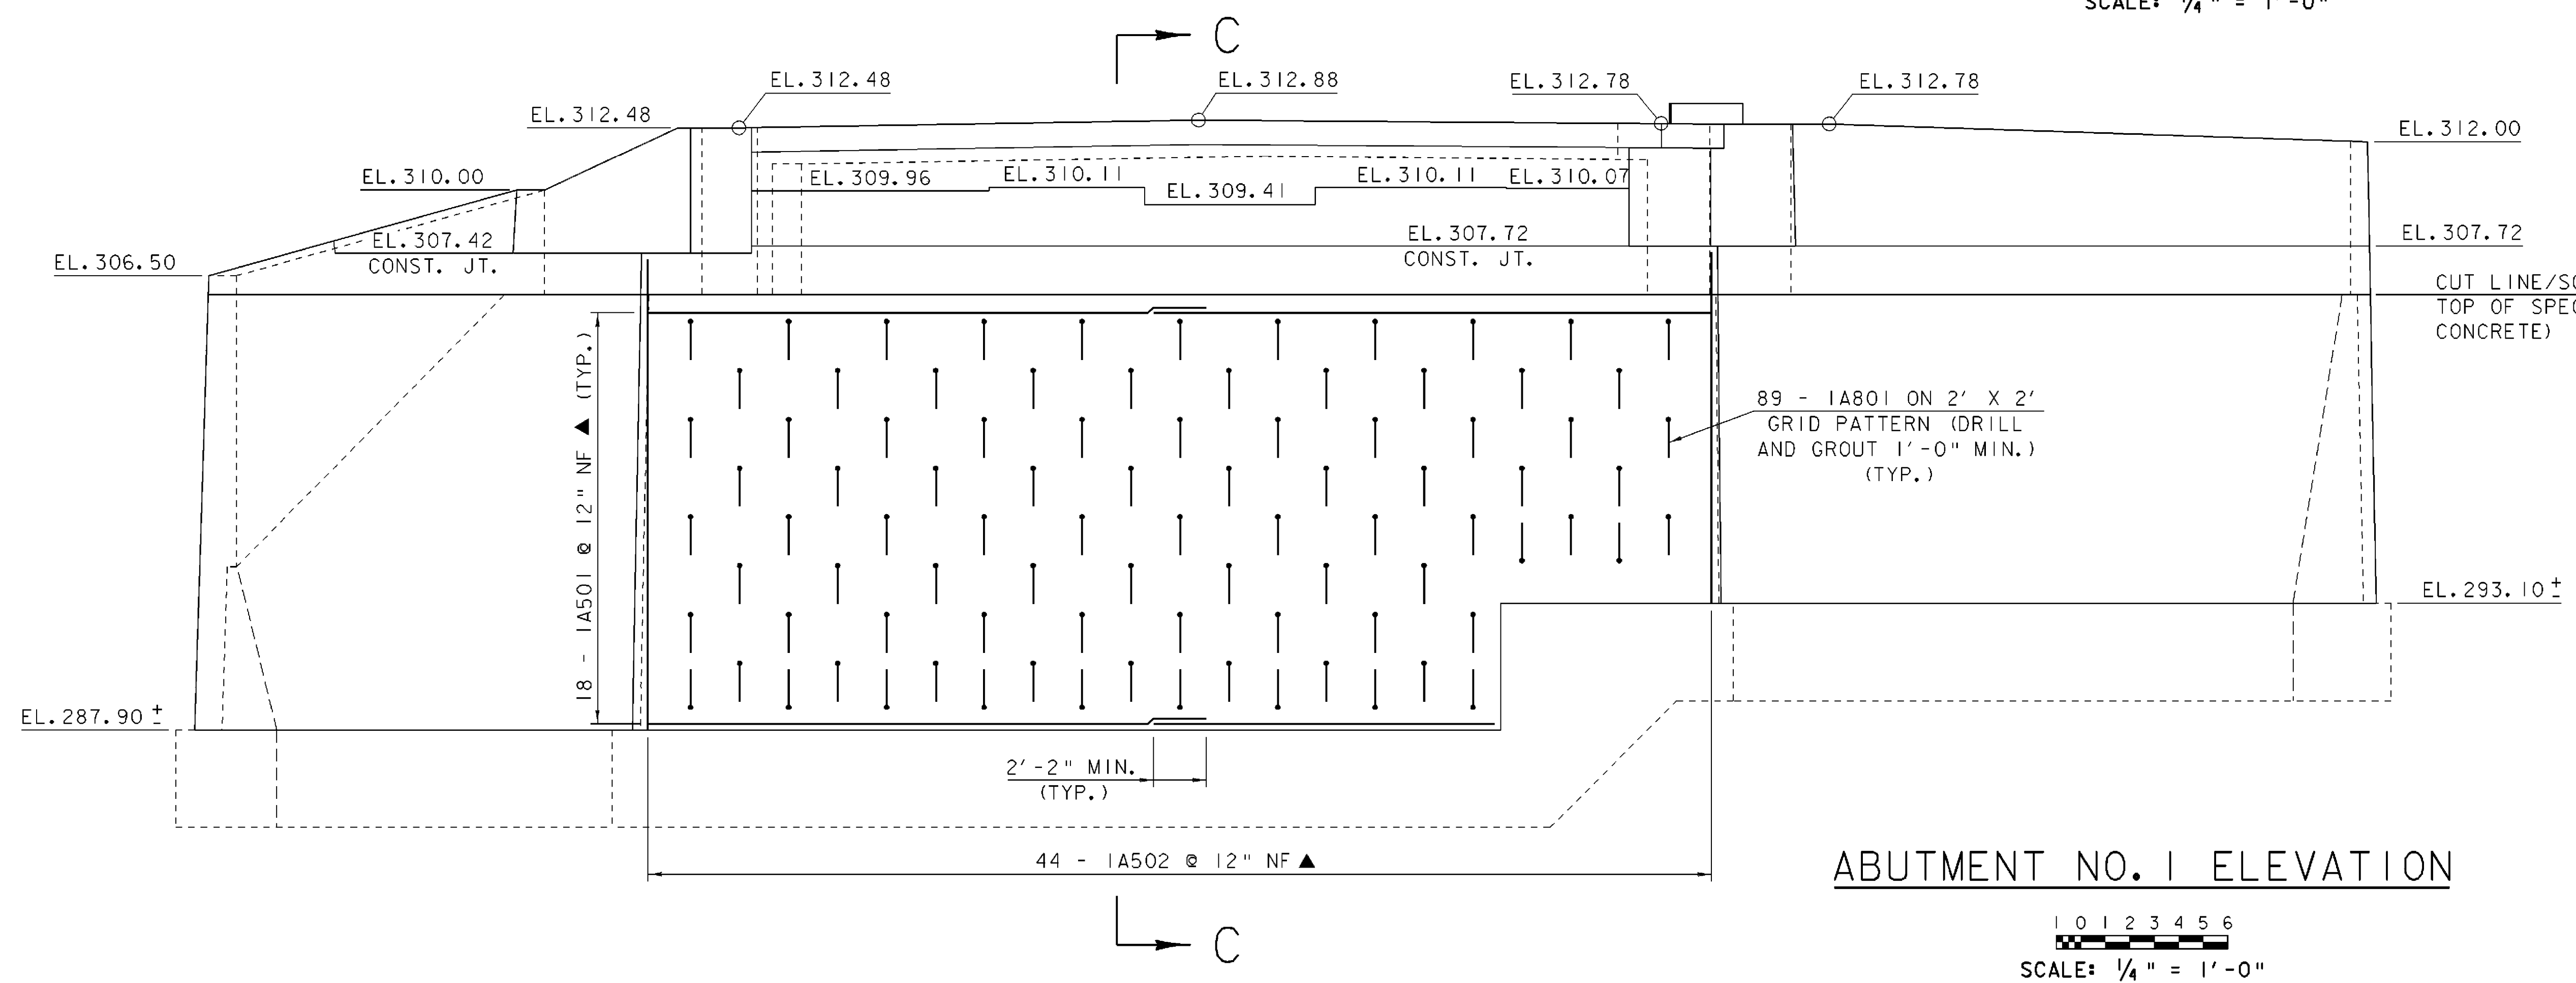

ABUTMENT NO. 1 ELEVATION

1 0 1 2 3 4 5 6
SCALE: 1/4" = 1'-0"

NOTE:
 NF = NEAR FACE
 FF = FAR FACE
 EF = EACH FACE
 ▲ = CUT TO FIT IN FIELD
 3" CLR. UNLESS OTHERWISE NOTED
 2'-2" BAR LAP UNLESS OTHERWISE NOTED

ABUTMENT NO. 1 DETAILS

PROJECT NAME:	SPRINGFIELD	PLOT DATE:	27-DEC-2007
PROJECT NUMBER:	BHO 1442(30)	DRAWN BY:	G. ROY
FILE NAME:	96j348/str/s96j348ab.dgn	CHECKED BY:	C. CARLSON
PROJECT MANAGER:	R. R. WHITCOMB	SHEET	40 OF 85
DESIGNED BY:	C. CARLSON		