

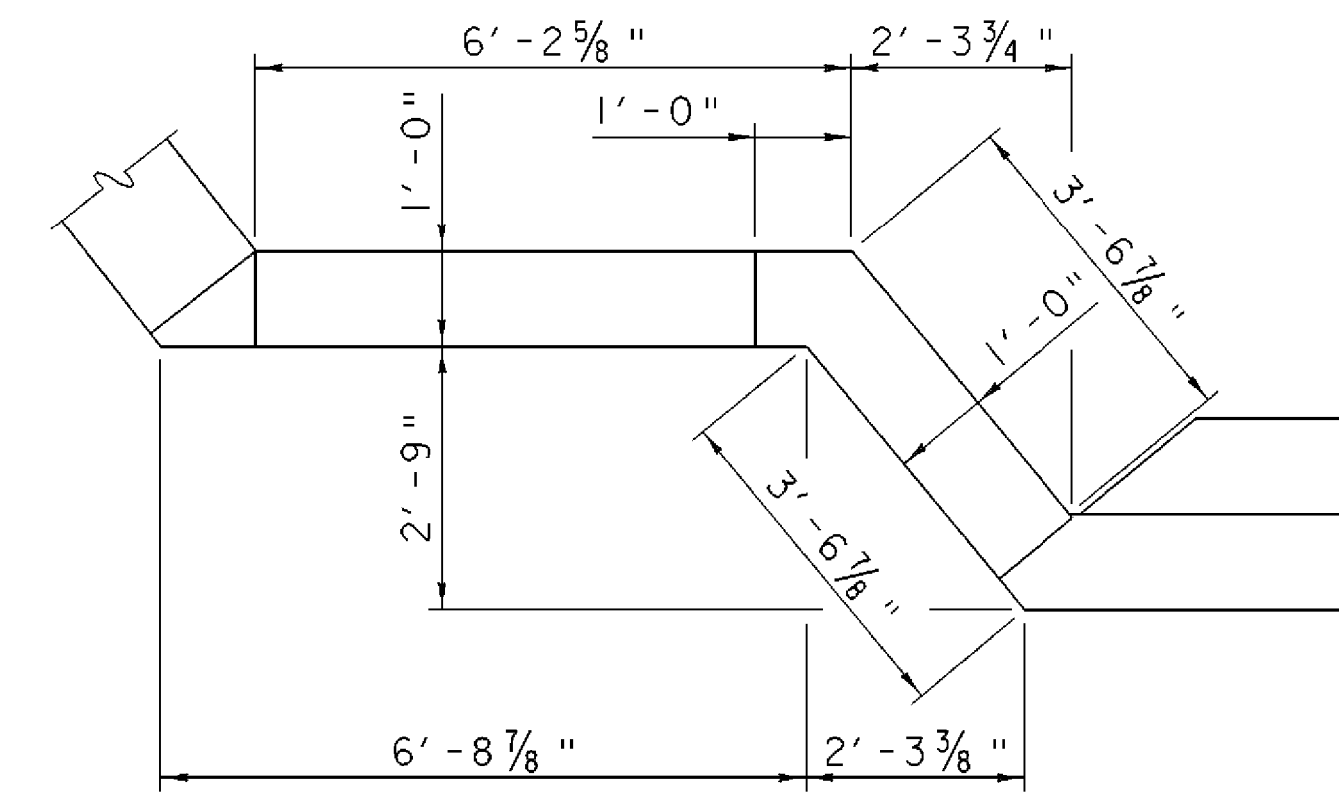
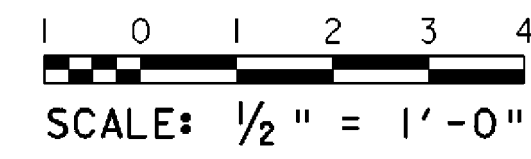




BACKWALL DETAIL @ WINGWALL NO. 2

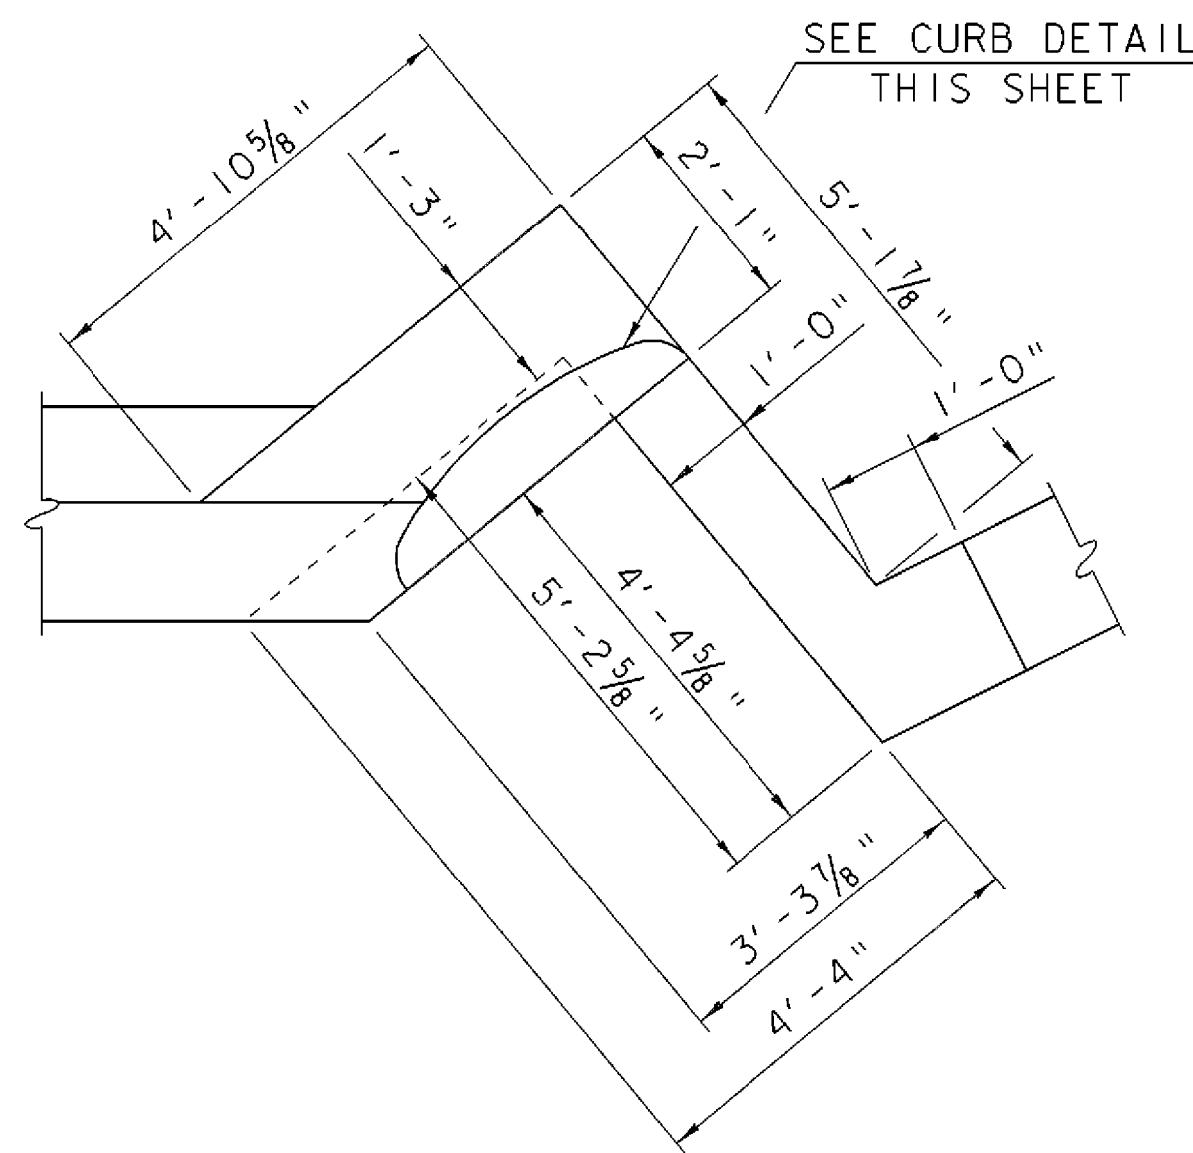



BACKWALL DETAIL @ WINGWALL NO. 3

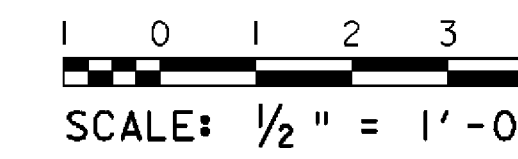

BACKWALL DETAIL @ WINGWALL NO. 1

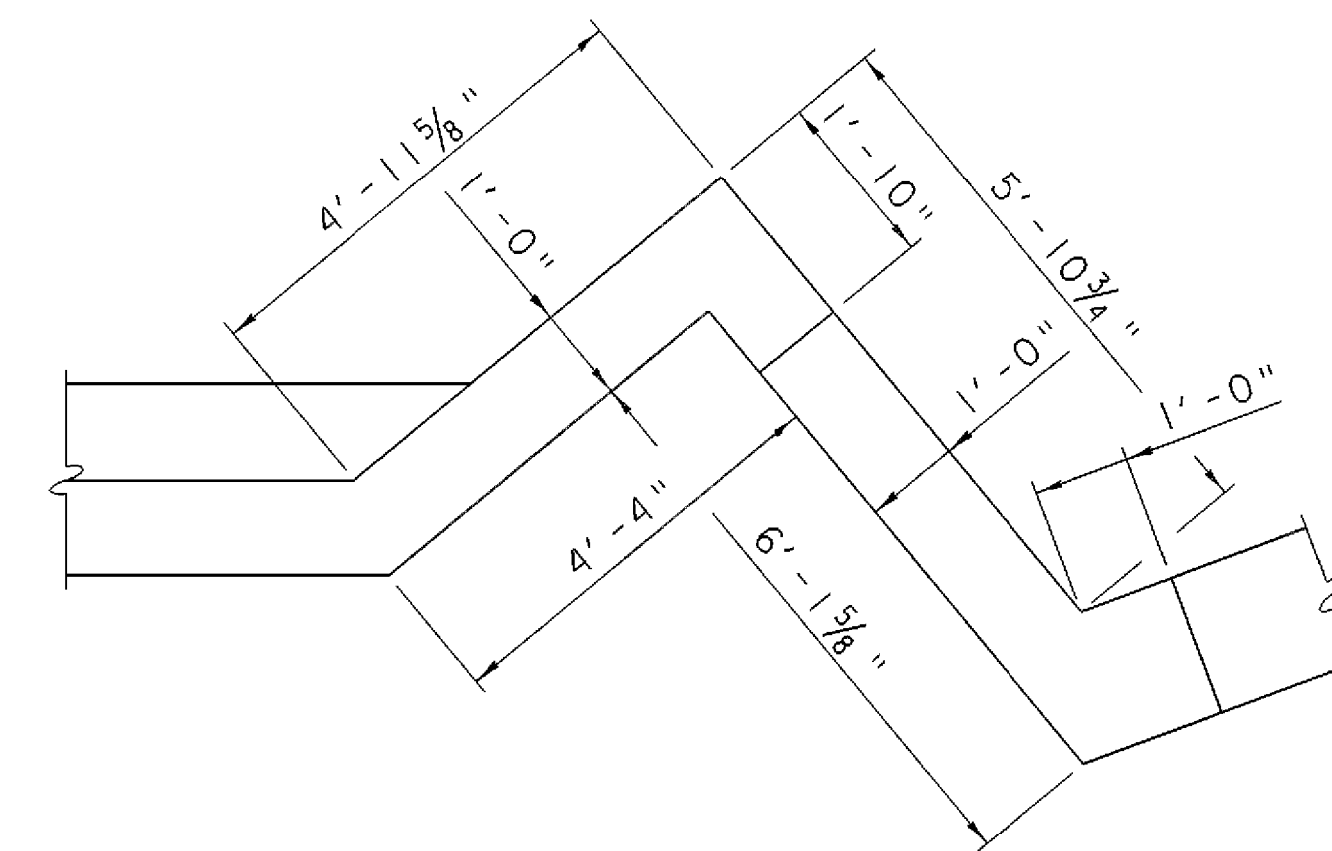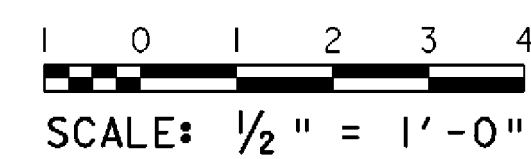

BACKWALL DETAIL @ WINGWALL NO. 4

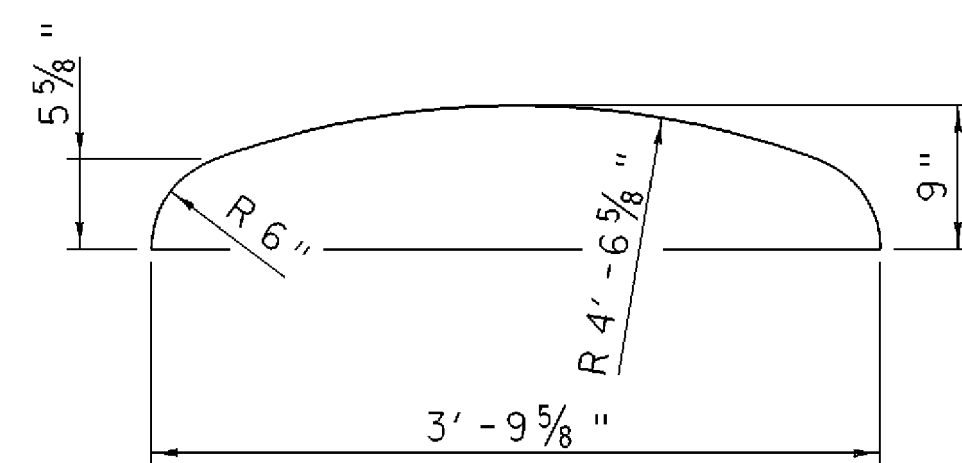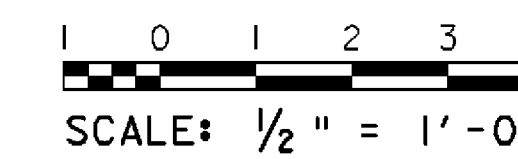

CURB DETAIL



ABUTMENT BACKWALL DETAILS

PROJECT NAME:	SPRINGFIELD	PLOT DATE:	27-DEC-2007
PROJECT NUMBER:	BHO 1442(30)	DRAWN BY:	G. ROY
FILE NAME:	96J348/str/s96J348ab.dgn	CHECKED BY:	C. CARLSON
PROJECT MANAGER:	R. R. WHITCOMB	SHEET	45 OF 85
DESIGNED BY:	C. CARLSON		
s96J348bw.1			