





WINGWALL NO. 2 ELEVATION

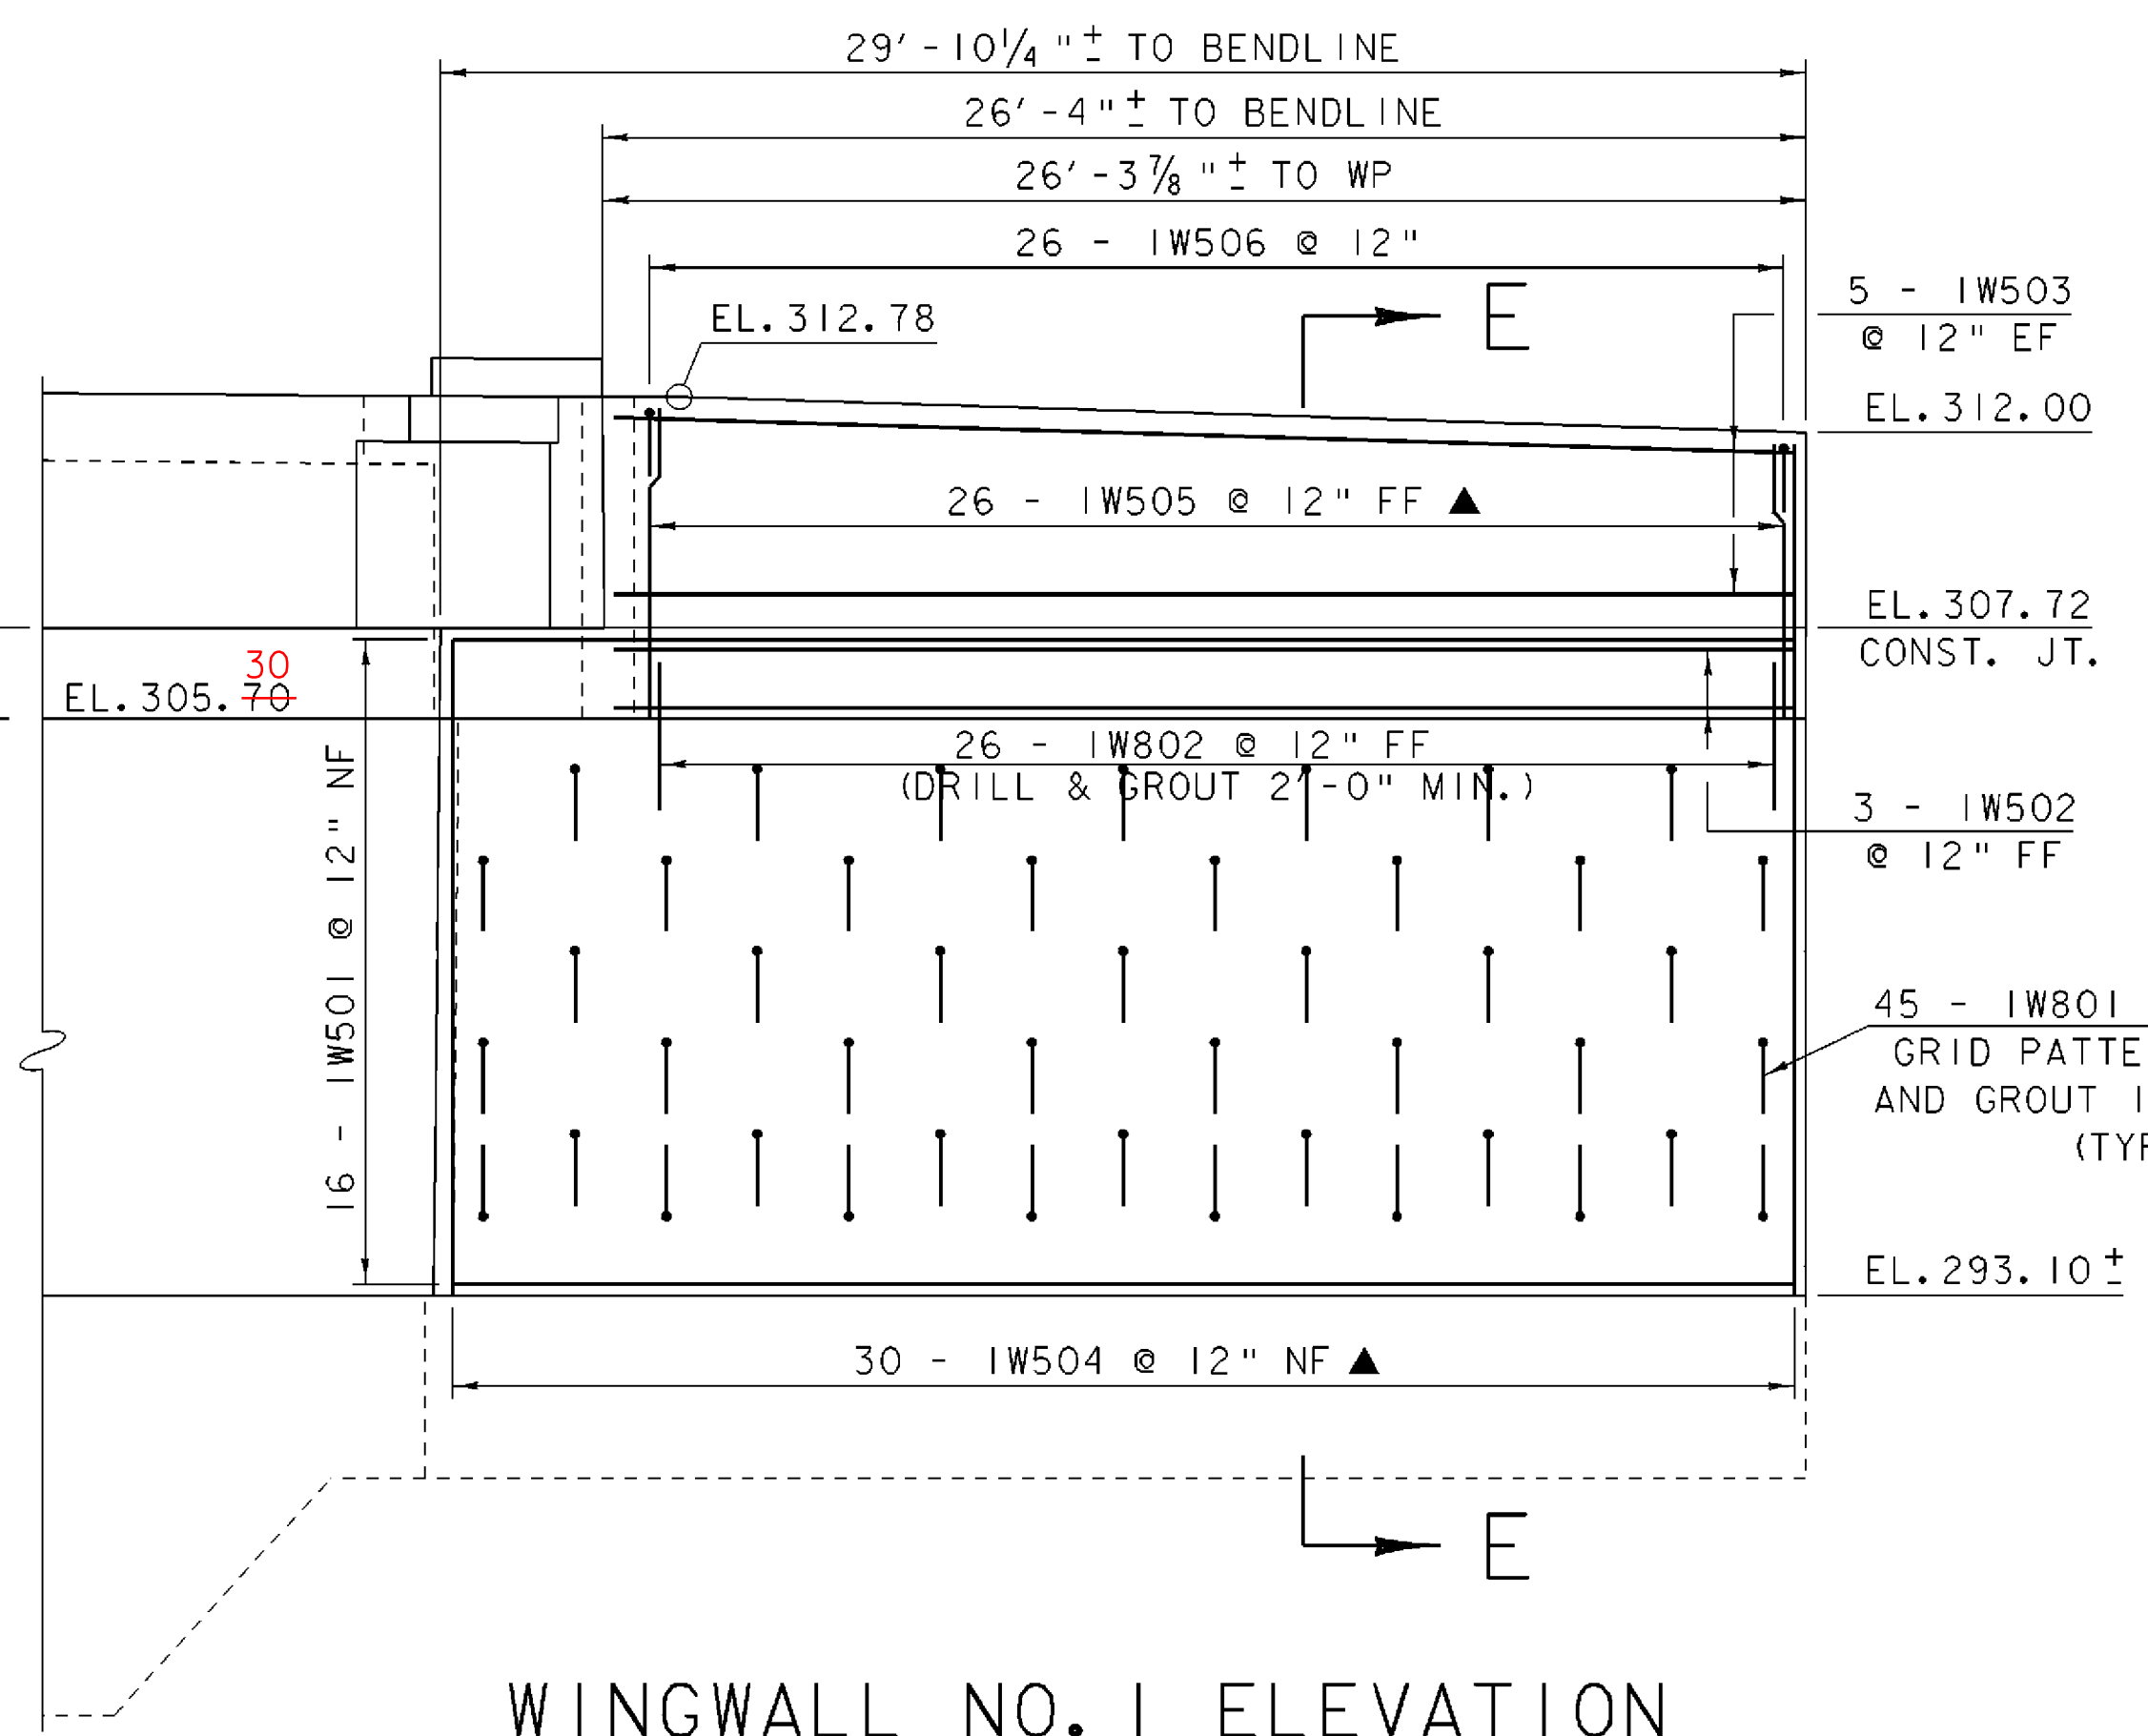


WINGWALL NO. 1 ELEVATION

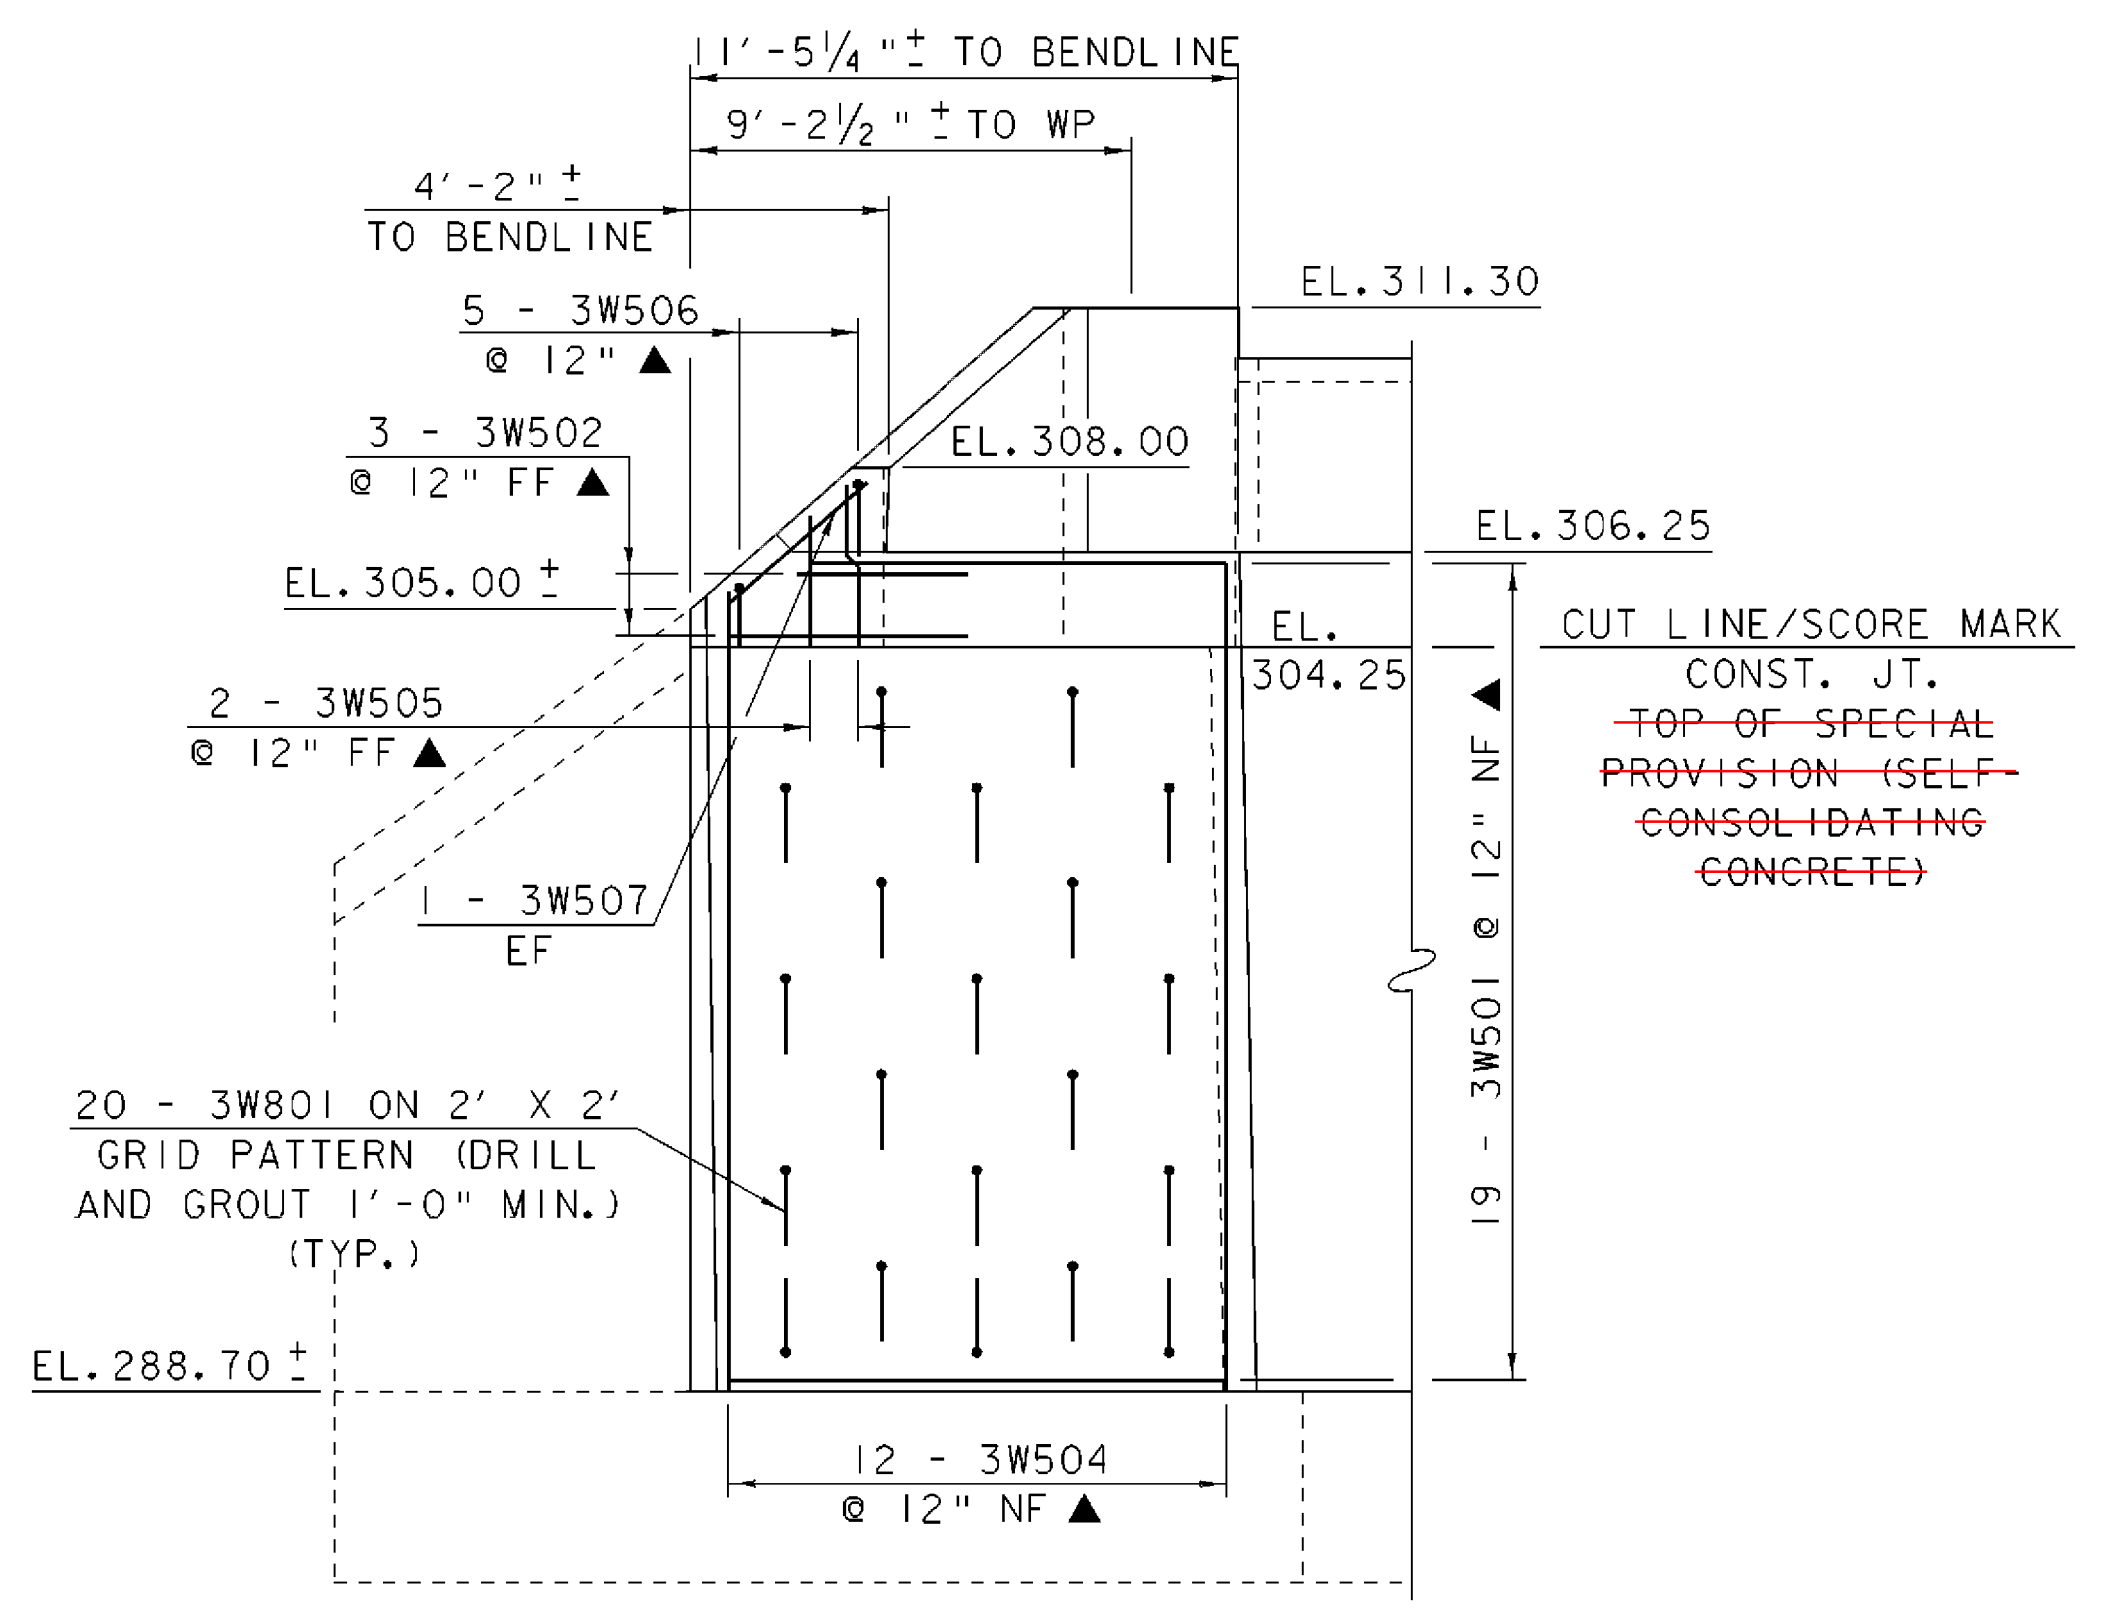

WINGWALL NO. 3 ELEVATION

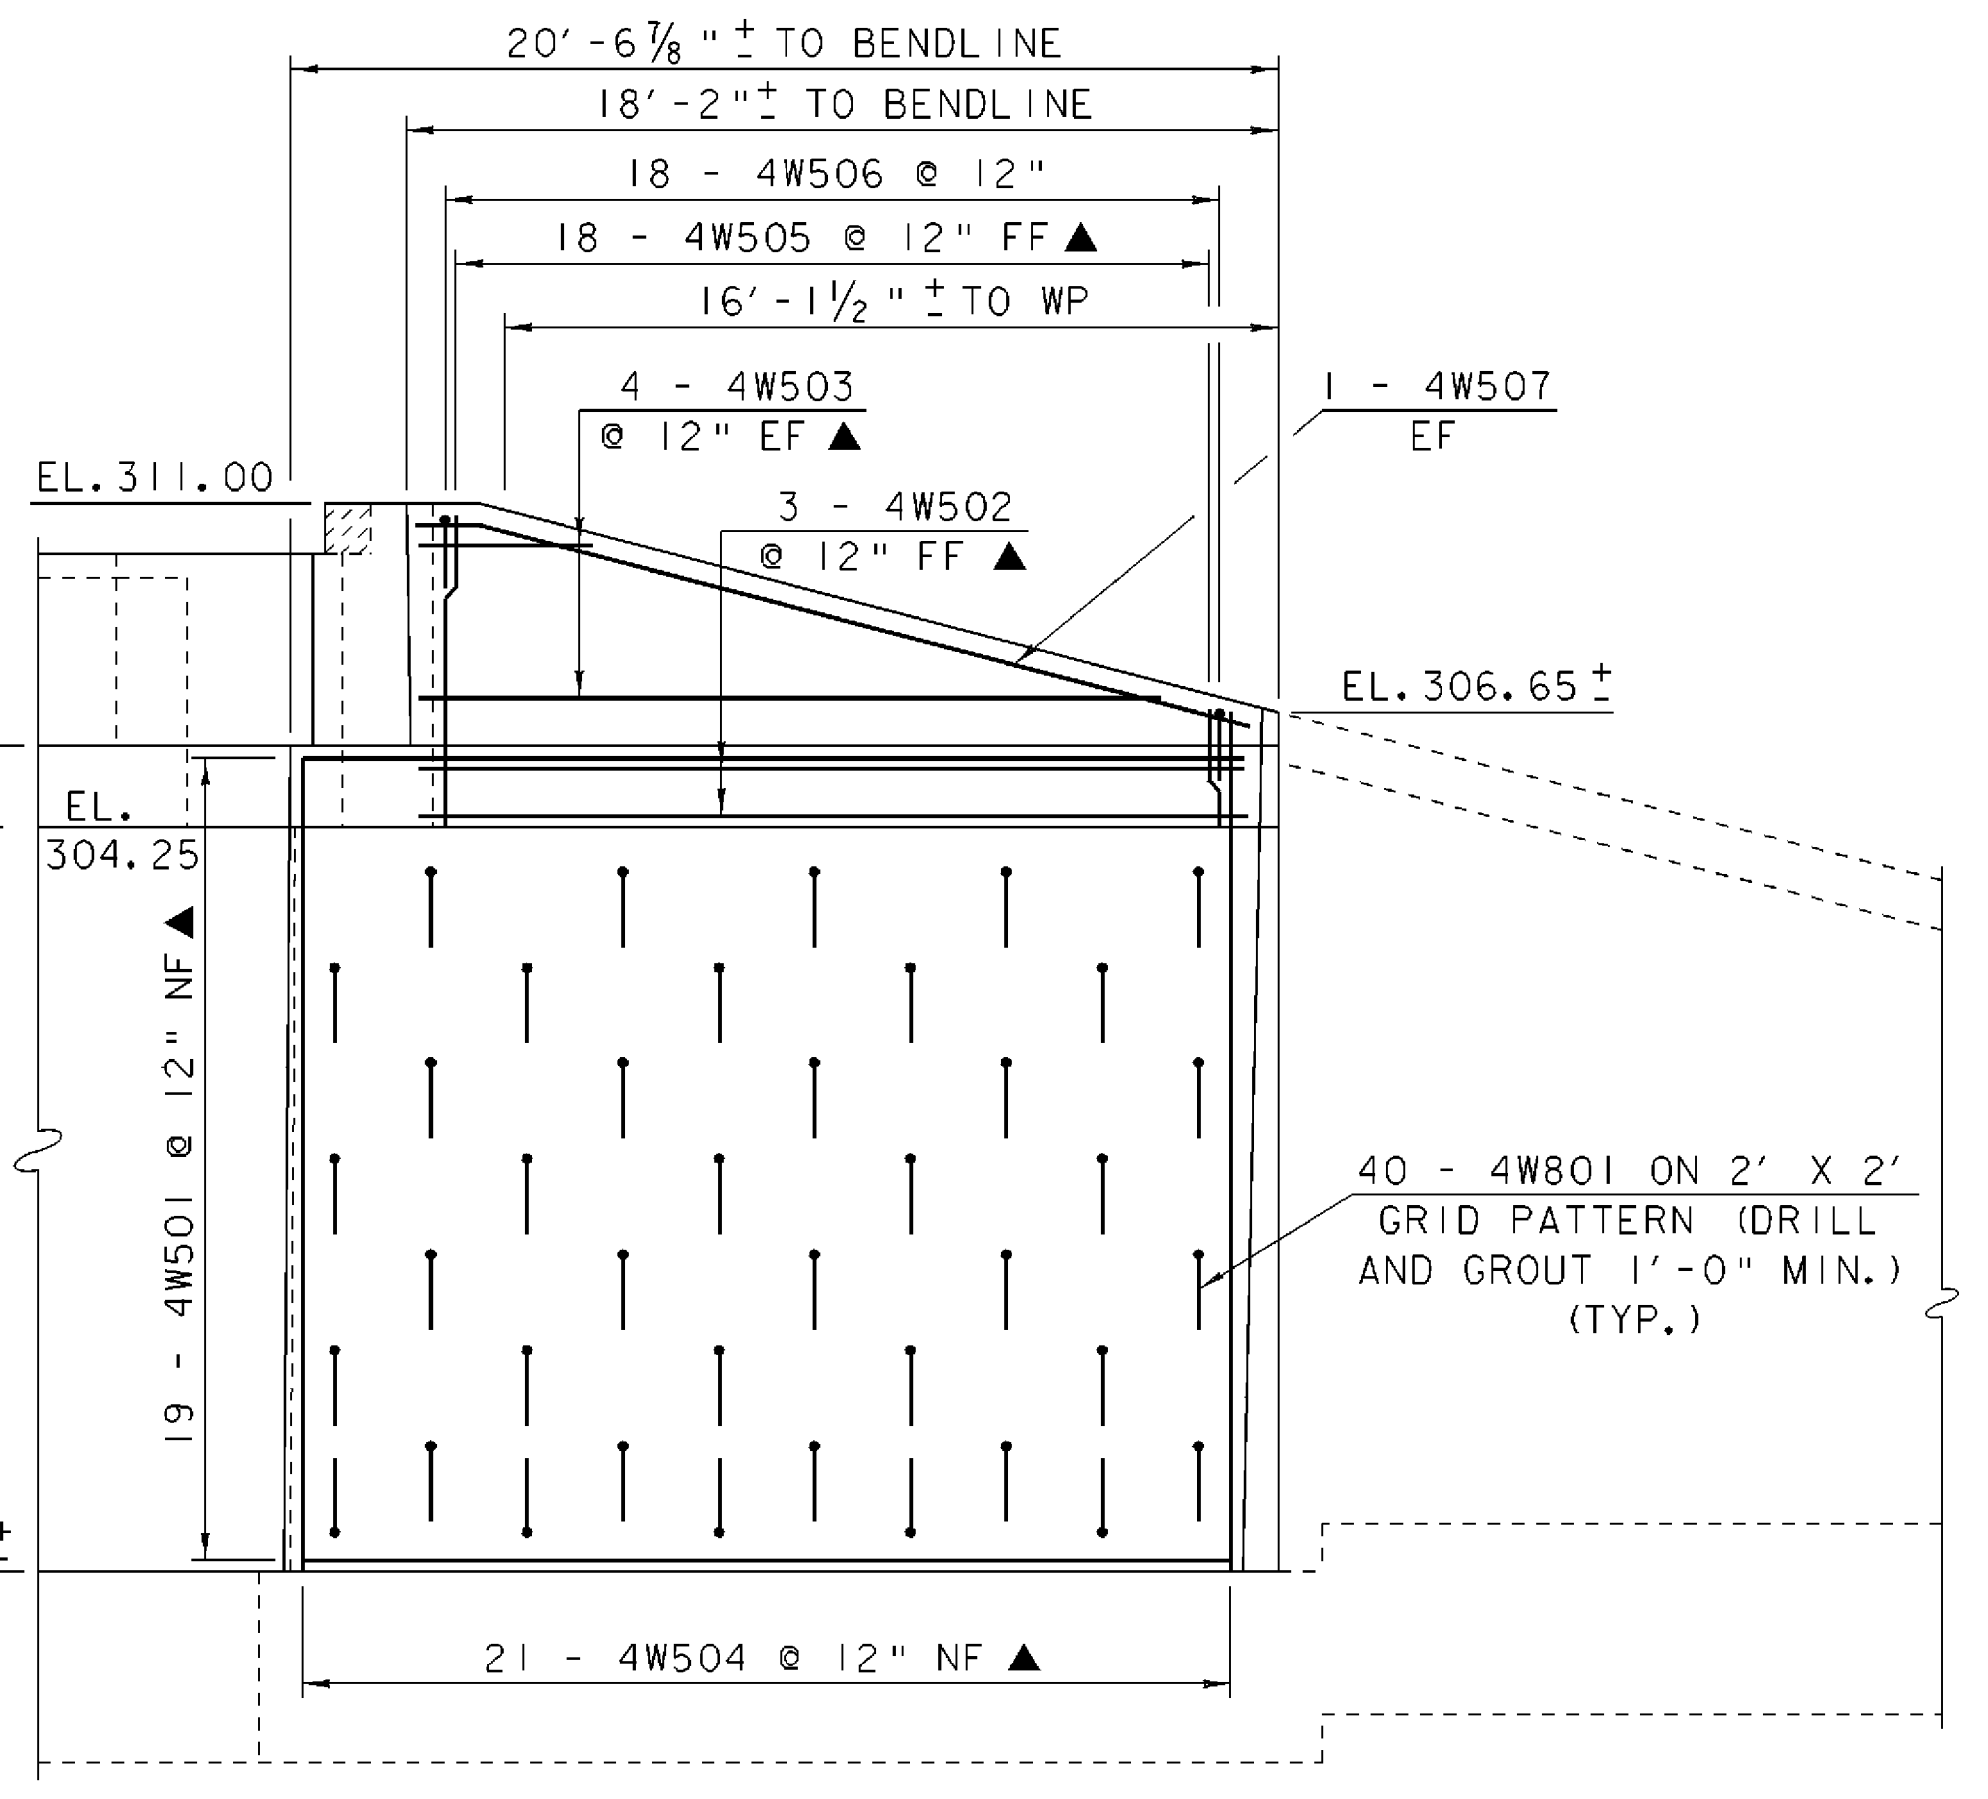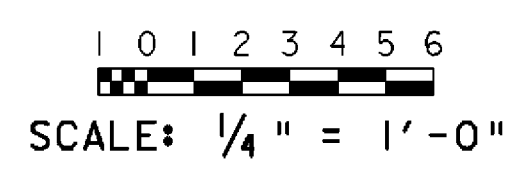

WINGWALL NO. 4 ELEVATION

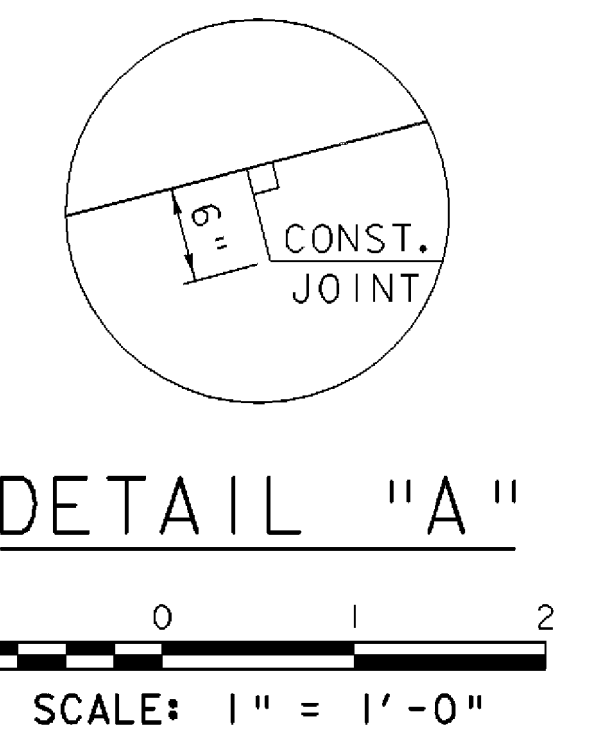

NOTE:  
 NF = NEAR FACE  
 FF = FAR FACE  
 EF = EACH FACE  
 ▲ = CUT TO FIT IN FIELD  
 3" CLR. UNLESS OTHERWISE NOTED  
 2'-2" BAR LAP UNLESS OTHERWISE NOTED

WINGWALL ELEVATIONS

PROJECT NAME:	SPRINGFIELD	PLOT DATE:	27-DEC-2007
PROJECT NUMBER:	BHO 1442(30)	DRAWN BY:	G. ROY
FILE NAME:	96J348/str/s96J348ab.dgn	CHECKED BY:	C. CARLSON
PROJECT MANAGER:	R.R. WHITCOMB	SHEET	46 OF 85
DESIGNED BY:	C. CARLSON		