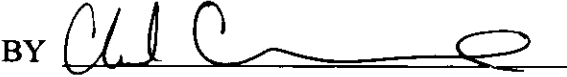


RECORD PLANS

CONTRACTOR	RENAUD BROTHERS, INC - VERNON, VT
RESIDENT ENGINEER	CHAD GREENWOOD
CONSTRUCTION BEGAN	JANUARY 26, 2010
CONSTRUCTION COMPLETE	AUGUST 28, 2010
RECORD PLANS BY	CHAD GREENWOOD & M BIRCHARD

I HEREBY CERTIFY THAT ALL THE CONSTRUCTION REQUIRED BY THIS SET OF DRAWINGS HAS BEEN ACCOMPLISHED AS INDICATED HEREIN


BY  RESIDENT ENGINEER

DATE MARCH 17, 2011

NOTE Any further information concerning final quantities, amounts or other details relative to this project may be found at Central Files in the electronic archives




PROPOSED IMPROVEMENT BRIDGE PROJECT TOWN OF JAMAICA COUNTY OF WINDHAM

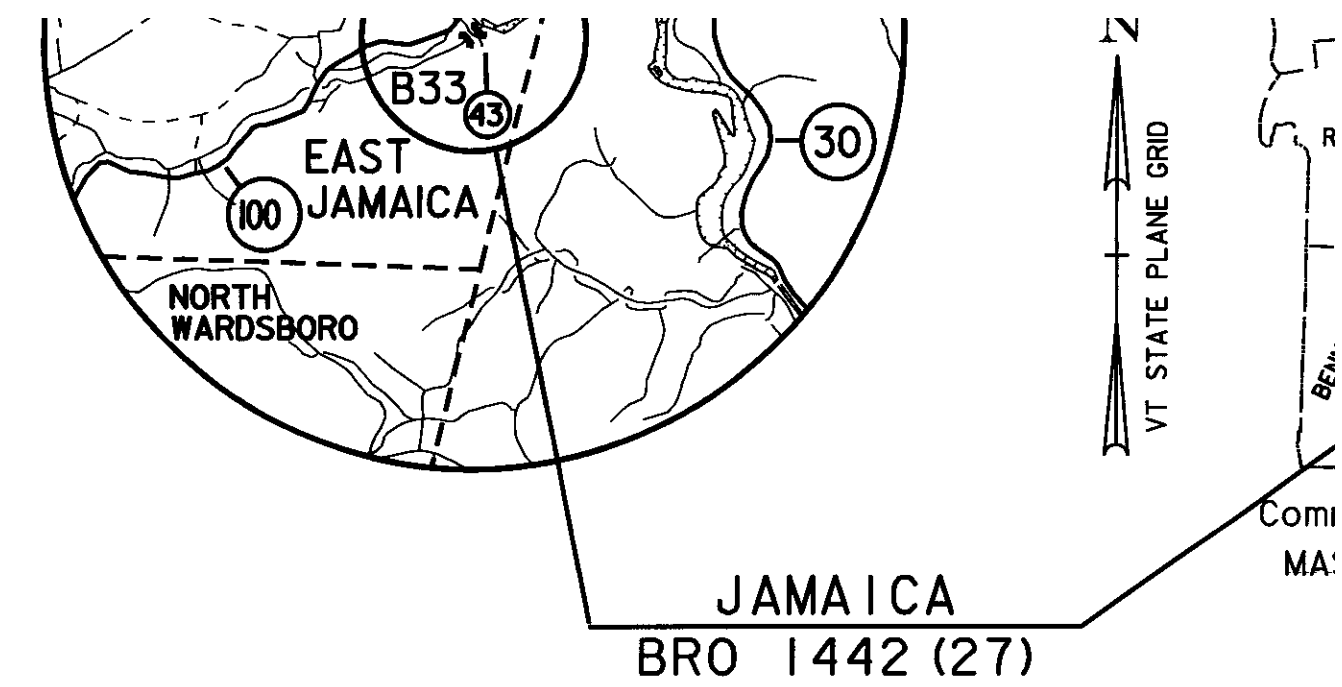

ROUTE NO : TH 43 CLASS III, LOCAL ROAD BRIDGE NO : 33

PROJECT LOCATION : BRIDGE #33 IS LOCATED ON TOWN HIGHWAY 43 APPROXIMATELY 0.10 MILES SOUTH OF THE INTERSECTION WITH VT ROUTE 100.
PROJECT DESCRIPTION : REPLACEMENT OF EXISTING THRU TRUSS BRIDGE WITH A NEW INTEGRAL ABUTMENT STEEL GIRDER BRIDGE AND NECESSARY CHANNEL AND APPROACH WORK, AND REMOVAL OF EXISTING TEMPORARY BRIDGE AND APPROACHES.

LENGTH OF STRUCTURE : 108 FEET.
LENGTH OF ROADWAY : 167 FEET.
LENGTH OF PROJECT : 275 FEET.

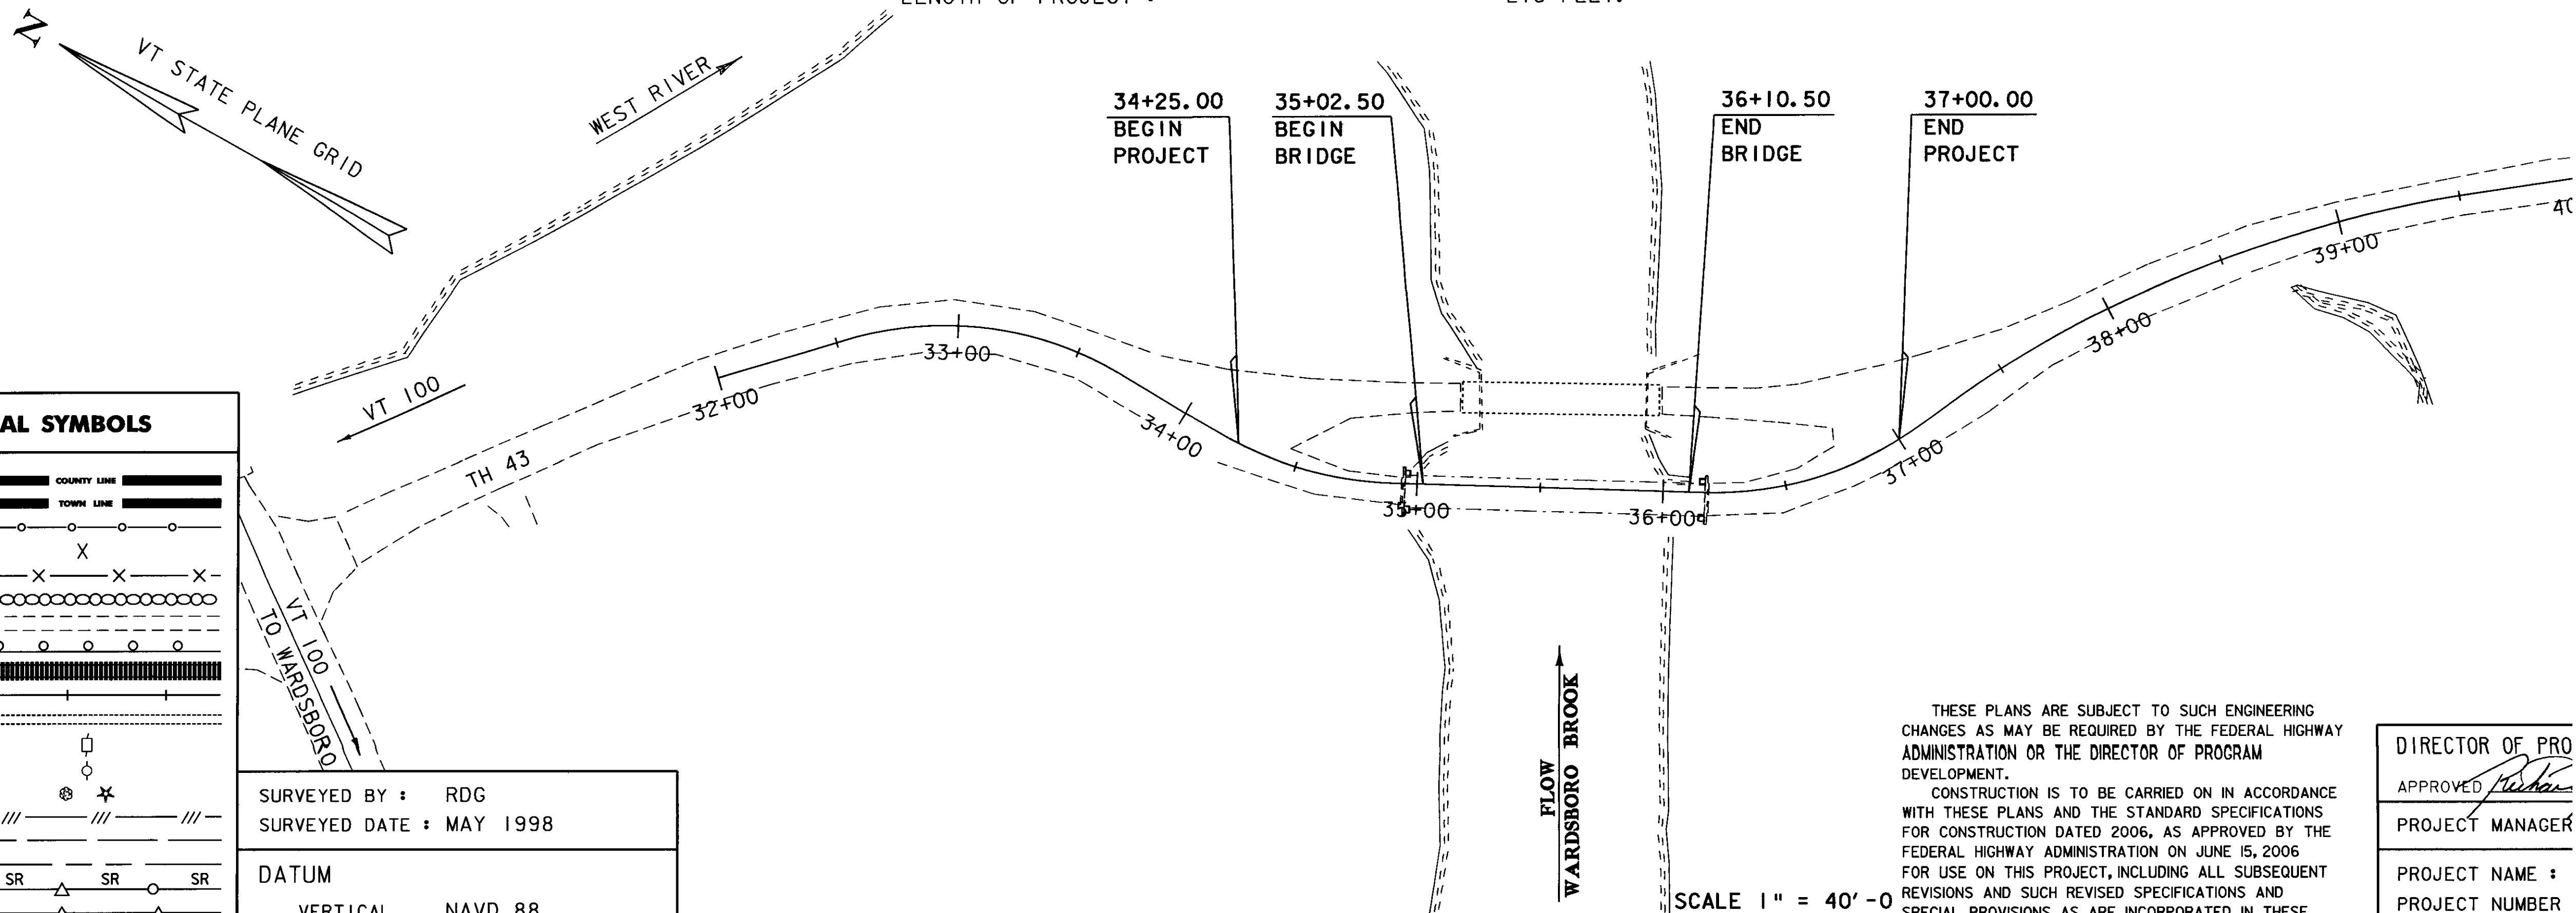

CONVENTIONAL SYMBOLS	
COUNTY LINE	
TOWN LINE	
LIMITS OF ACCESS	
POINT OF ACCESS	
FENCE LINE	
STONE WALL	
TRAVELED WAY	
GUARD RAIL	
RAILROAD	
SURVEY LINE	
CULVERT	
POWER POLE	
TELEPHONE POLE	
TREES	
CONTROL OF ACCESS	
PROPERTY LINE	
R.O.W. TAKING LINE	
SLOPE RIGHTS	
TOP OF CUT	
TOE OF SLOPE	


SURVEYED BY : RDG
SURVEYED DATE : MAY 1998

DATUM
VERTICAL NAVD 88
HORIZONTAL NAD 83 (92)

THESE PLANS ARE SUBJECT TO SUCH ENGINEERING CHANGES AS MAY BE REQUIRED BY THE FEDERAL HIGHWAY ADMINISTRATION OR THE DIRECTOR OF PROGRAM DEVELOPMENT.
CONSTRUCTION IS TO BE CARRIED ON IN ACCORDANCE WITH THESE PLANS AND THE STANDARD SPECIFICATIONS FOR CONSTRUCTION DATED 2006, AS APPROVED BY THE FEDERAL HIGHWAY ADMINISTRATION ON JUNE 15, 2006 FOR USE ON THIS PROJECT, INCLUDING ALL SUBSEQUENT REVISIONS AND SUCH REVISED SPECIFICATIONS AND SPECIAL PROVISIONS AS ARE INCORPORATED IN THESE PLANS.

SCALE 1" = 40'-0"
40 0 40

s96j068111e.1 PLOTTED 16-OCT-2009

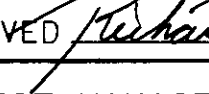DIRECTOR OF PRO
APPROVED 
PROJECT MANAGER

PROJECT NAME :
PROJECT NUMBER
SHEET 1 OF