


PLAN

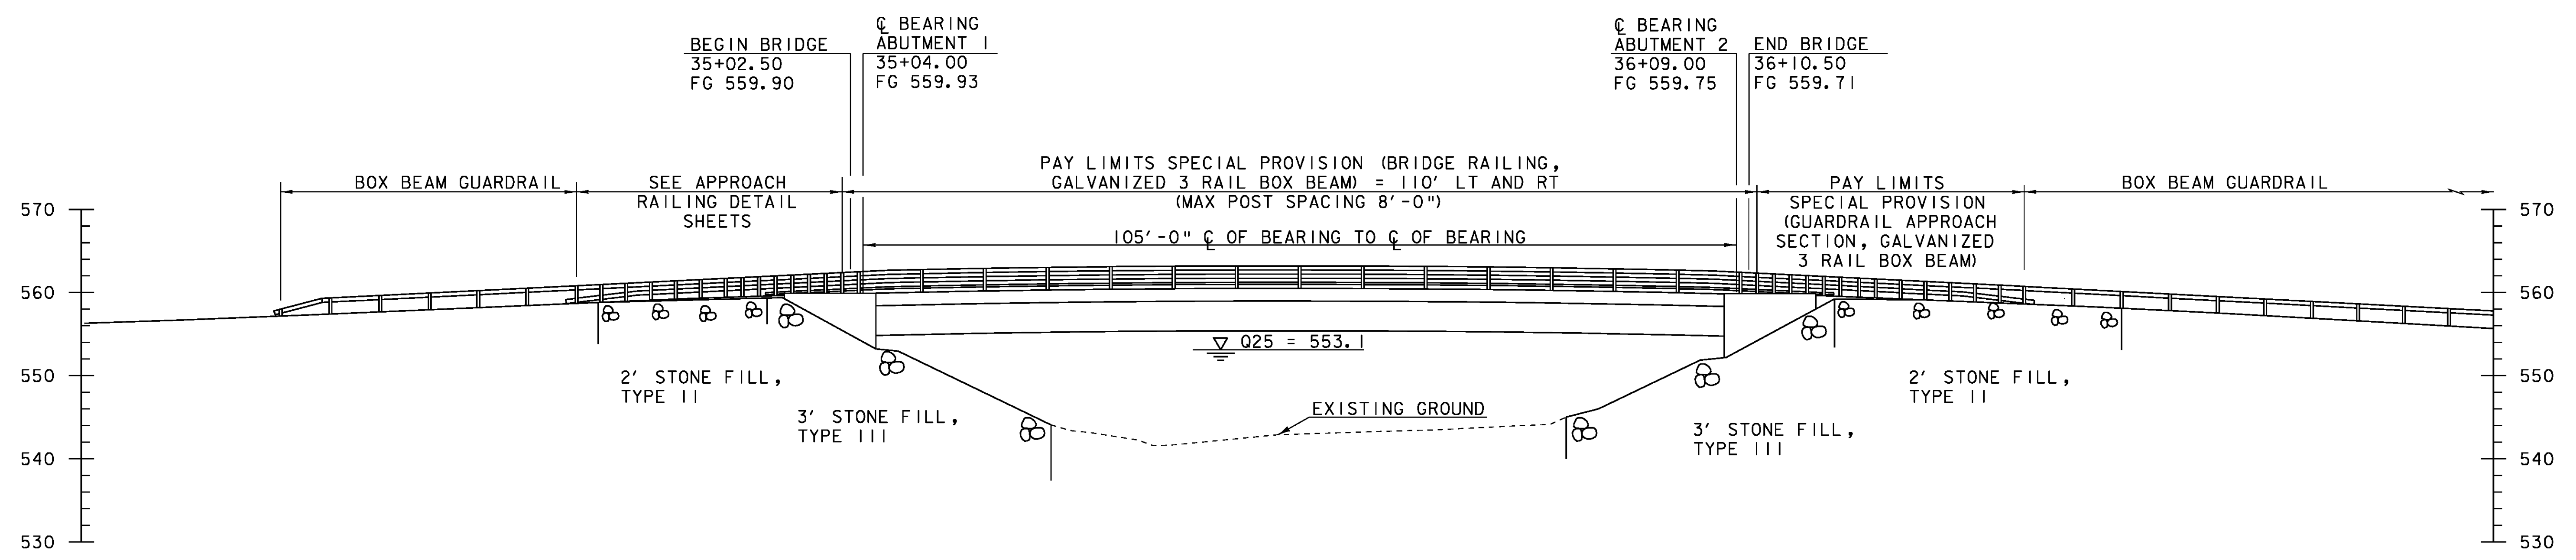

ELEVATION AT UPSTREAM FASCIA

PROJECT NAME: JAMAICA	
PROJECT NUMBER: BRO 1442(27)	
FILE NAME: s961068pe.dgn	PLOT DATE: 03-NOV-2009
PROJECT LEADER: K. HIGGINS	DRAWN BY: R. PELLETT
DESIGNED BY: J. LACROIX	CHECKED BY: J. LACROIX
PLAN AND ELEVATION	SHEET 16 OF 44

