




32+75

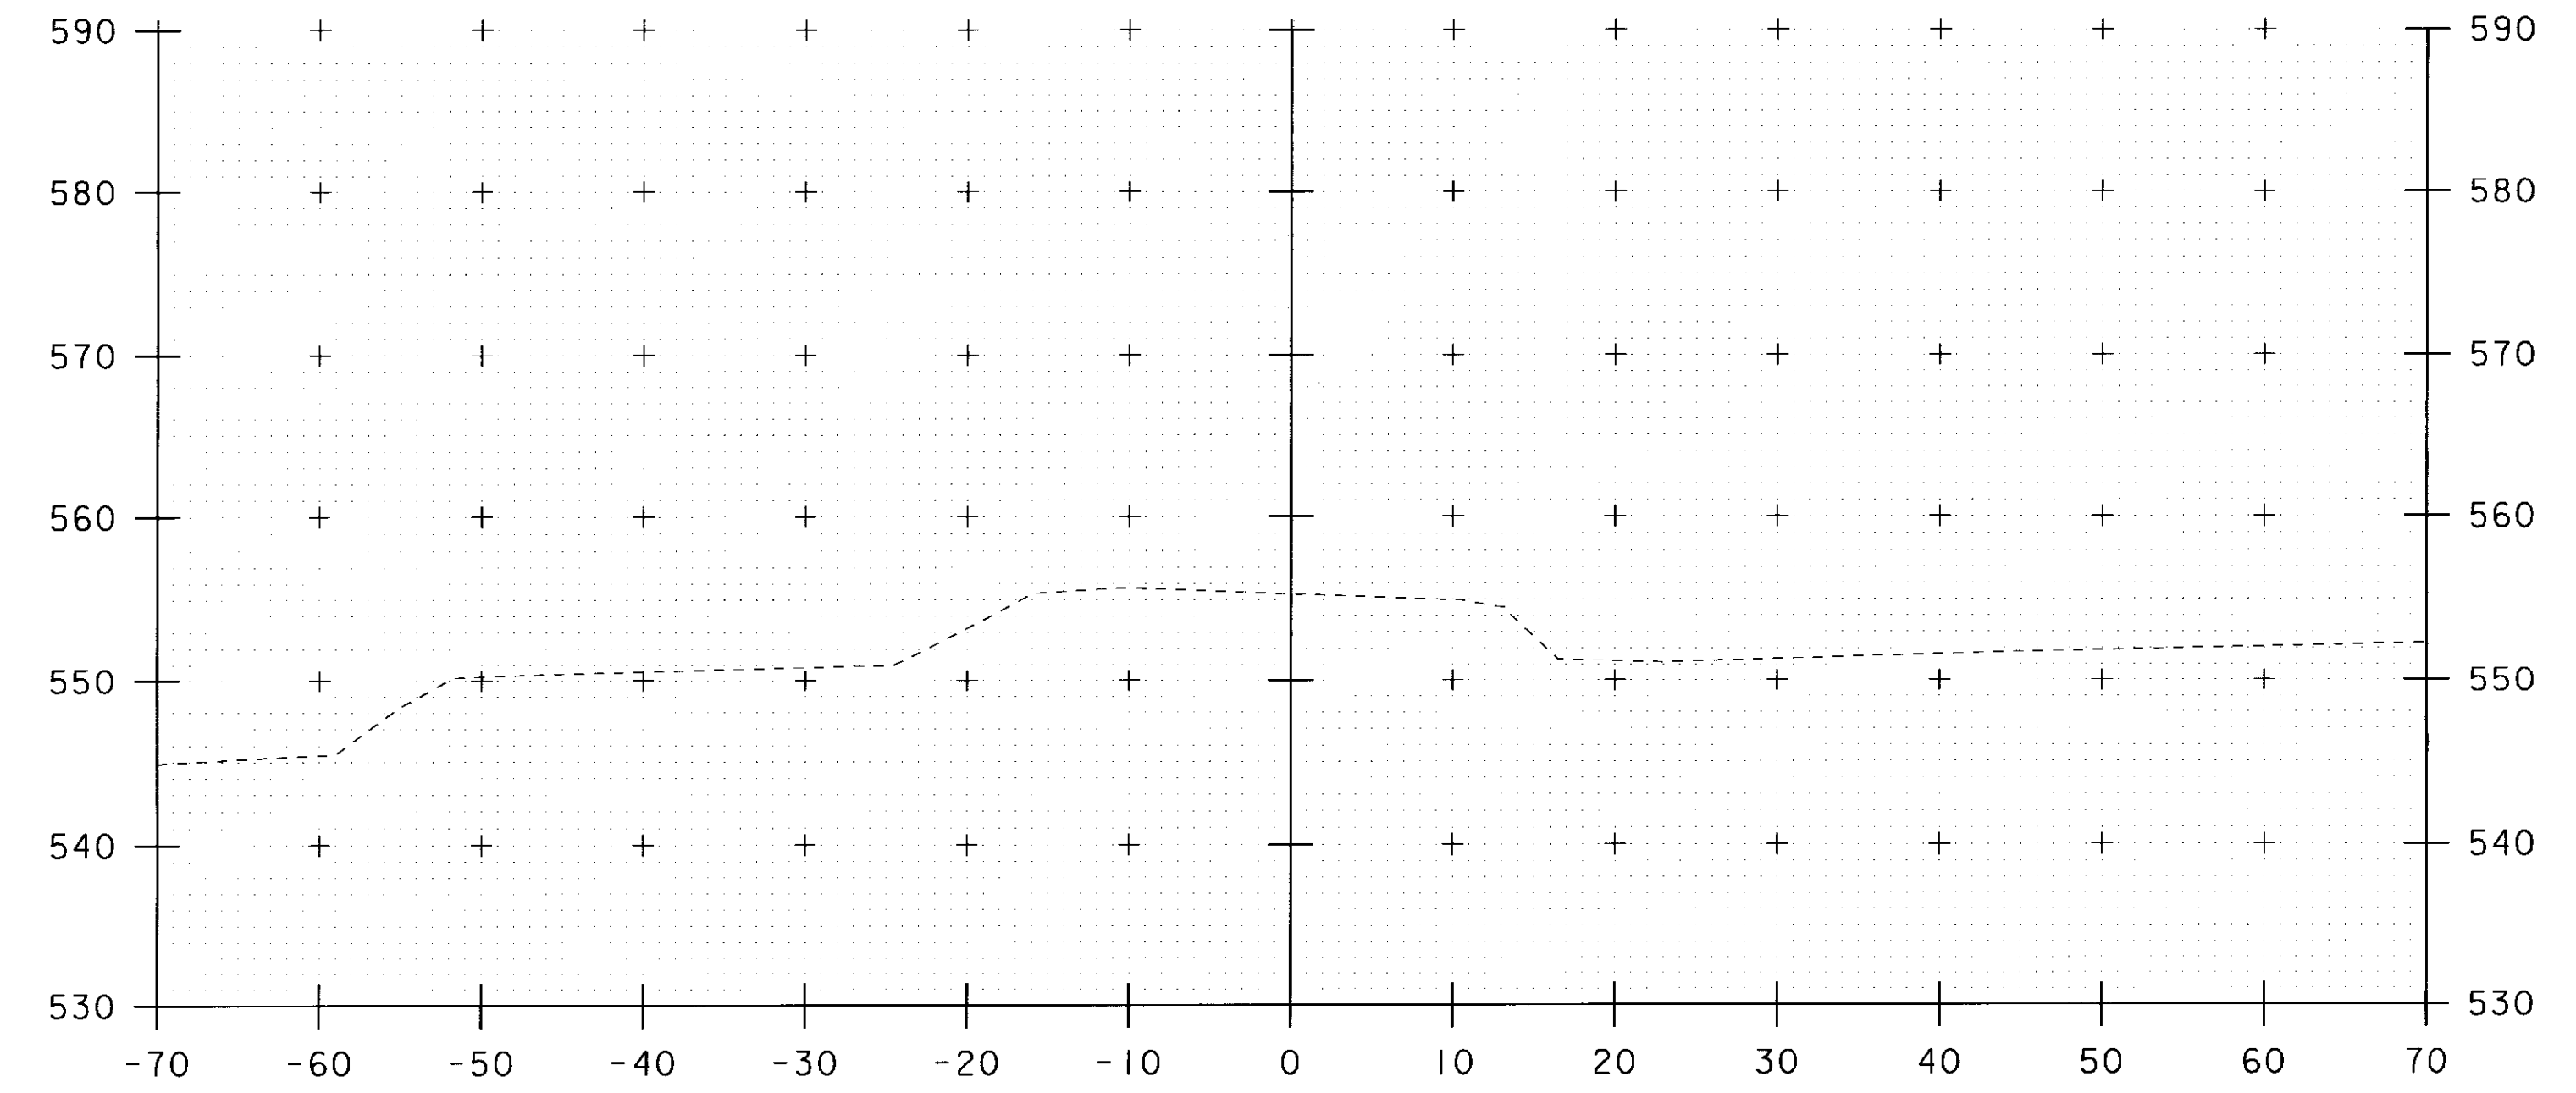

33+25

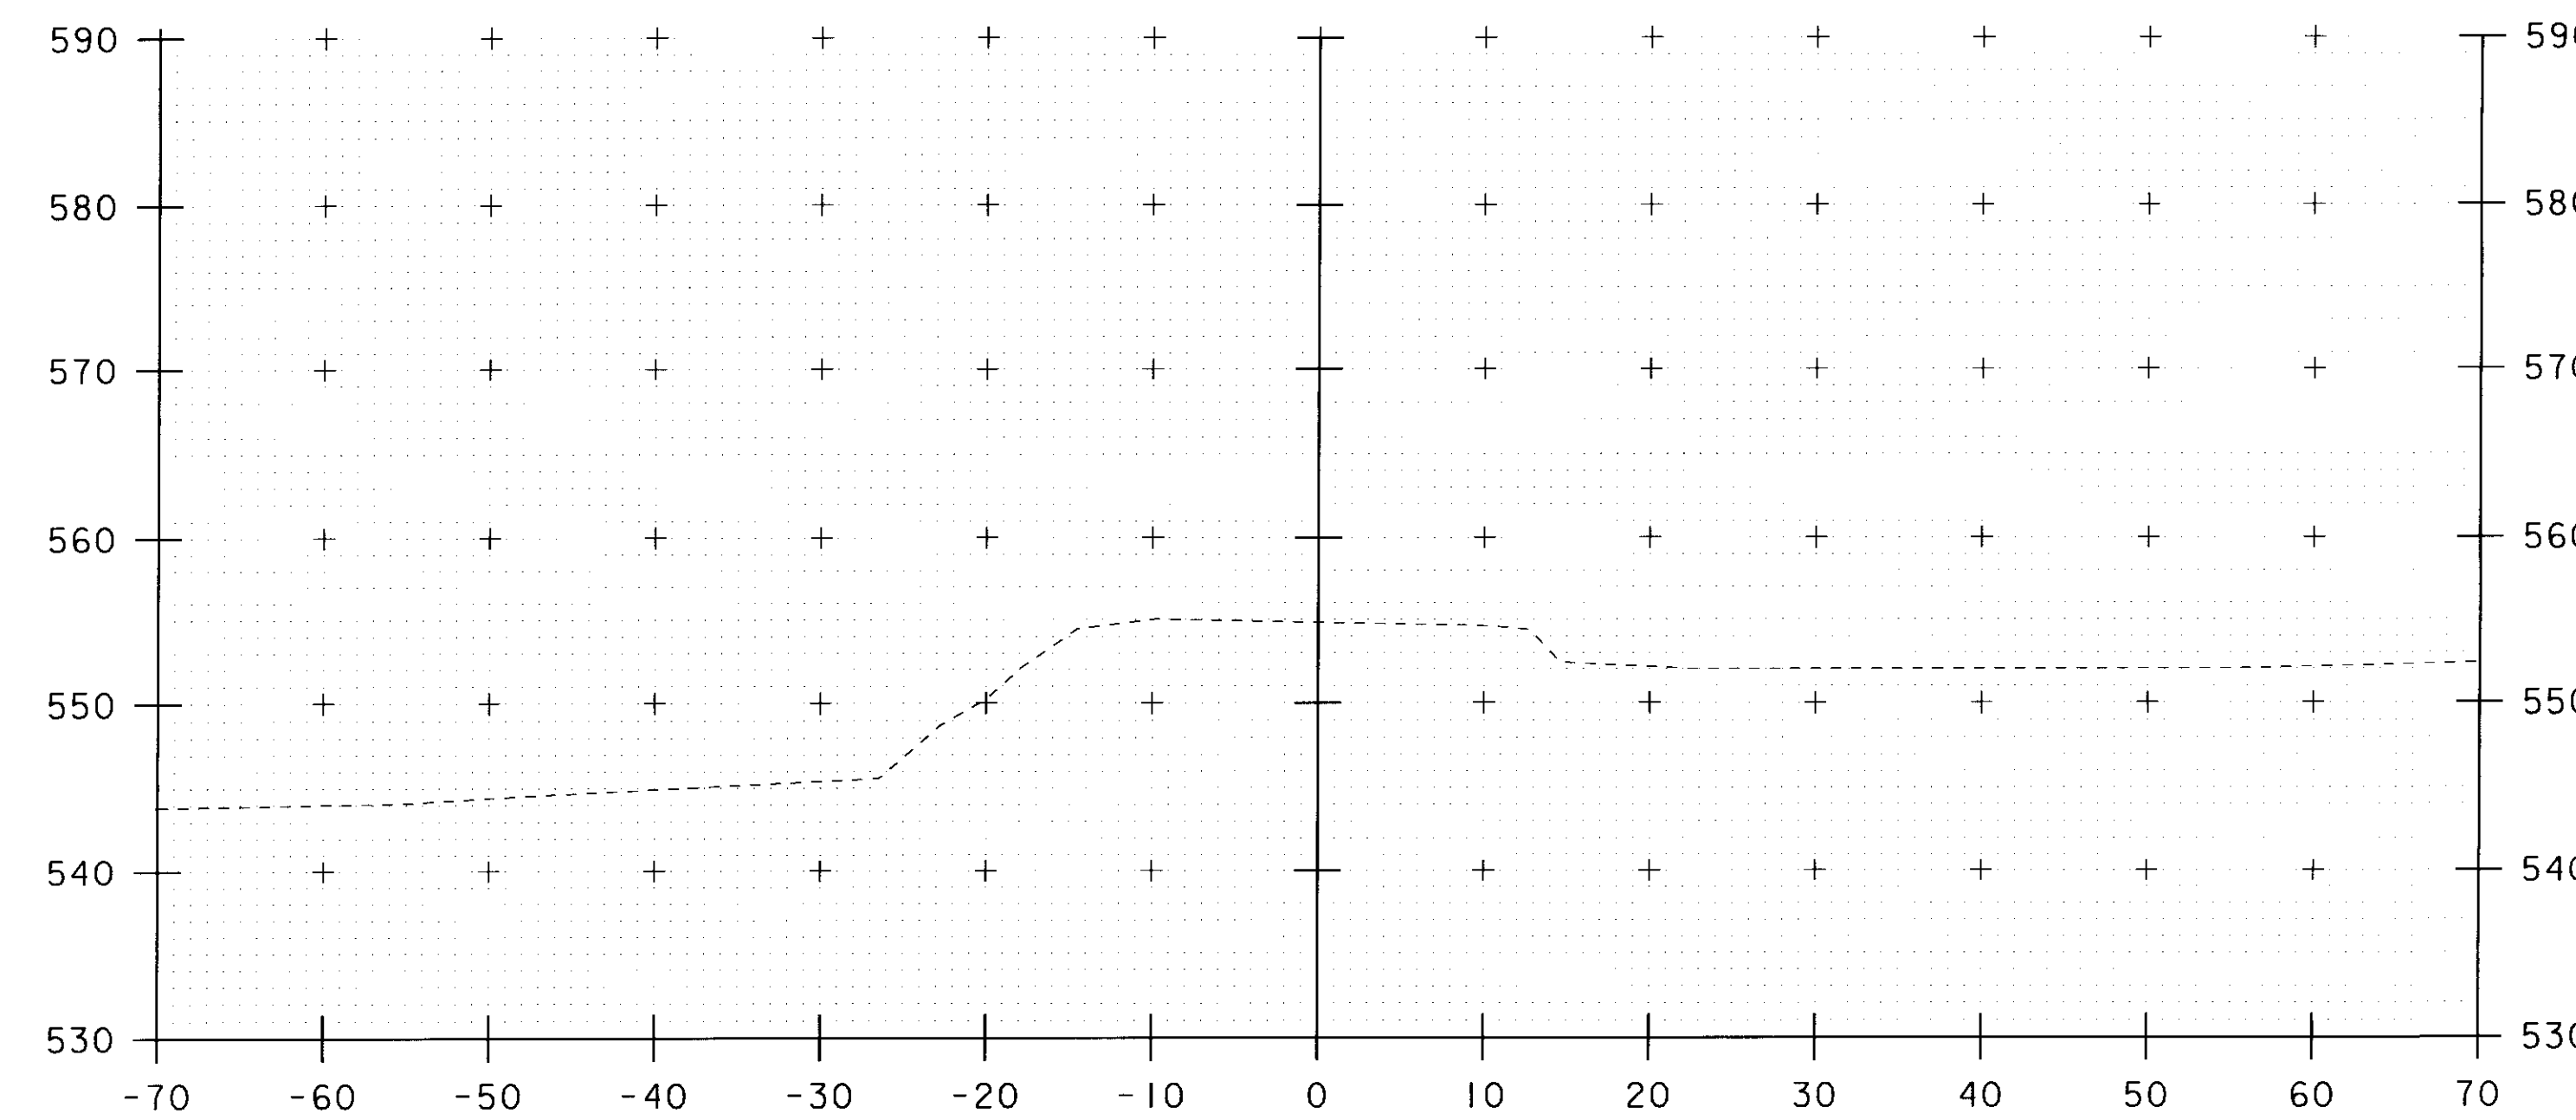


32+50

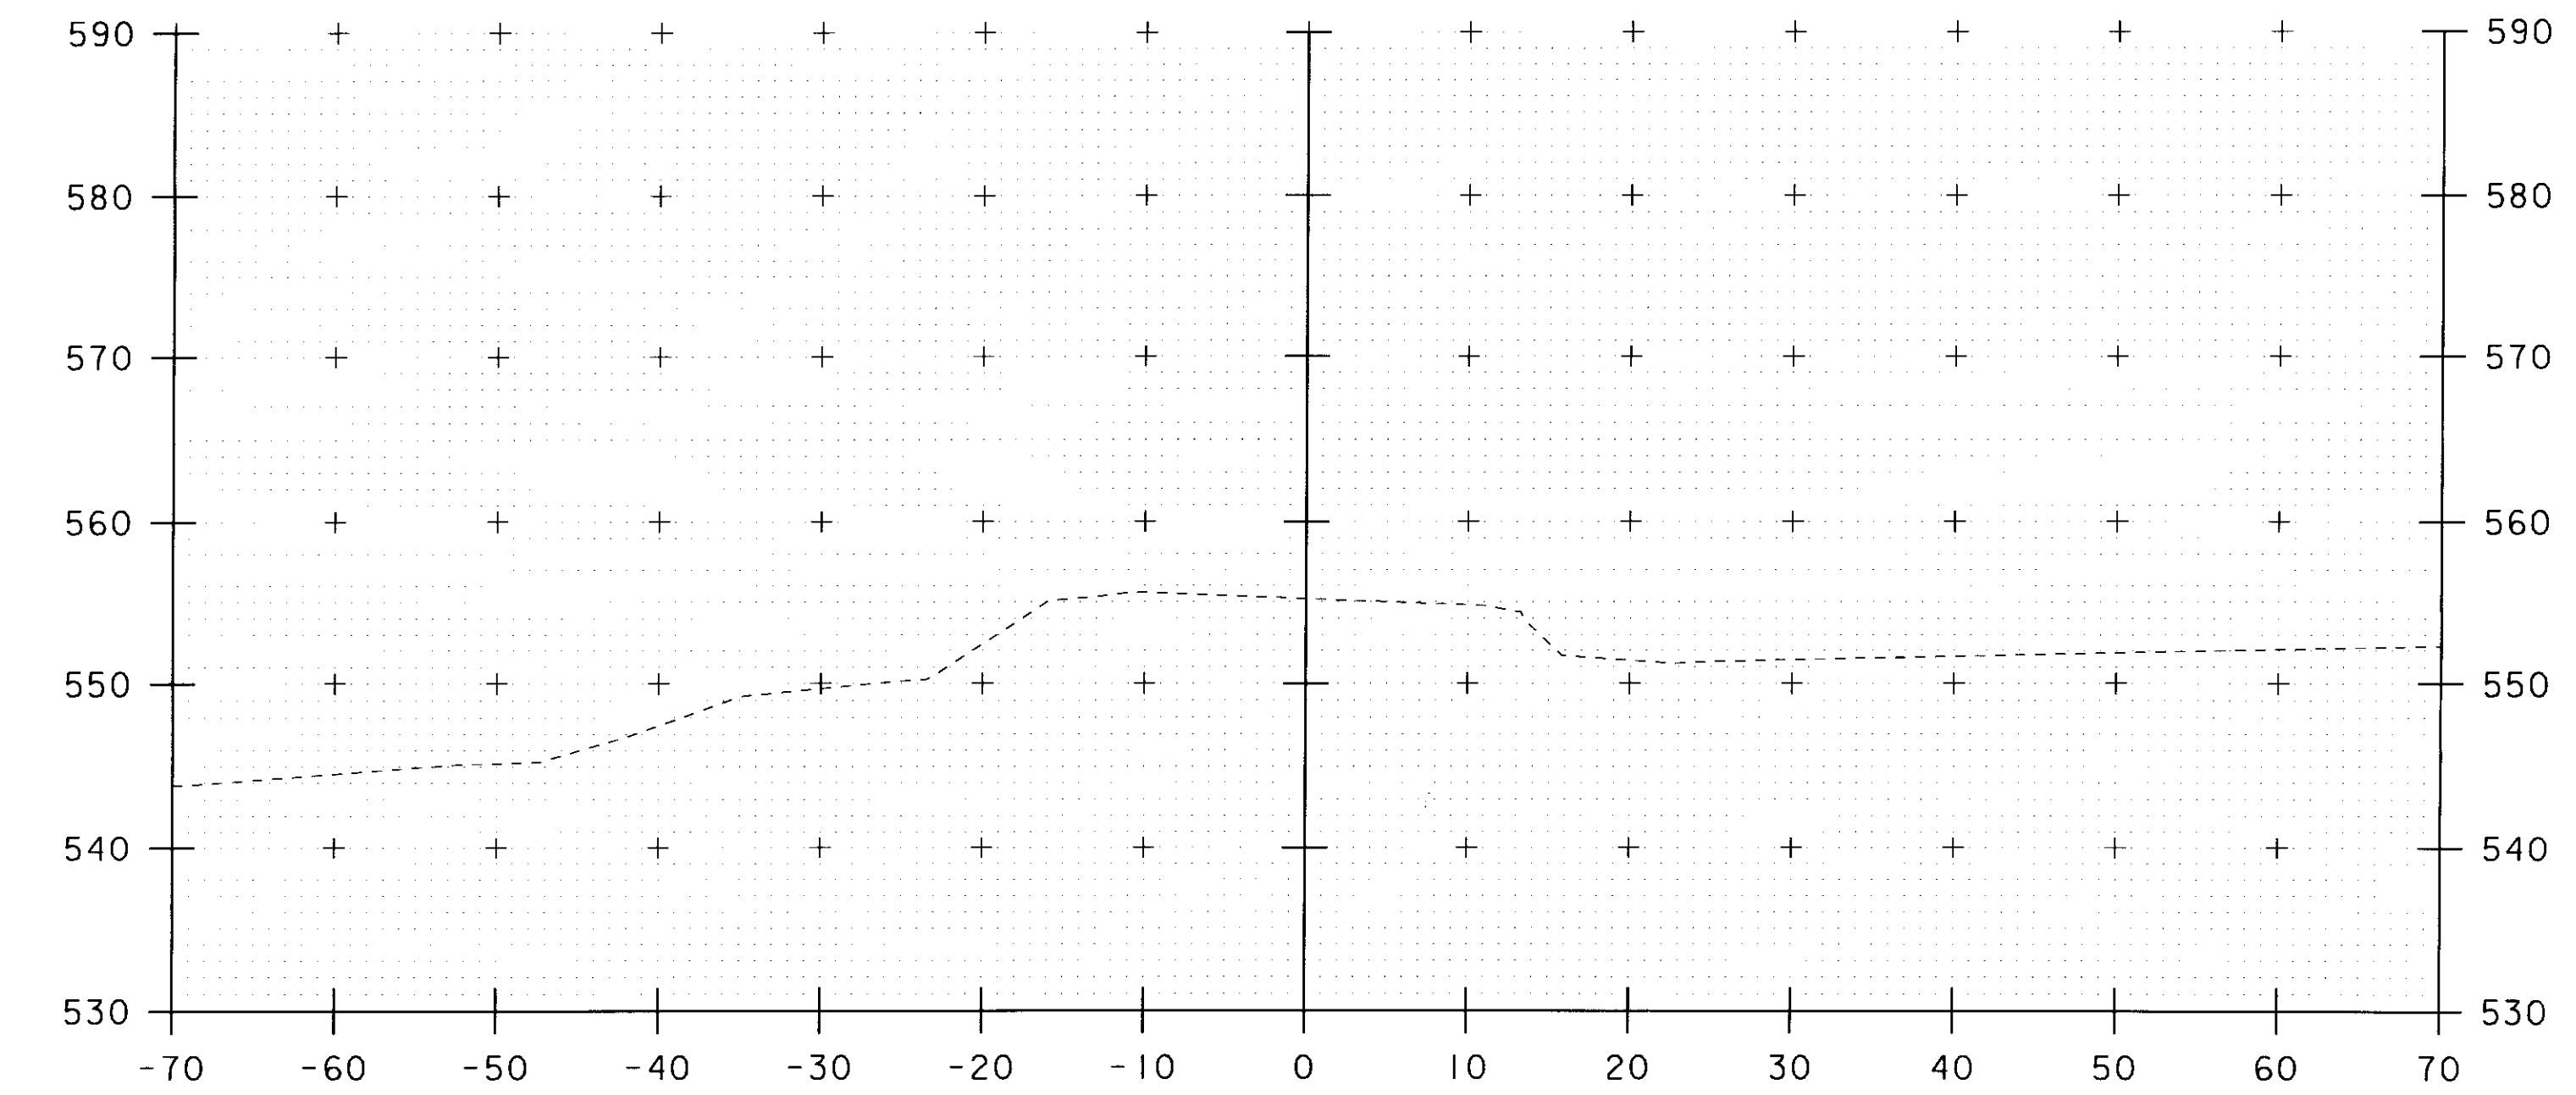

33+00

STA. 32+50 TO STA. 33+25

SCALE 1" = 10'-0"


PROJECT NAME: JAMAICA
 PROJECT NUMBER: BRO 1442(27)

FILE NAME: s96J068xsl.dgn
 PROJECT LEADER: K. HIGGINS
 DESIGNED BY: J. LACROIX
 ROADWAY CROSS SECTIONS #1

PLOT DATE: 23-SEP-2010
 DRAWN BY: R. PELLETT
 CHECKED BY: J. LACROIX
 SHEET 34 OF 45